


Section Summary and Index

(GRID BEARINGS AND DISTANCES)
(GRID FACTOR: 0.99989)





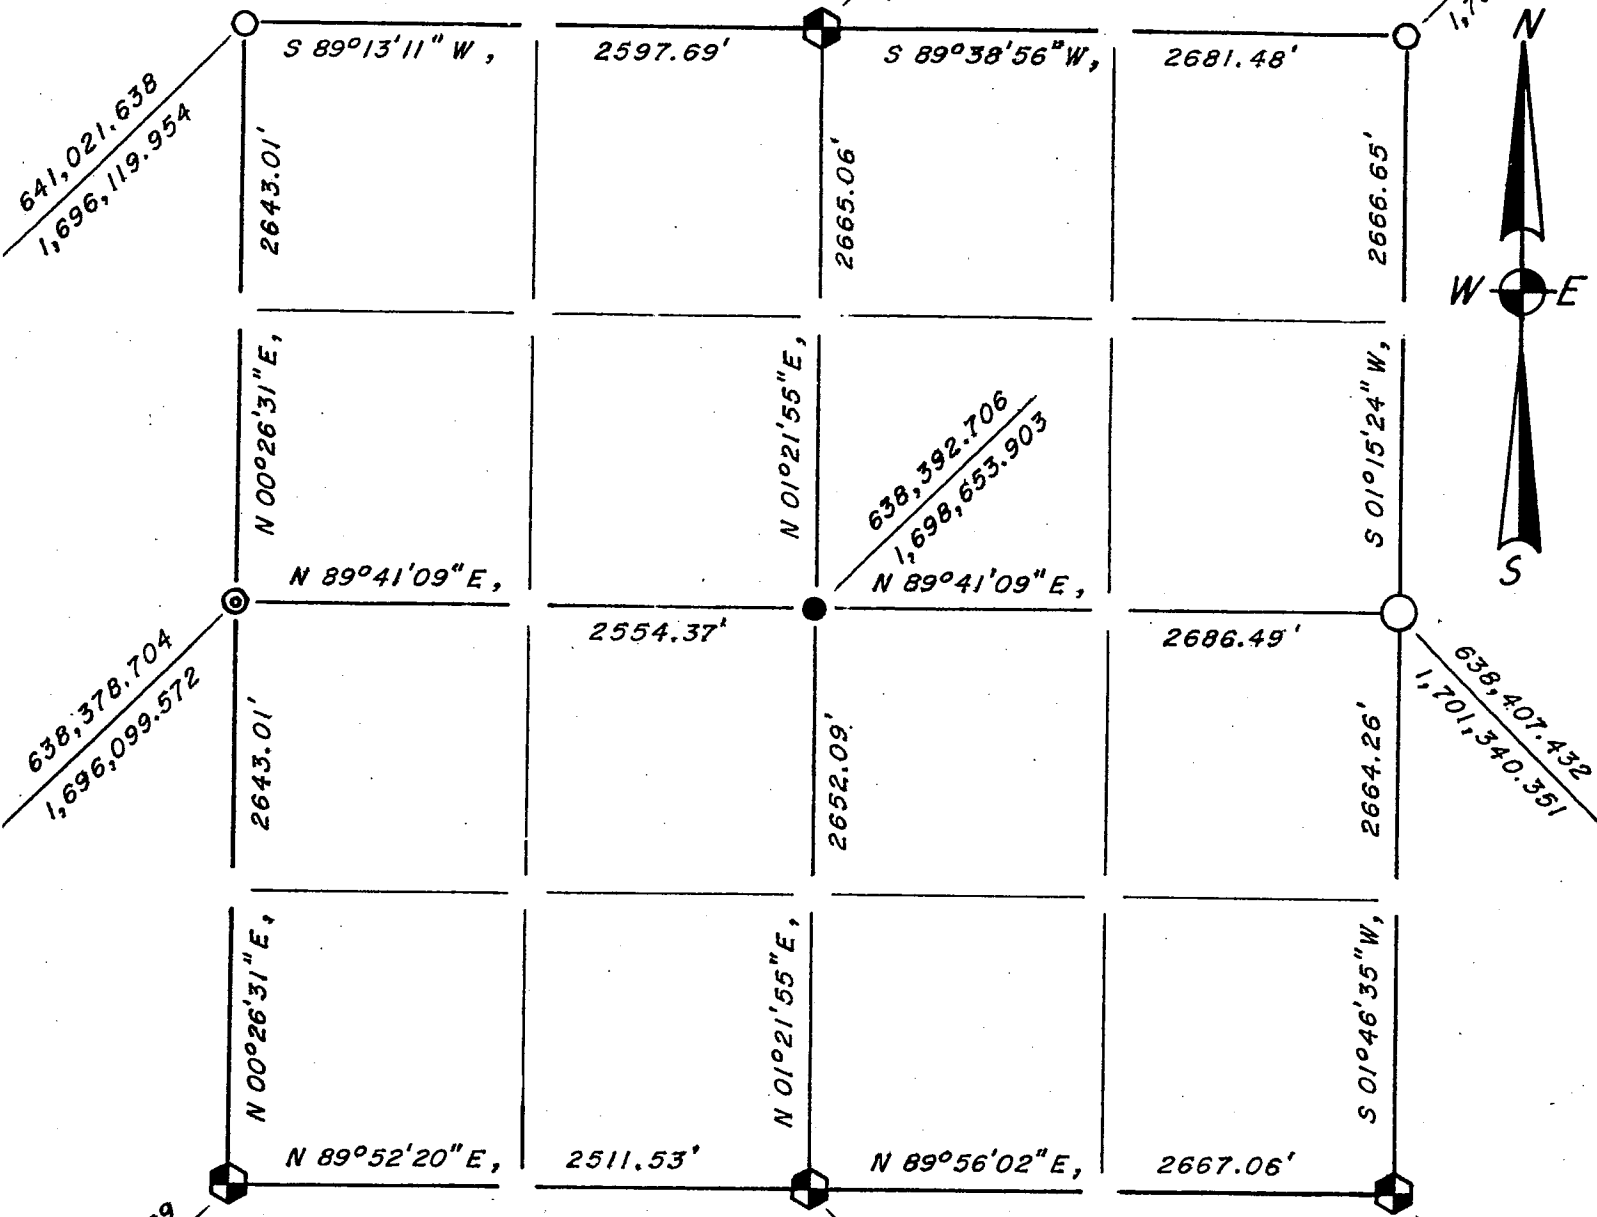

30 - 15 - 5
Section Town Range

TOWN OF WASHINGTON
LACROSSE COUNTY, WI.

641,057.013
1,698,717.402
641,073.445
1,701,398.831



LEGEND

-  - LUNDE monument.
-  - Stone or concrete monument.
-  - Other 1" IRON PIPE
-  - 2-1/4" IRON PIPE
-  - 3/4" IRON BAR
-  - 3/4" x 30" IRON BAR W/ RED PLASTIC CAP

(Not to Scale)



William C. Jung
Lacrosse County Surveyor
2/28/07