


Section Summary and Index

31 — 15 — 5  
Section — Town — Range  
Town of WASHINGTON

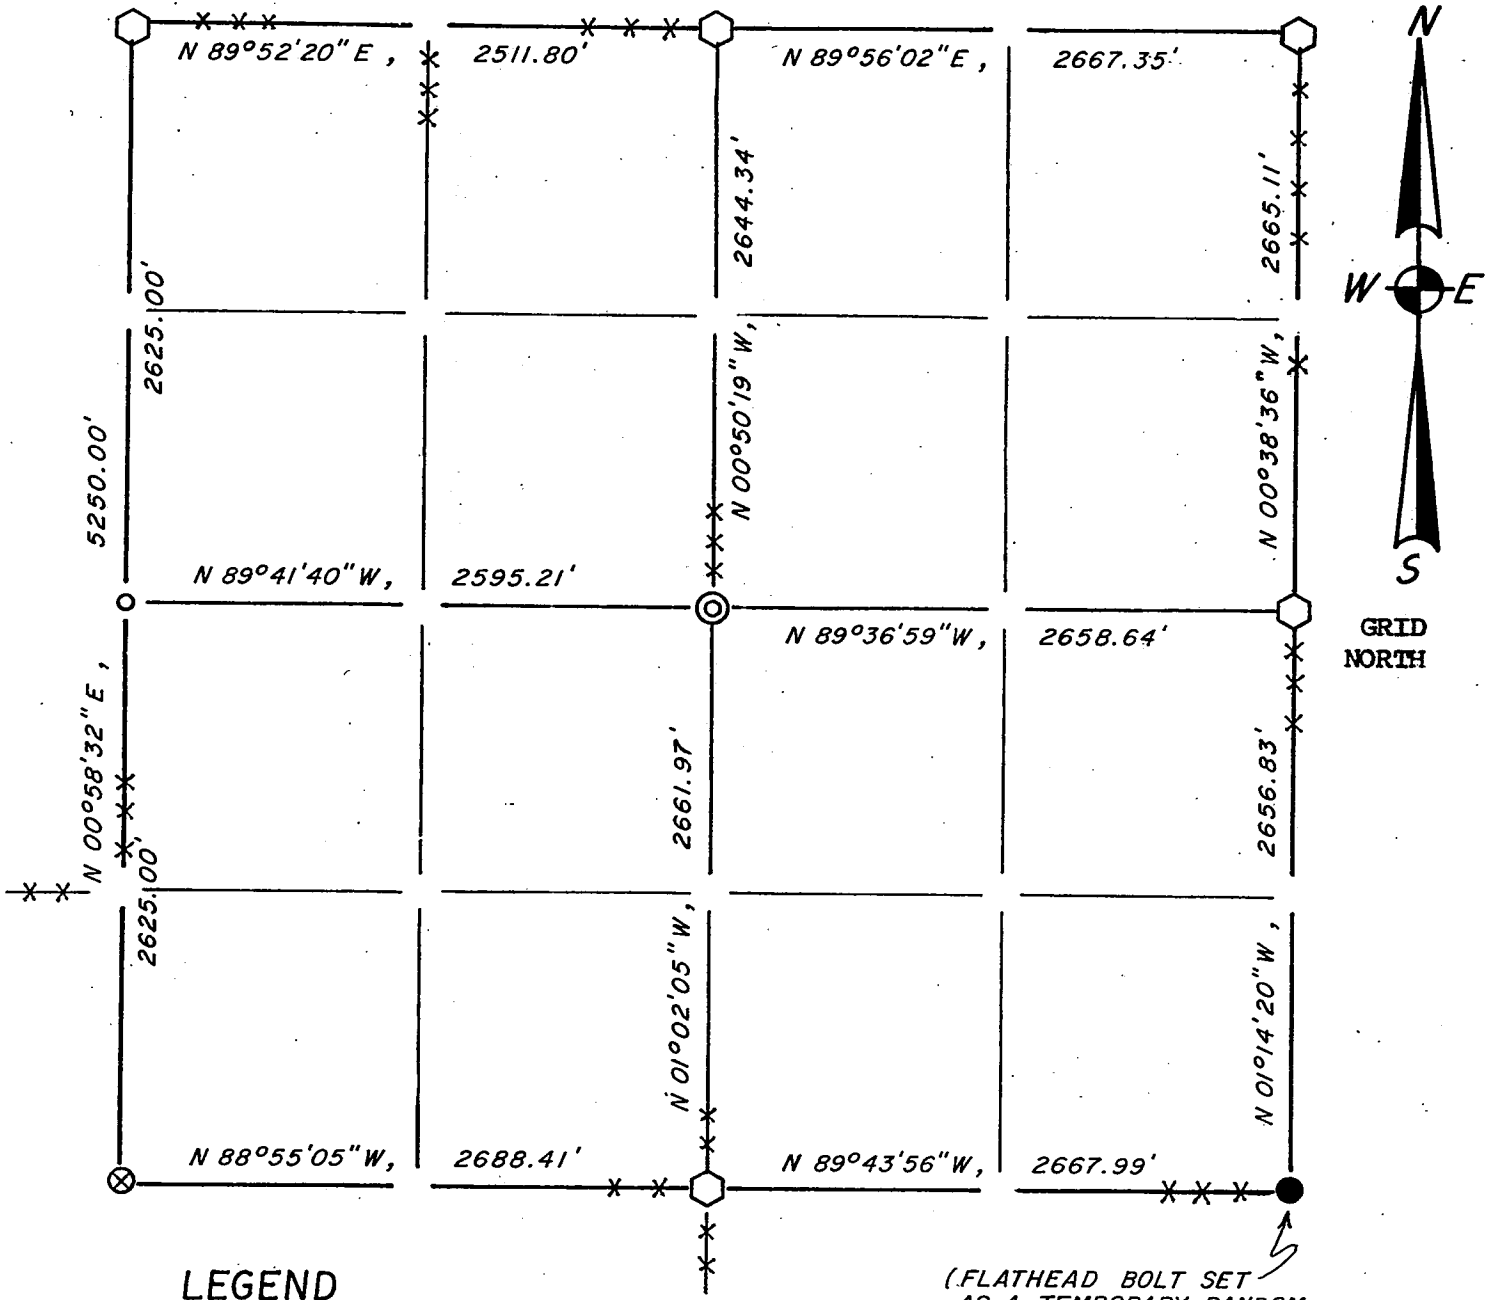

LEGEND

- ⊕ - monument.
- - Stone or concrete monument.
- ⊗ - Other Drill Hole in Rock
- ⬡ - Brass cap Lunde marker.
- ⊙ - 1" x 30" Iron Pipe in a 2 1/4" x 29" I.P.
- - 1" x 30" Iron Pipe
- - Flathead Bolt, under a pile of rocks

(FLATHEAD BOLT SET AS A TEMPORARY RANDOM CORNER ONLY.)

(NOT TO SCALE)



*William C. Jung*  
County Surveyor  
3/31/95