


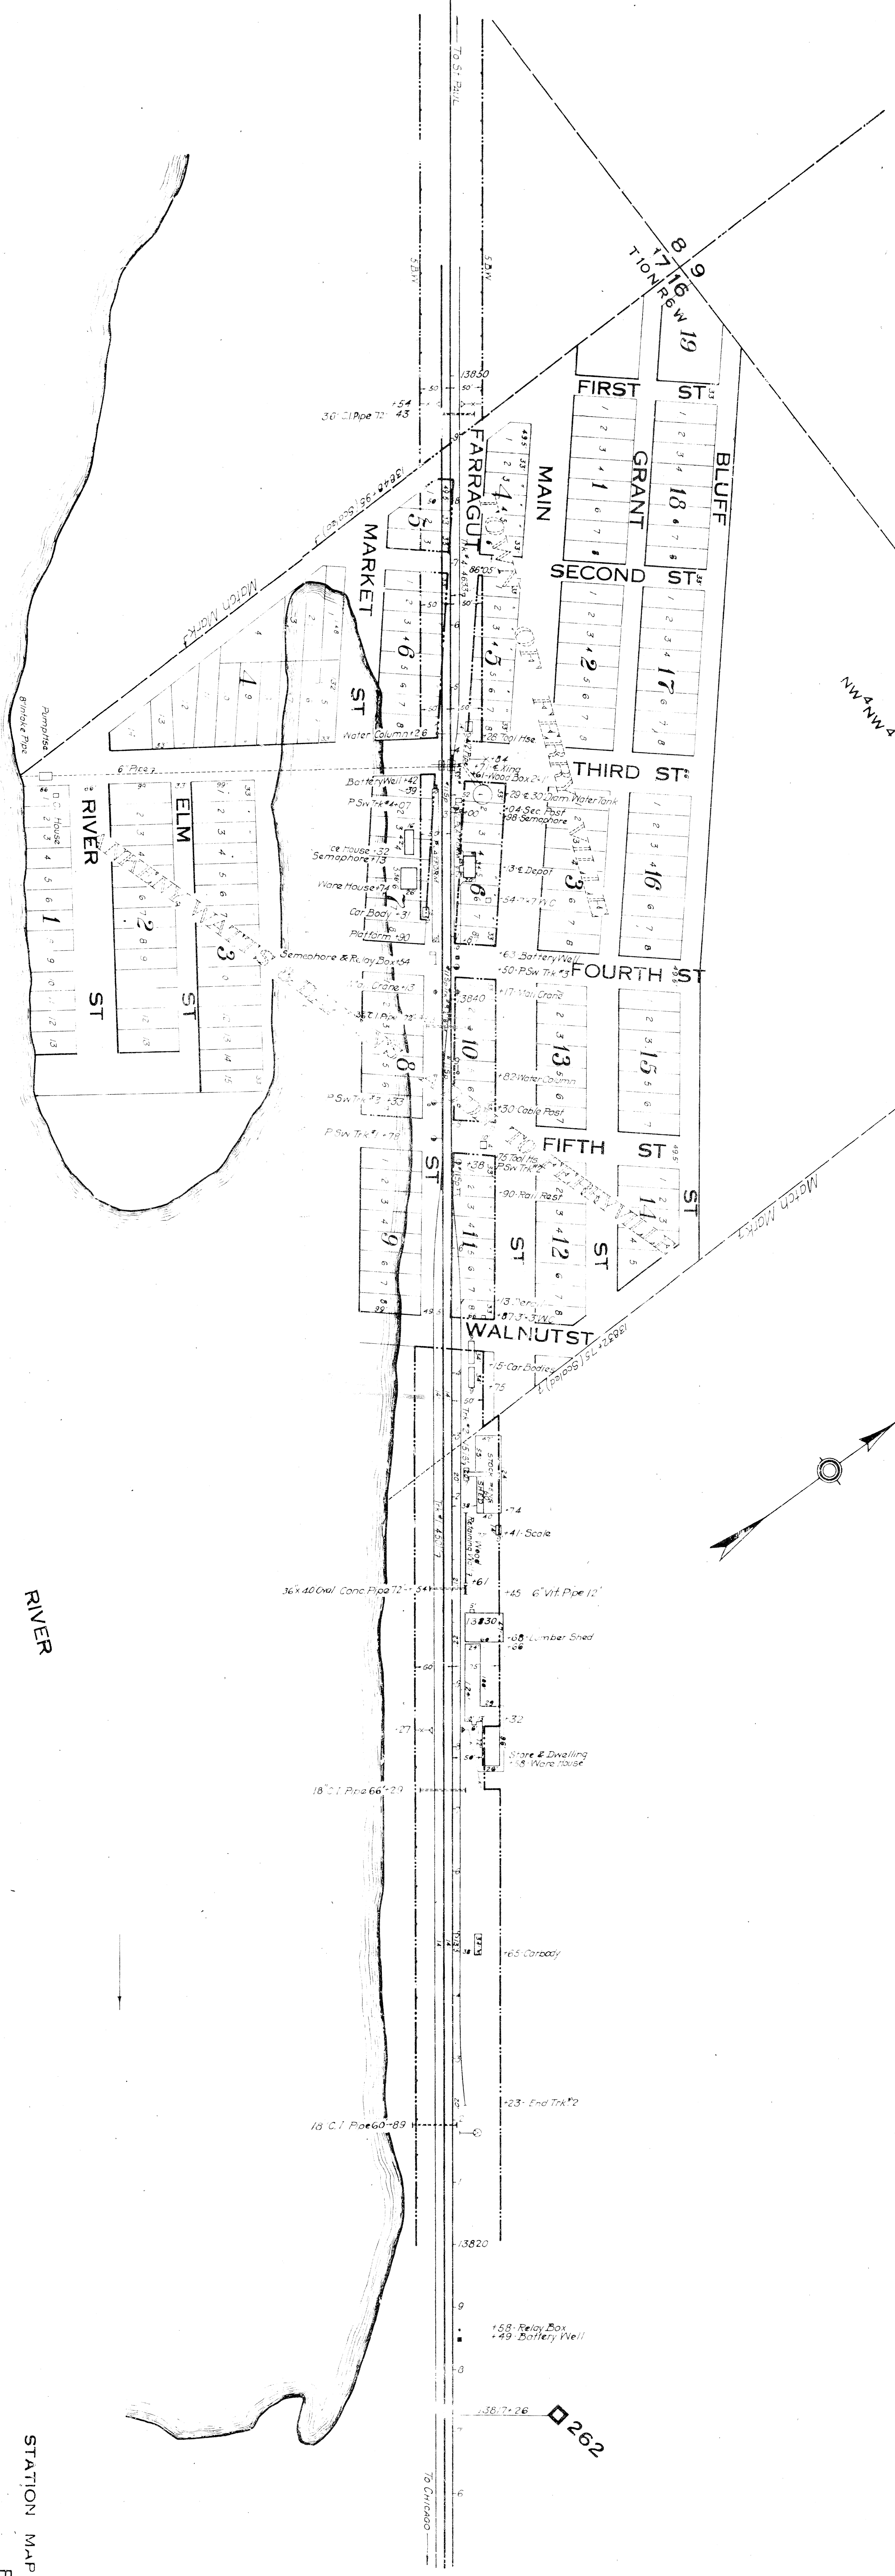

MISSISSIPPI

RIVER

STATION MAP TRACKS & STRUCTURES  
 CRAWFORD COUNTY  
 FERRYVILLE  
 CHICAGO, BURLINGTON & QUINCY R. R. CO.

CHICAGO, BURLINGTON & QUINCY R. R. CO.  
 CRAWFORD COUNTY  
 FERRYVILLE  
 STATION 13832+75  
 SCALE 1"=100' HORIZ.  
 SCALE 1"=20' VERT.  
 JUNE 30, 1917  
 OFFICE OF VALUATION ENGINEER CHICAGO, ILLINOIS

