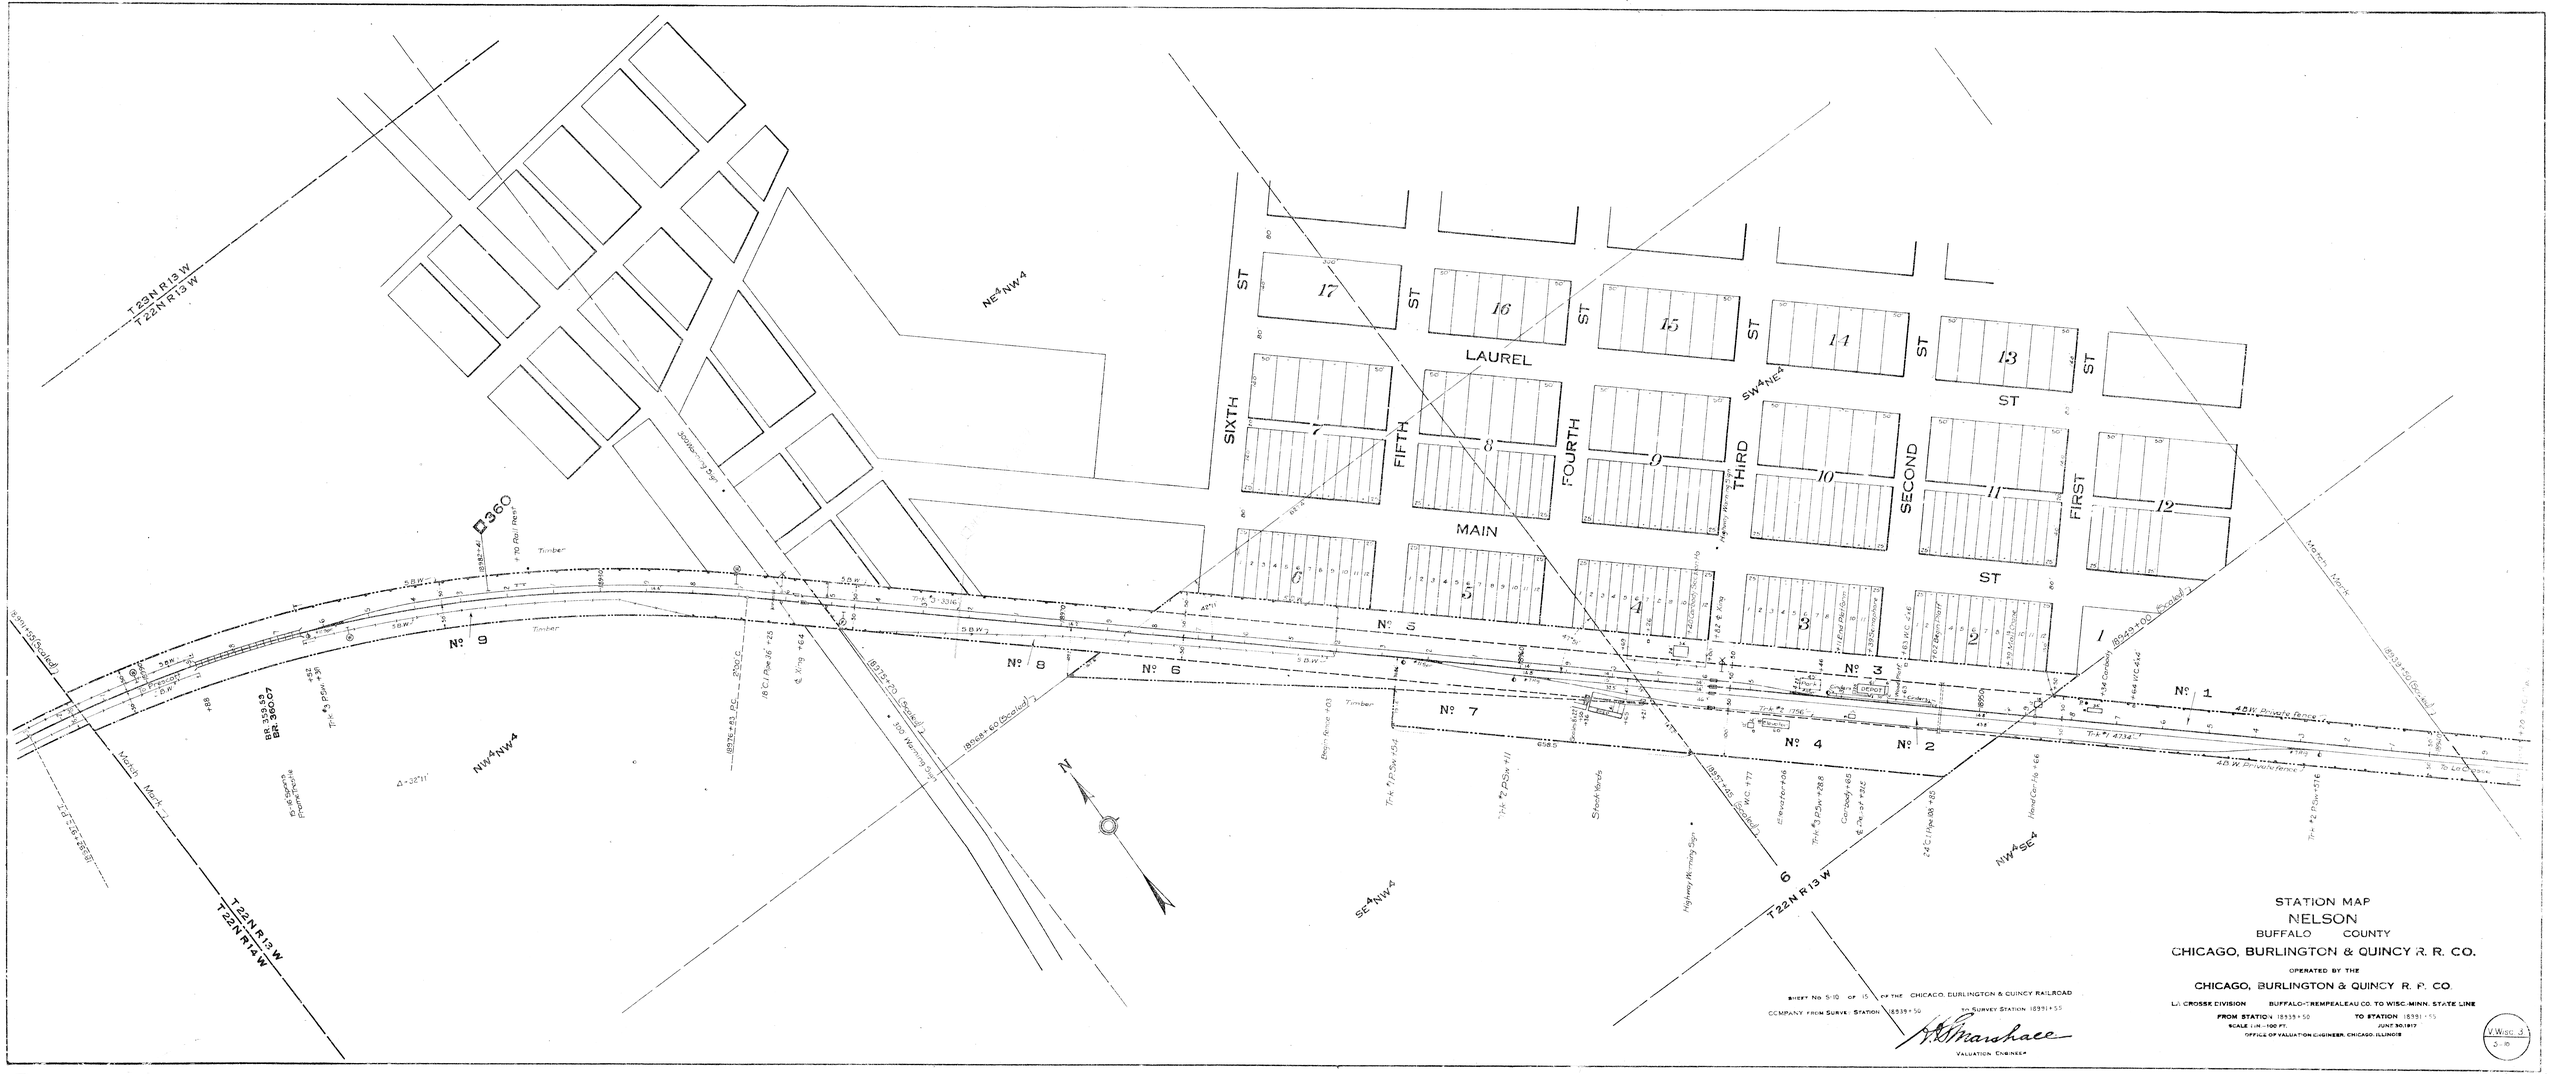
T 23N R 13 W
T 22N R 13 W
NE¼NW¼
SW¼NE¼
NW¼NW¼
SE¼NW¼
NW¼SE¼
T 22N R 13 W
T 22N R 14 W
T 22N R 13 W
LAUREL
MAIN
SIXTH ST
FIFTH ST
FOURTH ST
THIRD ST
SECOND ST
FIRST ST
17
16
15
14
13
12
11
10
9
8
7
6
5
4
3
2
1
E360
Nº 9
Nº 8
Nº 6
Nº 5
Nº 7
Nº 4
Nº 3
Nº 2
Nº 1
DEPOT
N
STATION MAP
NELSON
BUFFALO COUNTY
CHICAGO, BURLINGTON & QUINCY R. R. CO.
OPERATED BY THE
CHICAGO, BURLINGTON & QUINCY R. R. CO.
LA CROSSE DIVISION BUFFALO-TREMPEALEAU CO. TO WISC.-MINN. STATE LINE
SCALE 1 IN. = 100 FT. JUNE 30, 1917
OFFICE OF VALUATION ENGINEER, CHICAGO, ILLINOIS
W. M. Marshall
VALUATION ENGINEER
