


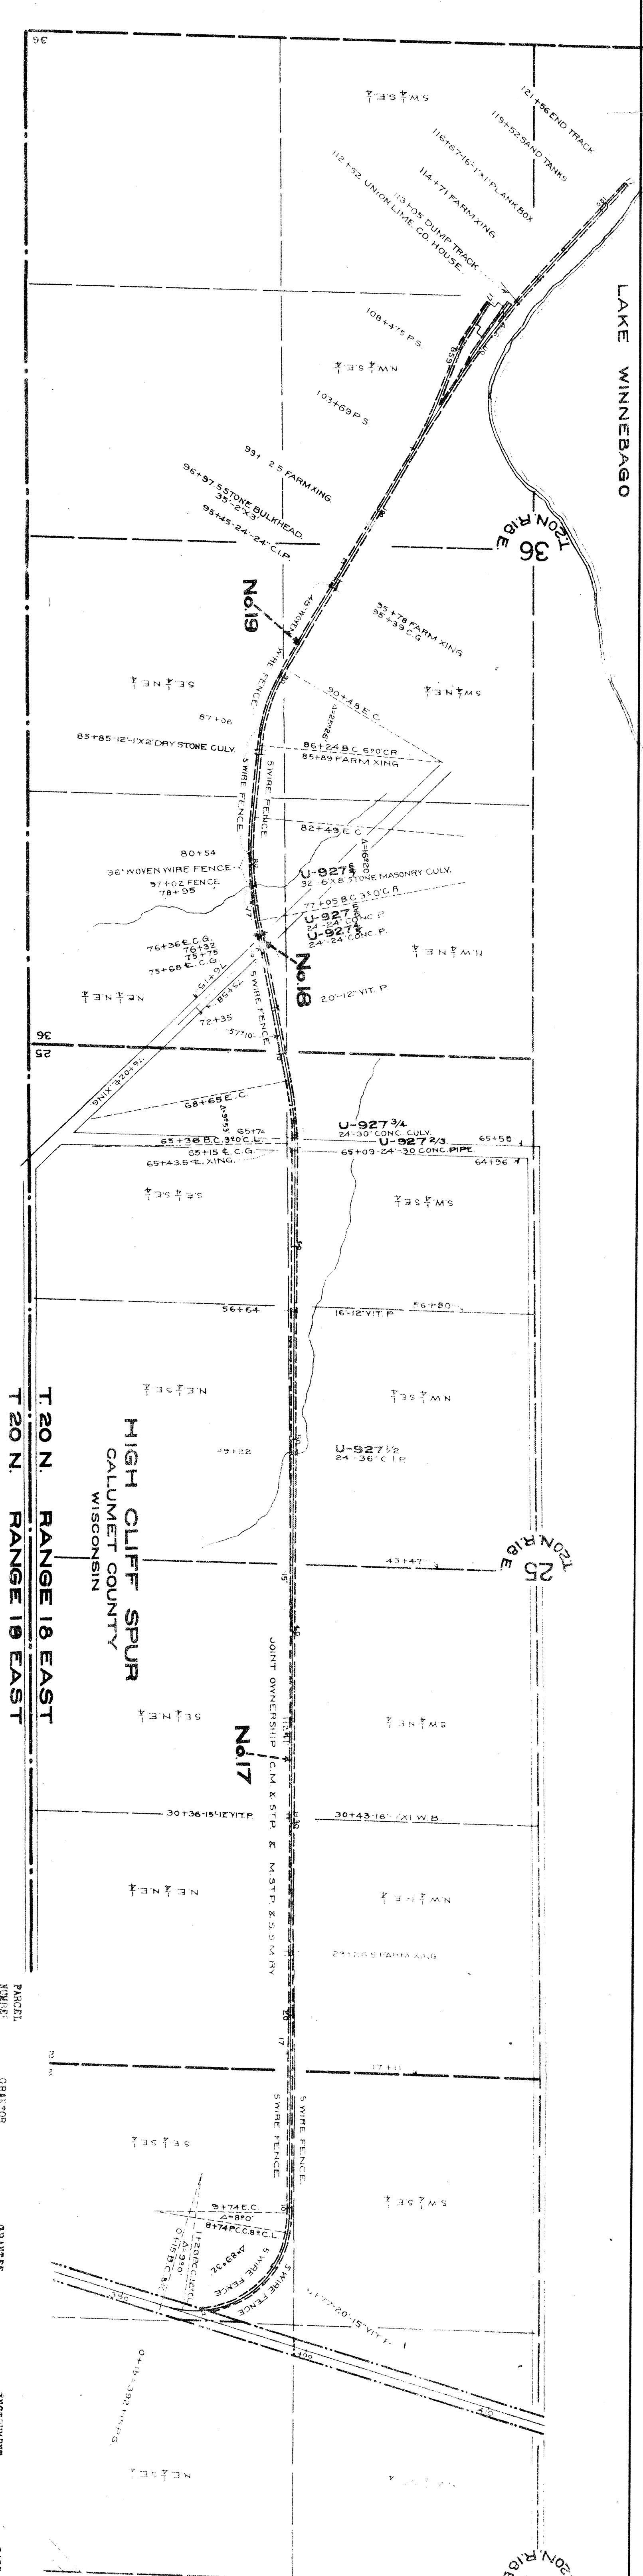


**HIGH CLIFF SPUR
CALUMET COUNTY
WISCONSIN**

T20 N. RANGE 18 EAST
T20 N. RANGE 19 EAST

**SHERWOOD
CALUMET COUNTY
WISCONSIN**

 

CHICAGO, MILWAUKEE & ST. PAUL RY. CO.

RIGHT OF WAY AND TRACK MAP
OPERATED BY THE
CHICAGO, MILWAUKEE & ST. PAUL RY. CO.
SUPERIOR DIVISION
STATION 211+83.5 TO STATION 423+03.5
OFFICE OF VALUATION ENGINEER
CHICAGO, ILLINOIS