
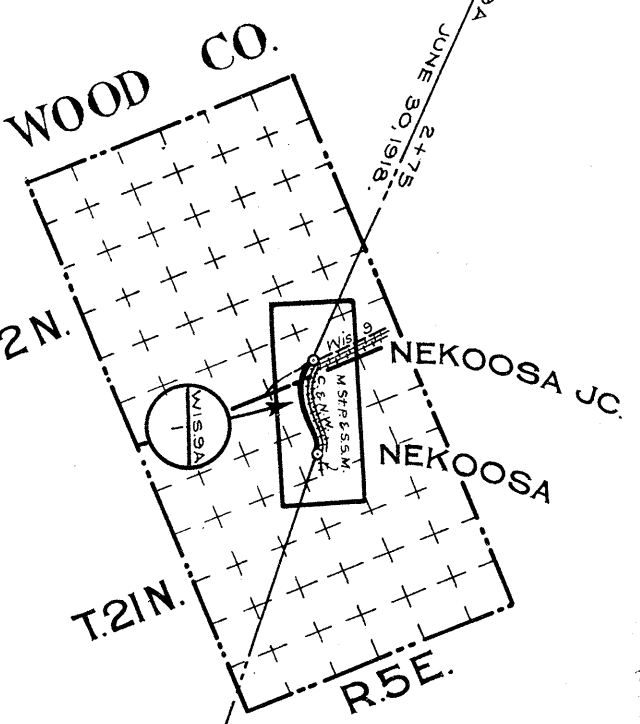


NEKOOSA JCT.
WOOD COUNTY
WISCONSIN.

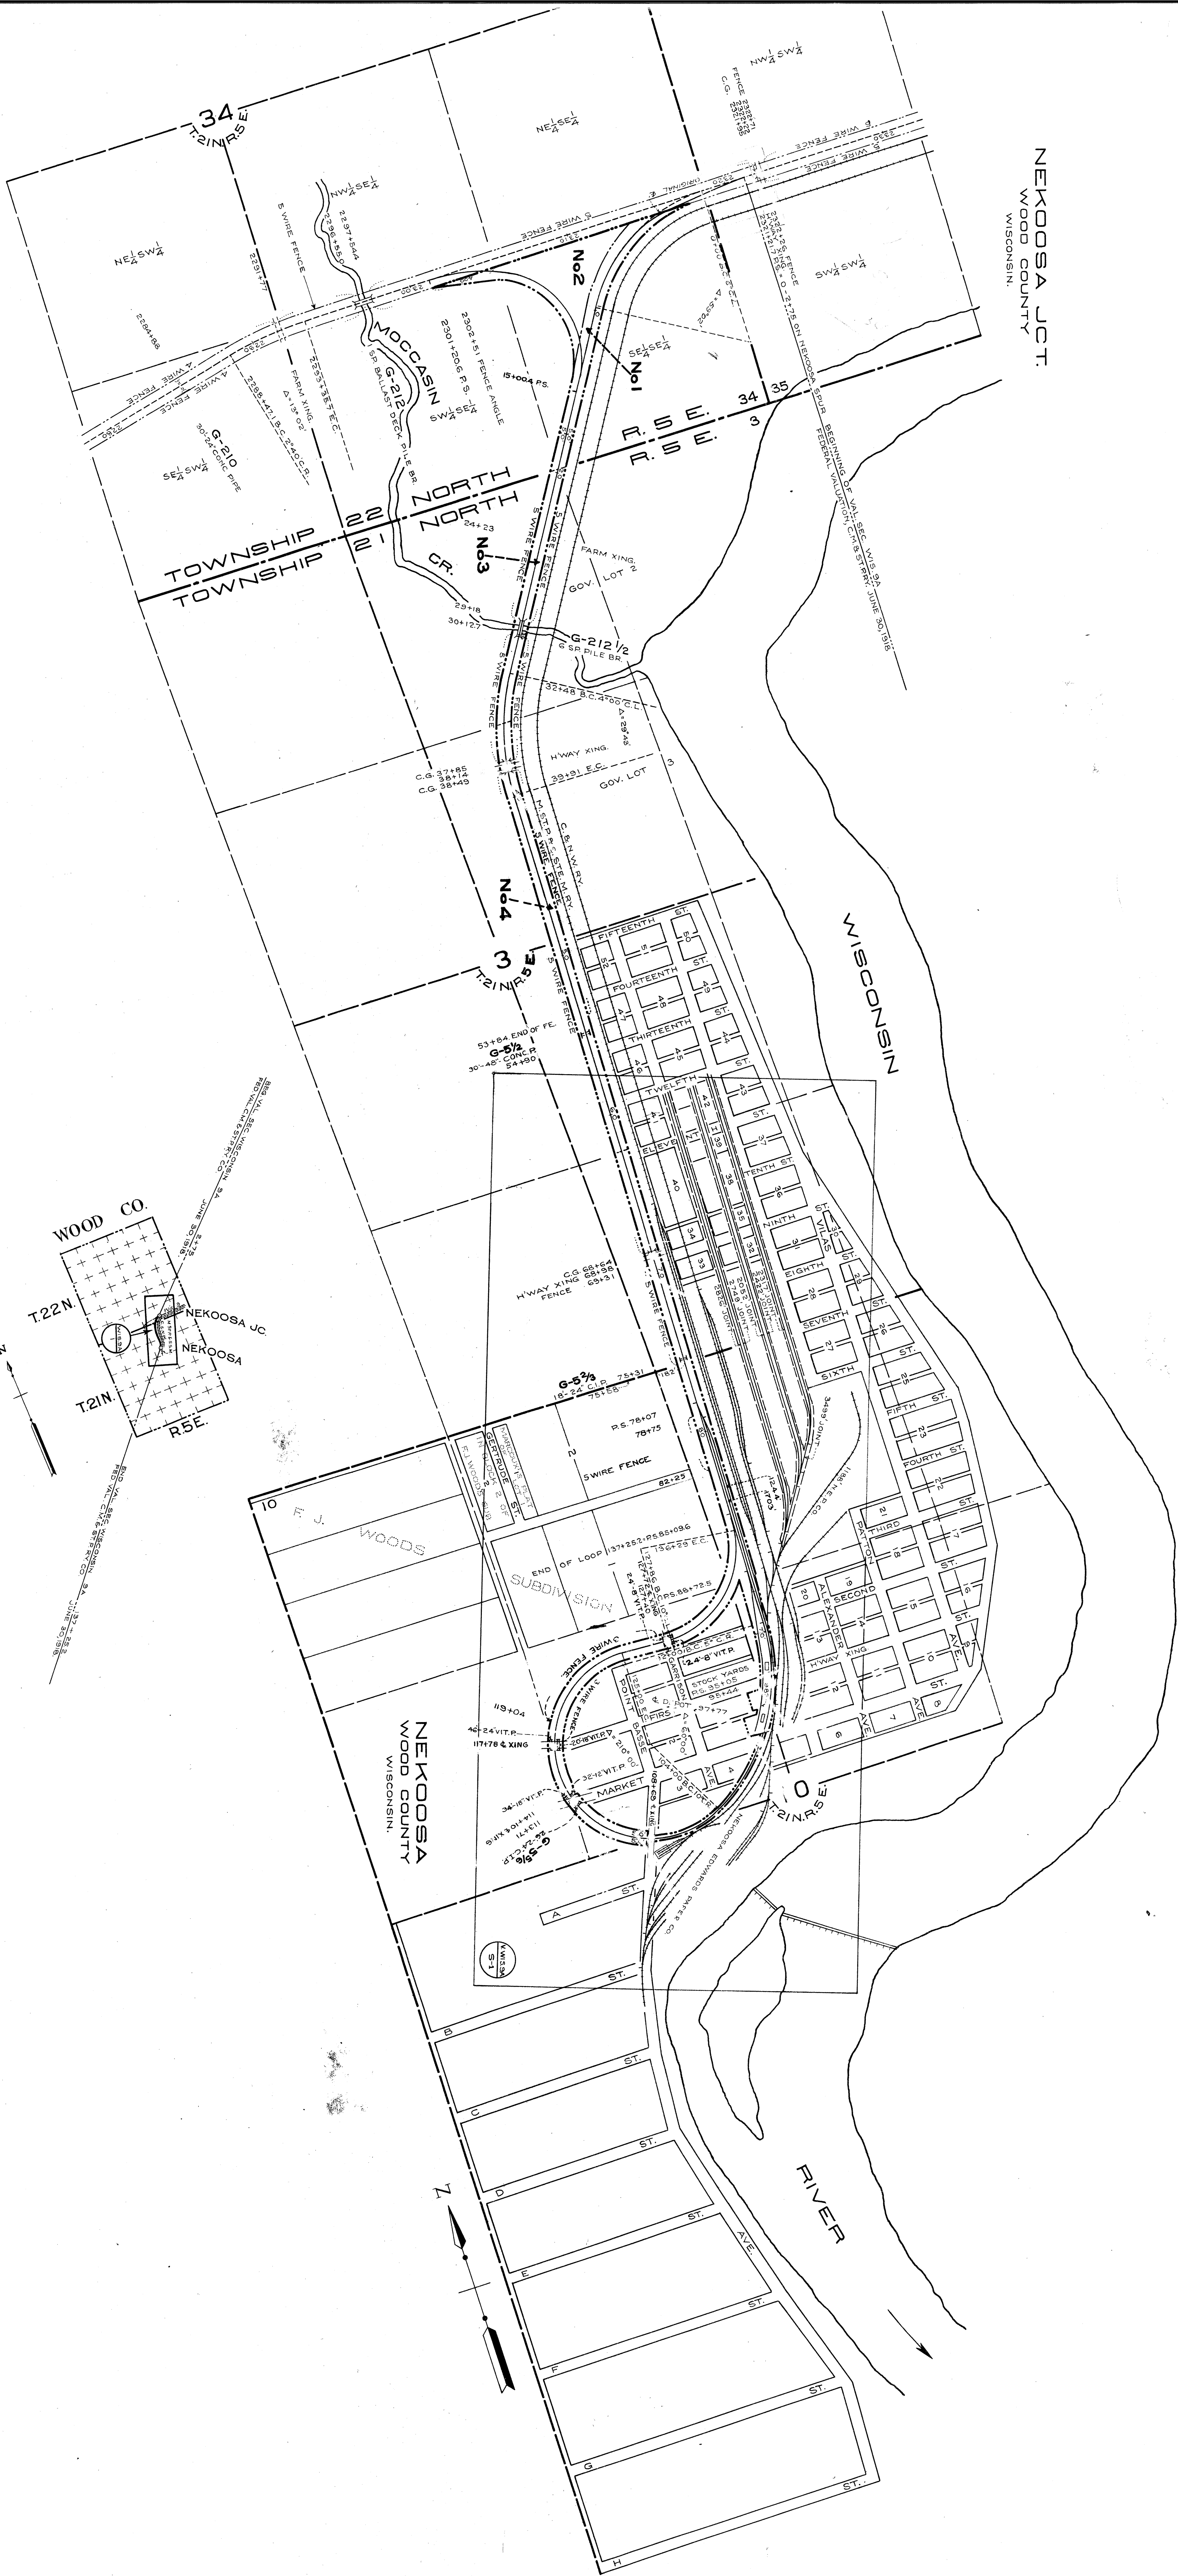

INDEX MAP
VALUATION SECTION WISCONSIN 9A
Scale 1 inch = 4 miles