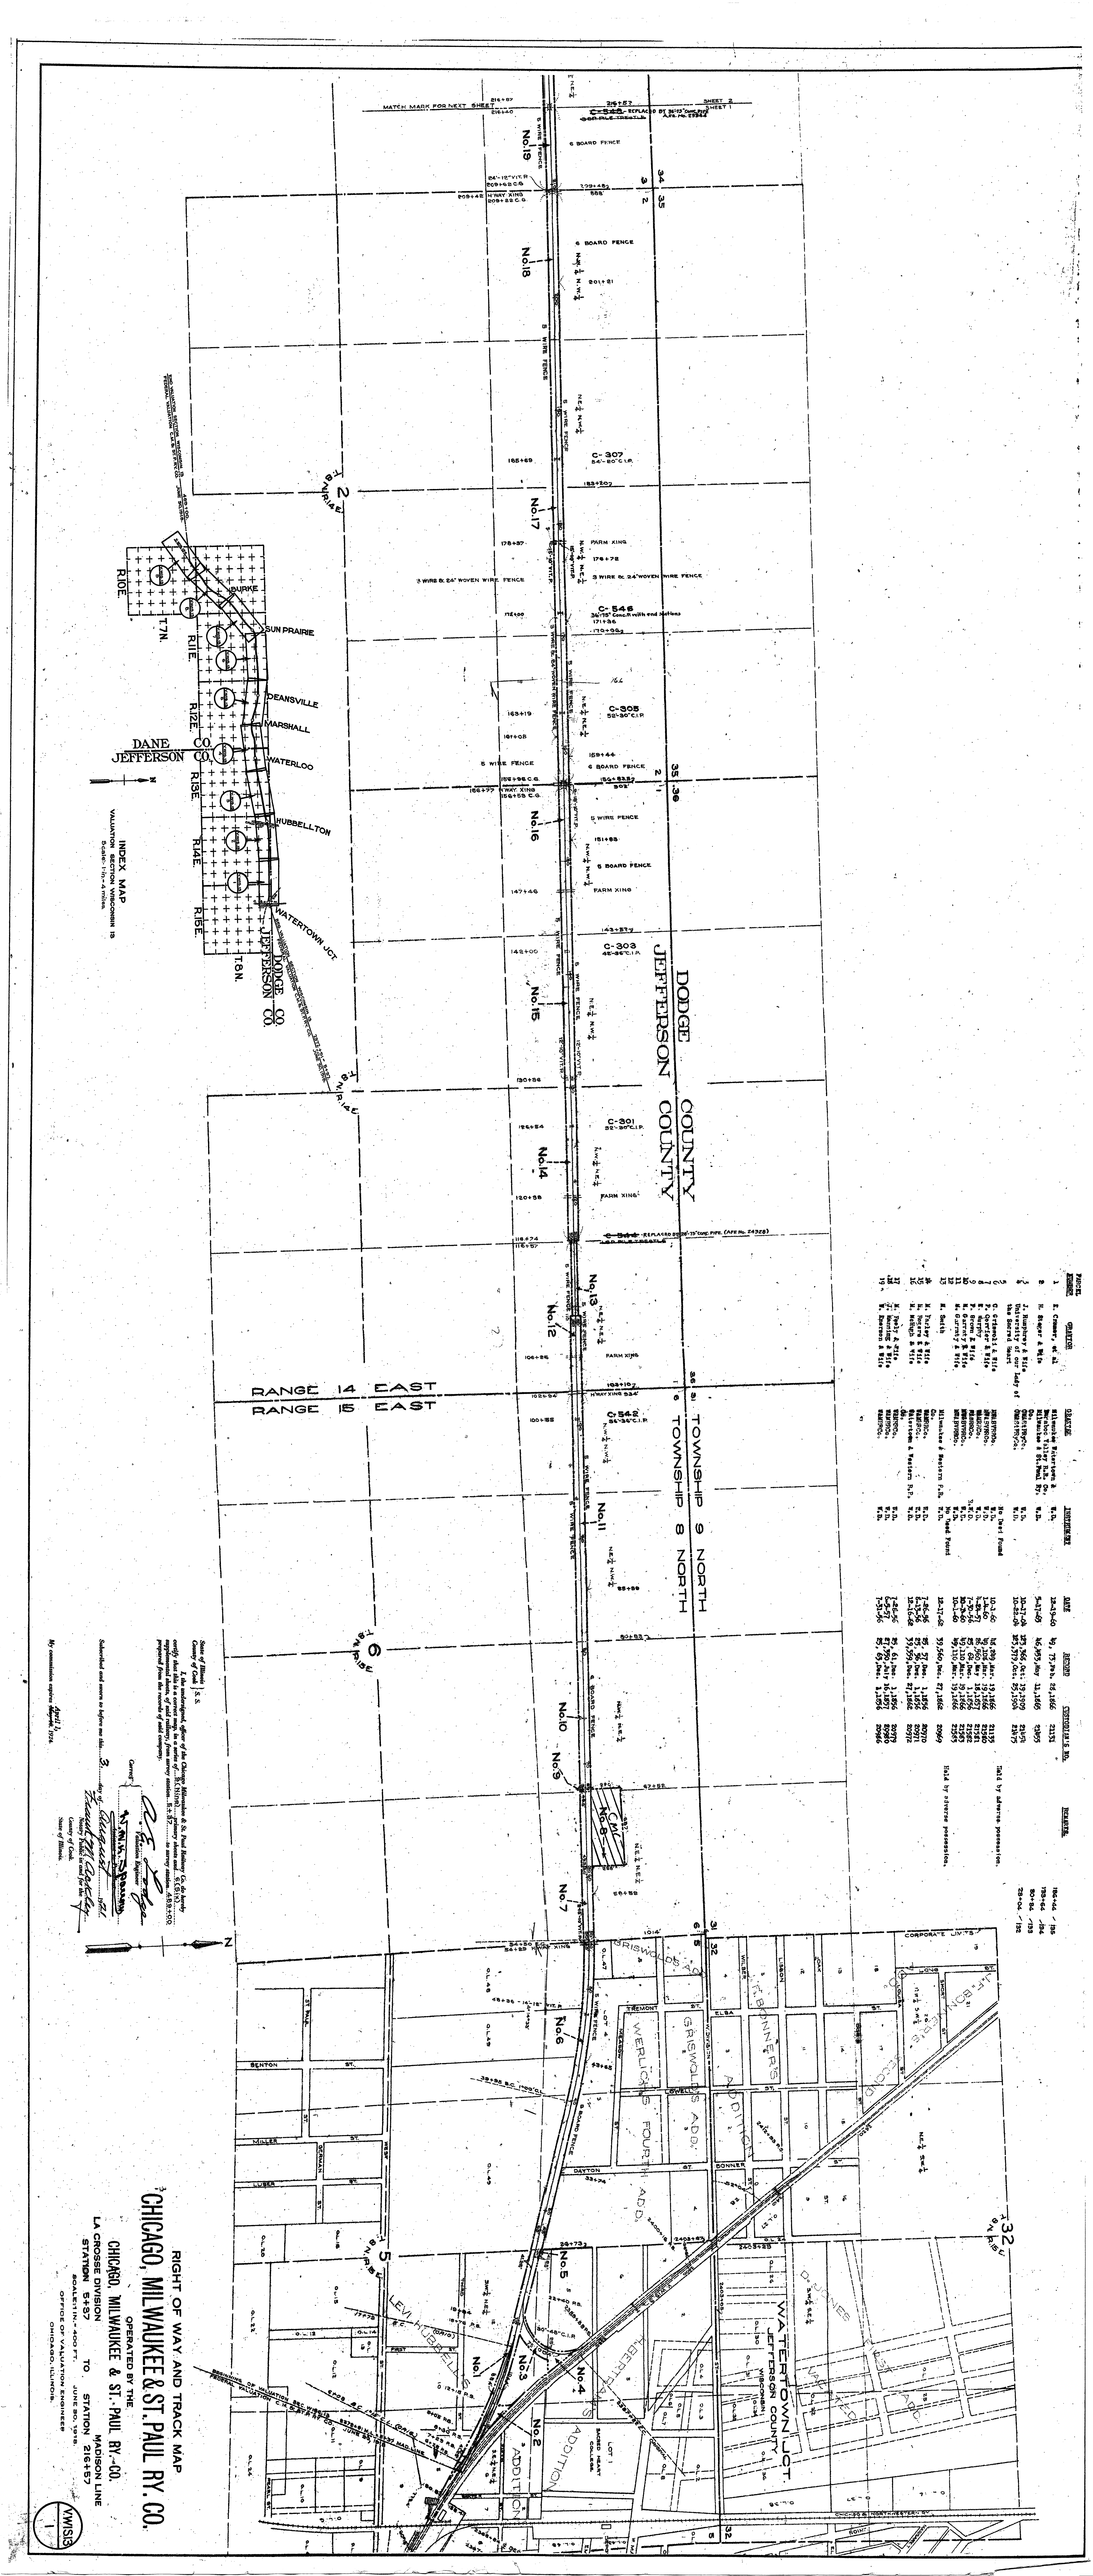
RIGHT OF WAY AND TRACK MAP
CHICAGO, MILWAUKEE & ST. PAUL RY. CO.
OPERATED BY THE
CHICAGO, MILWAUKEE & ST. PAUL RY. CO.
LA CROSSE DIVISION
MADISON LINE
SCALE (1"=400 FT.)
JUNE 30, 1918
OFFICE OF VALUATION ENGINEER
CHICAGO, ILLINOIS
DODGE COUNTY
JEFFERSON COUNTY
TOWNSHIP 9 NORTH
TOWNSHIP 8 NORTH
RANGE 14 EAST
RANGE 15 EAST
INDEX MAP
DANE CO.
JEFFERSON CO.
DODGE CO.
DEANSVILLE
MARSHALL
WATERLOO
HUBBELLTON
WATERTOWN JCT.
SUN PRAIRIE
BURKE
WATERTOWN JCT.
CORPORATE LIMITS
Subscribed and sworn to before me this 3 day of August
Notary Public in and for the
State of Illinois
My commission expires April 6, 1924
State of Illinois } S.S.
County of Cook }
I, the undersigned, officer of the Chicago, Milwaukee & St. Paul Railway Co. do hereby certify that this is a correct map, or a portion of a correct map, of the property owned by said Company, as represented from the records of said company.
Corporate Seal
Division Engineer