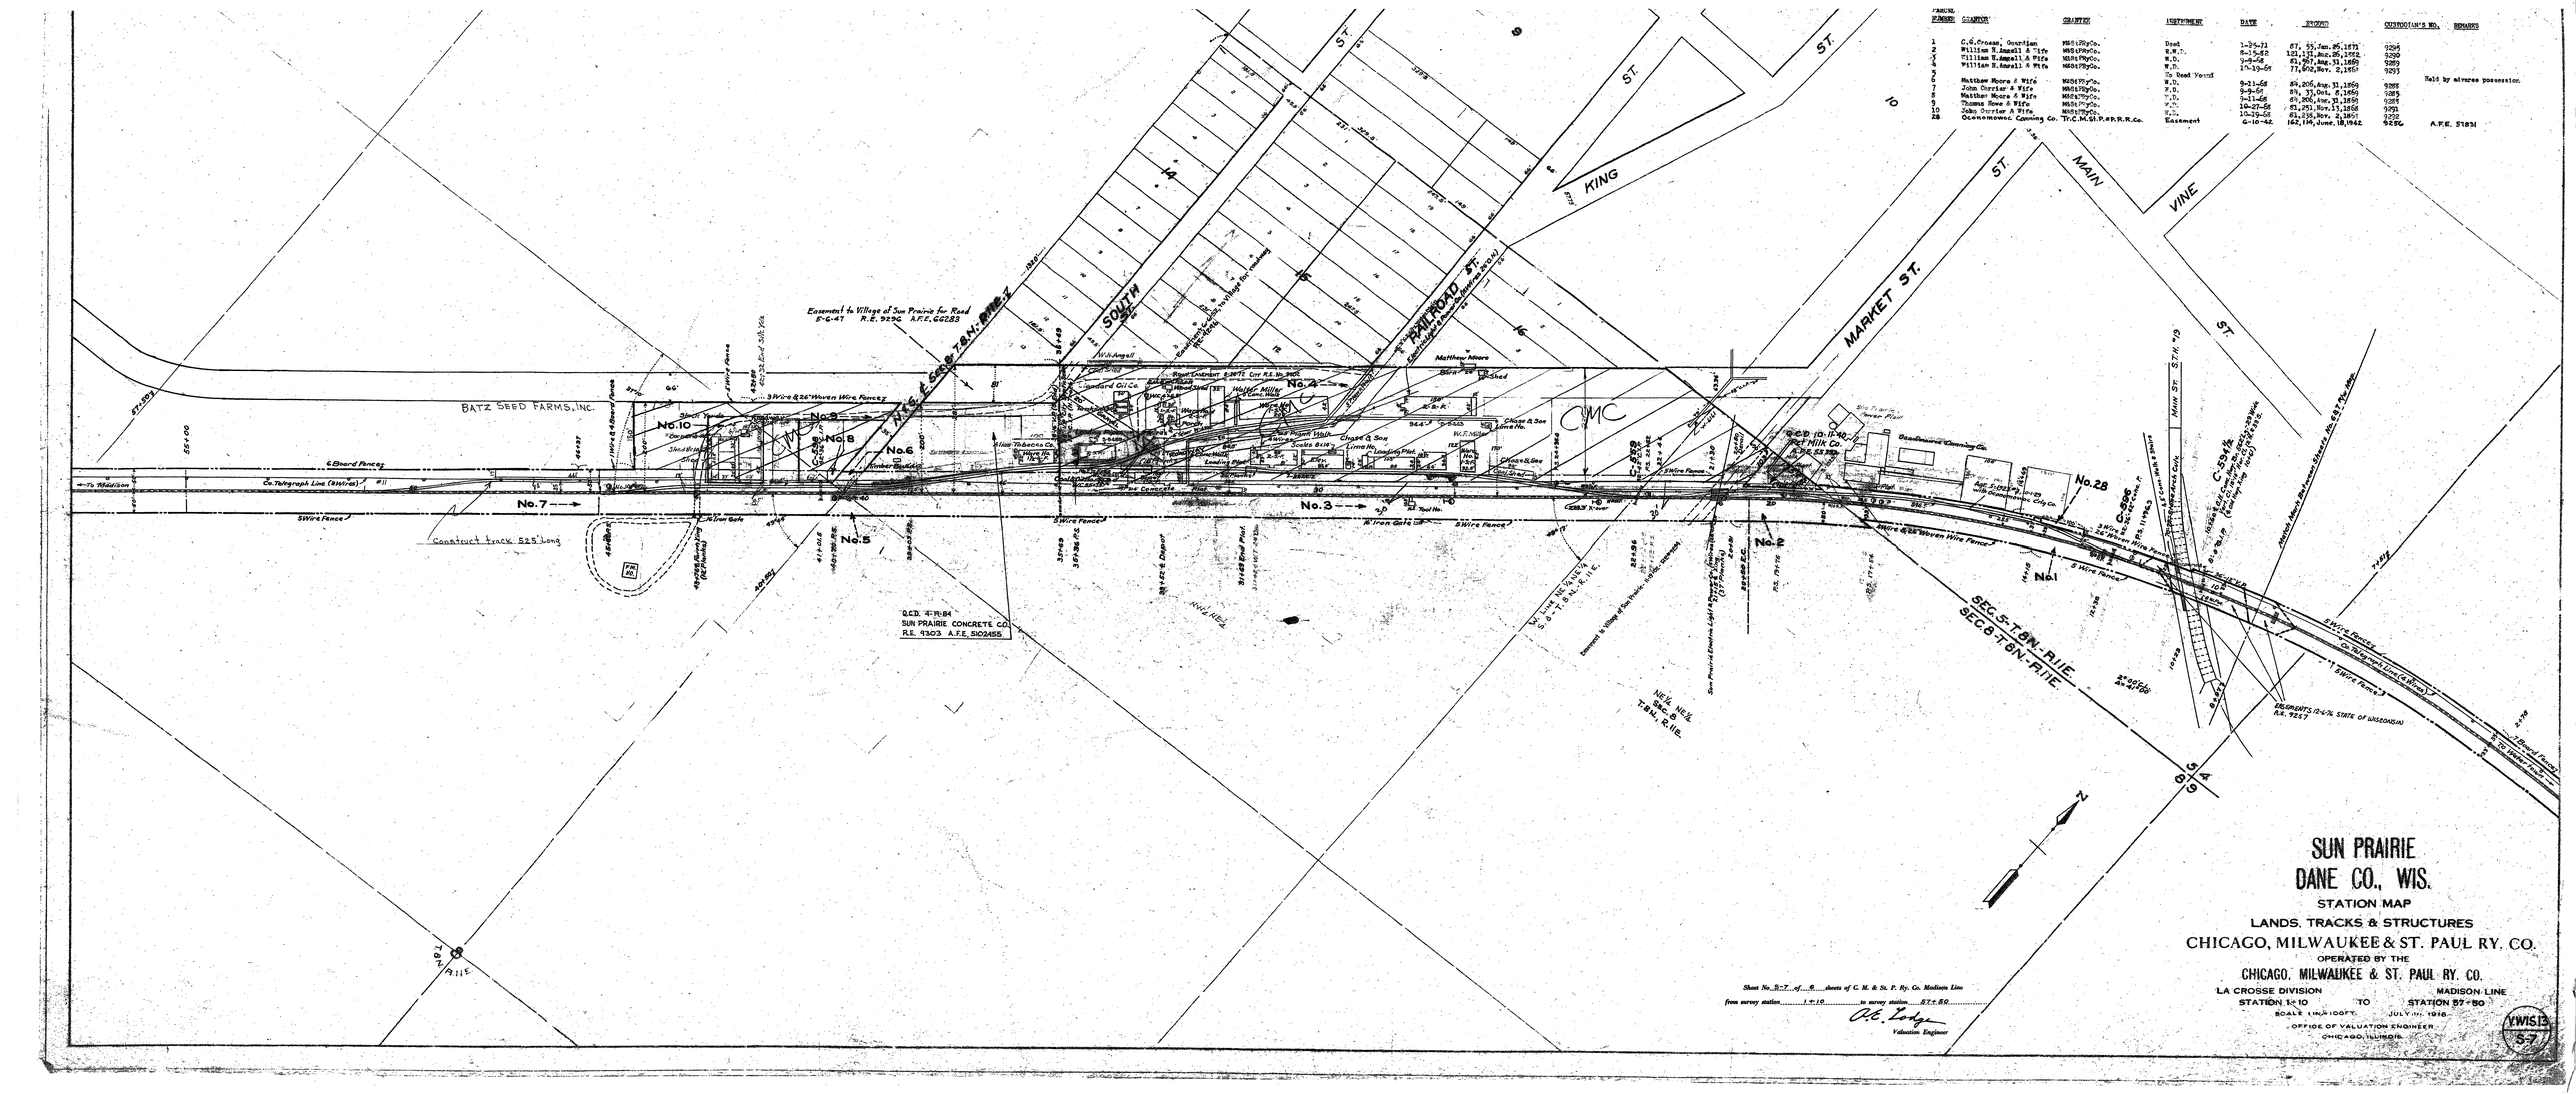
PARCEL NUMBER
GRANTOR
GRANTEE
INSTRUMENT
DATE
RECORD
CERTIFICATE'S NO.
REMARKS
1 C.C.Creamer, Guardian M&StPRyCo. Deed 1-25-71 67, 55, Jan.25,1871 9295
2 William W.Ansell & Wife M&StPRyCo. R.W.T. 8-15-82 102,131,Nov.25,1892 9290
3 William W.Ansell A Wife M&StPRyCo. W.D. 9-9-56 61,967,Aug.31,1868 9289
4 William W.Ansell & Wife M&StPRyCo. W.D. 10-10-56 77,502,Nov. 2,1865 9293
5 To Dead Vermil
6 Matthew Moore & Wife M&StPRyCo. W.D. 9-21-56 69,206,Aug.31,1866 9286 Held by adverse possession.
7 John Dorter & Wife M&StPRyCo. W.D. 9-9-56 64, 37,Oct. 2,1865 9285
8 Matthew Moore & Wife M&StPRyCo. W.D. 9-21-56 69,206,Nov.31,1866 9284
9 Thomas Howe & Wife M&StPRyCo. W.D. 10-27-56 61,251,Nov.11,1856 9291
10 John Dorter & Wife M&StPRyCo. W.D. 10-29-56 61,256,Nov. 2,1857 9292
28 Oconomowoc Canning Co. Tr.C.M.St.P.&P.R.R.Co. Easement 6-10-42 162,196,June 18,1942 9256 A.F.E. 51831
SOUTH ST.
KING ST.
MAIN ST.
VINE ST.
MARKET ST.
RAILROAD ST.
BATZ SEED FARMS, INC.
SEC.8-T.8N.-R.11E.
SEC.9-T.8N.-R.11E.
Easement to Village of Sun Prairie for Road F-C-41 R.E. 9236 A.F.E. 60283
Construct track 525' long
Q.C.D. 4-11-84 SUN PRAIRIE CONCRETE CO. R.E. 9303 A.F.E. SIC2455
Easements (2-6-74 State of Wisconsin) R.E. 9257
No.1
No.2
No.3
No.4
No.5
No.6
No.7
No.8
No.9
No.10
No.28
C.394½
C.395
C.393
Oconomowoc Canning Co.
Sun Prairie Concrete Co.
Sun Prairie Electric Light & Power Co.
Chase & Son
Matthew Moore
Water Mill
Coal House
Shed
Scales
Loading Platform
Tool House
Section House
Oil House
Gasoline Tank
Telegraph Line (8 Wires)
Co. Telegraph Line (4 Wires)
Co. Telephone Line (2 Wires)
Sun Prairie Electric Light & Power Co. (2 Poles)
Easement to Village of Sun Prairie for Road
Sec. Line Between Sec's 8 & 9 T.8N.R.11E.
W. Line NE¼ NE¼ Sec. 8 T.8N.R.11E.
NE¼ NE¼ Sec. 8 T.8N.R.11E.
T.9N.R.11E.
T.8N.R.11E.
Sheet No. S-7 of 6 sheets of C. M. & St. P. Ry. Co. Madison Line
from survey station 1+10 to survey station 57+50
A.E. Lodge
Valuation Engineer
SUN PRAIRIE
DANE CO., WIS.
STATION MAP
LANDS, TRACKS & STRUCTURES
CHICAGO, MILWAUKEE & ST. PAUL RY. CO.
OPERATED BY THE
CHICAGO, MILWAUKEE & ST. PAUL RY. CO.
LA CROSSE DIVISION
MADISON LINE
STATION 1+10 TO STATION 57+50
SCALE 1 IN. = 100 FT.
JULY 1916
OFFICE OF VALUATION ENGINEER
CHICAGO, ILLINOIS.
YWIS13
S-7