


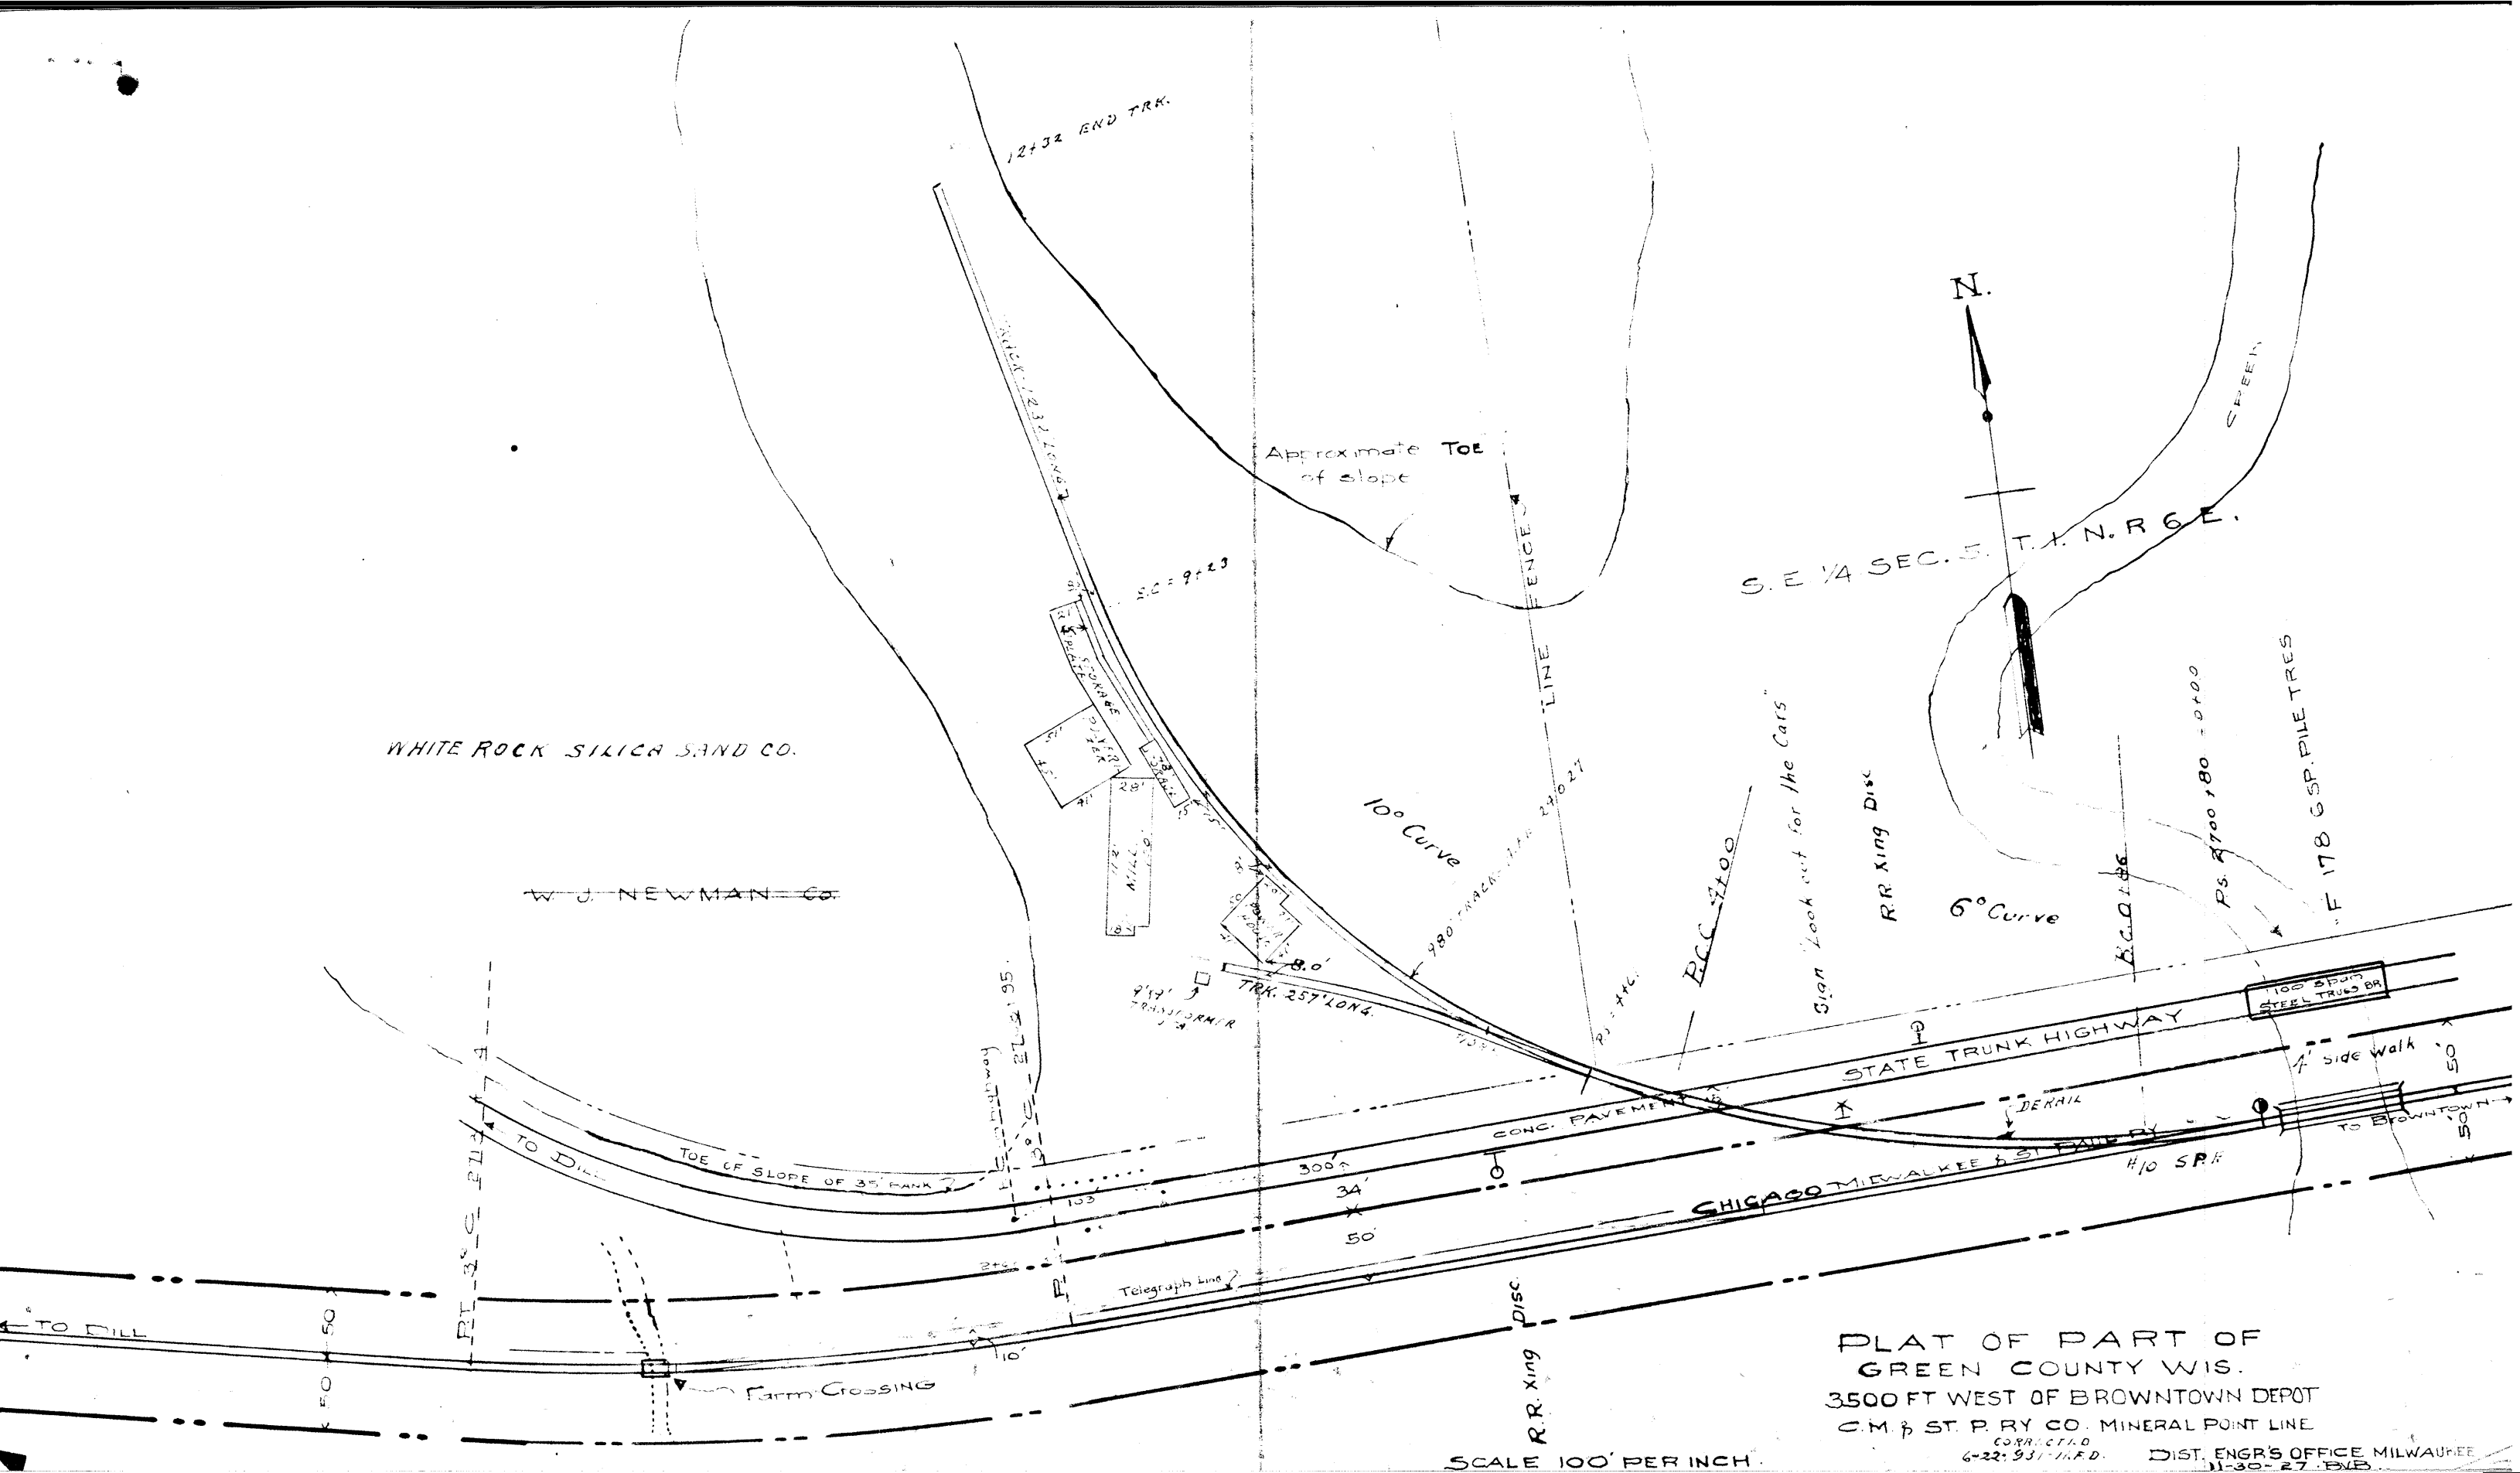

WHITE ROCK SILICA SAND CO.

W. J. NEWMAN CO.

12+32 END TRK.

Approximate Toe of slope

20 = 9+23

10° Curve

480' TRACK L.F. 24027

P.C.C. 7100

Sign "Look out for the Cars"

R.R. Xing Disc

6° Curve

P.S. 2700+80 = 0+00

F 178 GSP. PILE TREES

STATE TRUNK HIGHWAY

CHICAGO MILWAUKEE & ST. PAUL RY.

H/10 S.P.R.

TOE OF SLOPE OF 35' BANK

Telegraph line

Farm Crossing

PLAT OF PART OF
GREEN COUNTY WIS.
3500 FT WEST OF BROWNTOWN DEPOT
C.M. & ST. P. RY. CO. MINERAL POINT LINE
CORRECTED
6-22-93 J.H.F.D. DIST. ENGR'S OFFICE MILWAUKEE
11-30-27 B.V.B.

SCALE 100' PER INCH.