AREA Sq.Ft.	AREA Acres	Parcel Number	Custodian's Number	Instrument	Date	Grantor	Grantee	Record	Remarks
	1.07	1.	5859	Warranty Deed	June 28,1898	George A. Lawrence By Occupation	C.St.P.M.& O.Ry.Co.	RB"79" 194,July 1,1898	In S.W.¼,S.W.¼,Sec.36, T.29 N.,R.15 W.
30550		2.		" "		" "	" "	" "	" "
	2.08	3.	125	" "	" 6,1873	Wm. Harrington	West Wis. Ry. Co.	RB "2" 434,Jun.27,1873	" E½,S.E.¼, " "
	1.23	4.	8746	Quit Claim Deed	Apr. 15,1912	Mrs. Dora Schulze	C.St.P.M.& O.Ry.Co.	RB"122"466,Apr.17,1912	" S.E.¼,S.E.¼, " "
	3.97	5.	6064	Warranty Deed & Release	March 9,1899	Daniel Thatcher,Jr.	" " "	RB"83" 151,Mar.13,1899	" N.E.¼,S.E.¼,and S.E.¼,S.E.¼, " "
	6.01	6.	(6067	Warranty Deed	" " "	Wm. Milliron	" " "	RB"80"602&603,Mar.11,"	" W½, S.W.¼,Sec.31, " " R.14 W.
			(6330	Release	Nov. 5,1900	" " "	" " "	RB"82" 550,Nov. 7,1900	" " " "
	6.17	7.	6066	Warranty Deed & Release	March 8,1899	Harvey Petrie	" " "	RB"80" 660,Mar.11,1899	" N.E.¼,S.W.¼, " "
4500		8.	(6086	Warranty Deed	March 9,1899	Fred H. Gross	" " "	RB"82" 30," " "	" N.W.¼,S.E.¼, " "
			(6086	Release	" 24,1900	" " "	" " "		Change of Highway " "
	6.06	9.	(7978	Patent	Sept. 29,1871	United States	West Wis. Ry. Co.	DR"35" 12, Jun.10, 1873	" " " "
			(6284	Agreement	July 27,1900		C.St.P.M.& O.Ry.Co.		Change of Highway
	6.16	10.	1614	Warranty Deed & Release	Oct. 8, 1877	Charles W. Bailey	West Wis. Ry. Co.	RB"18" 514,Oct.23,1877	" S.½,N.W.¼ and N.½,S.W.¼, Sec.32, " "
	6.73	11.	8724	Warranty Deed & Release	Apr.19,1912	Wm. S. Casey	C.St.P.M.& O.Ry.Co.	RB"77" 483,May 3,1912	" S.½,N.W.¼, " "
	4.81	12.)	8725	Warranty Deed	Apr.22,1912	James Austin	" " " "	" 482, " "	" S.W.¼,N.E.¼, " "
4613		13.)							
40000		14.	205	R.of W. Deed & Release	Sept.19,1877	James Brown,et al	West Wis. Ry. Co.	RB"18",498,Oct.10,1877	" S.W.¼,N.E.¼, " "

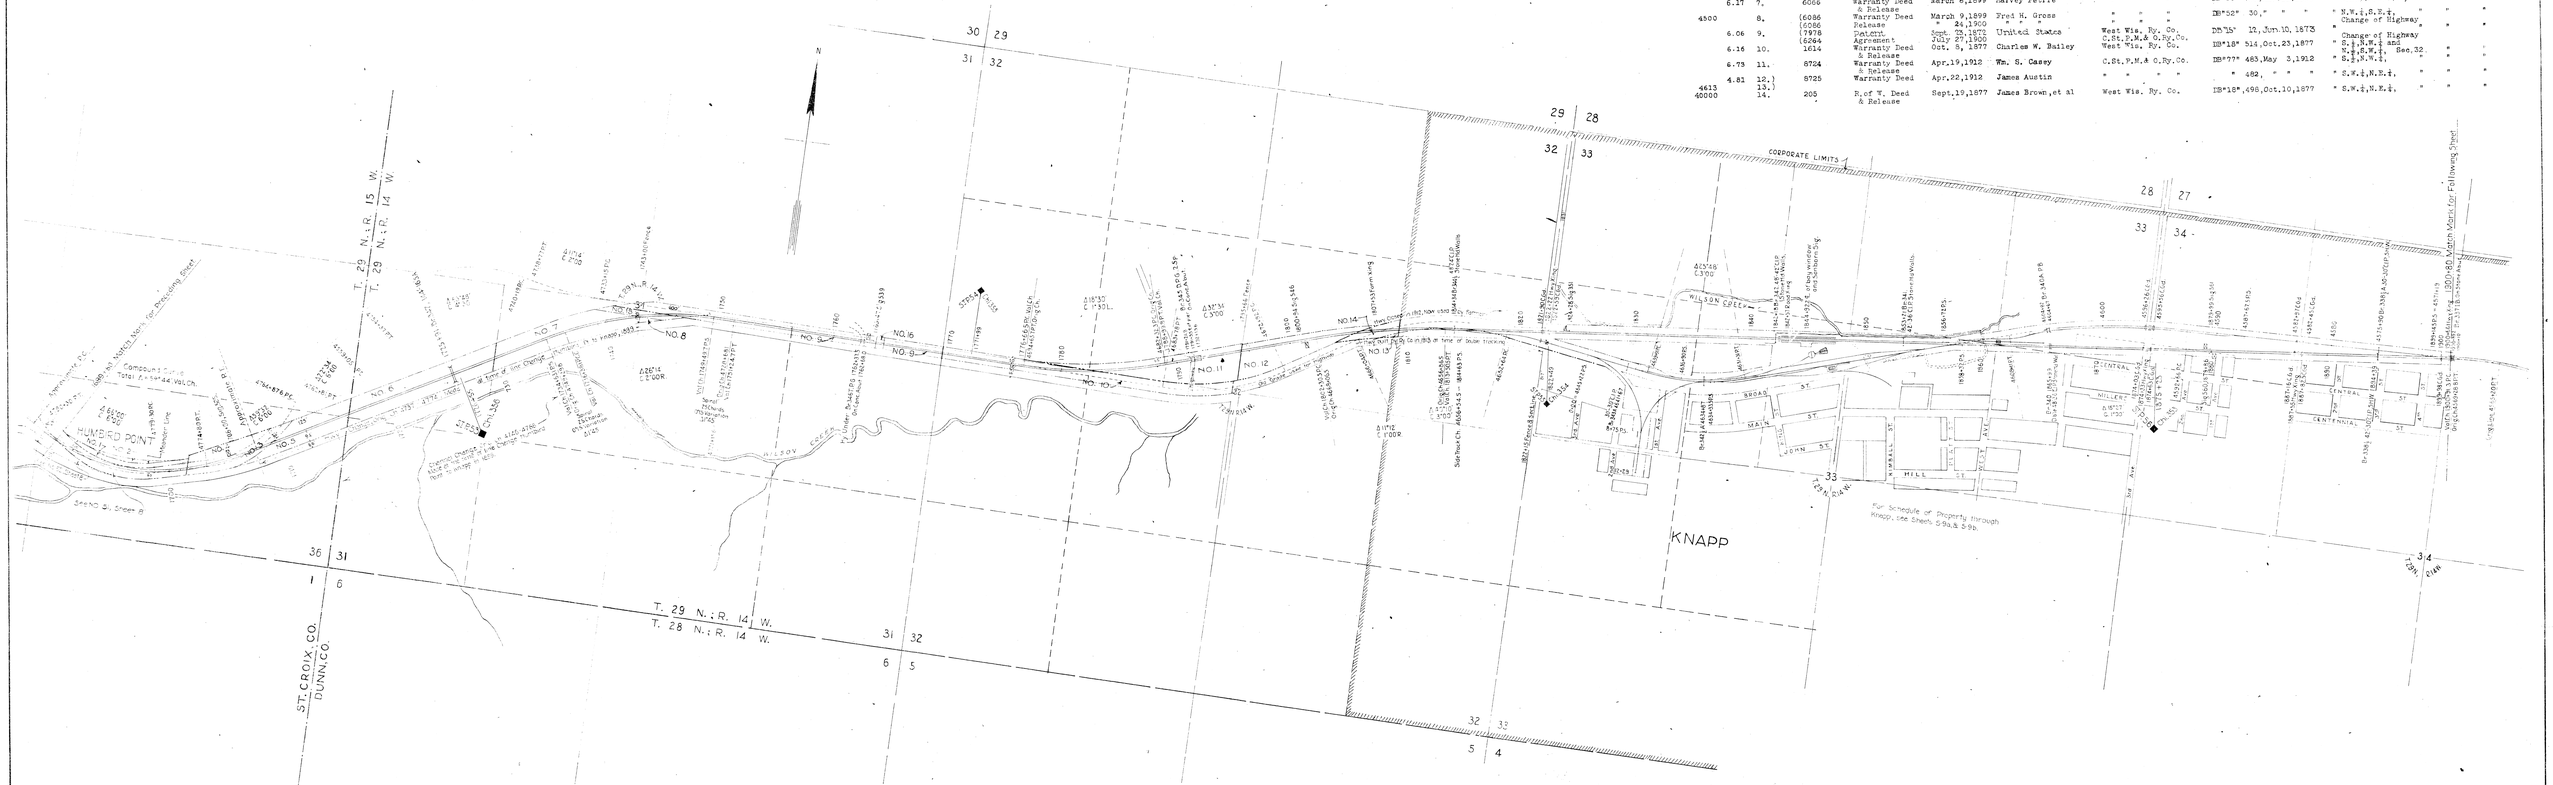

RIGHT OF WAY AND TRACK MAP

CHICAGO ST. PAUL MINNEAPOLIS AND OMAHA RAILWAY CO.

EASTERN DIVISION

HUDSON TO TRUAX

OPERATED BY C.St.P.M.&O.Ry.Co.

STATION 1689+60 TO STATION 1900+80

SCALE, 1 IN.=400 FT.

OFFICE OF CHIEF ENGINEER, ST.PAUL, MINN., JUNE 30, 1917

V.I W.S. 9