


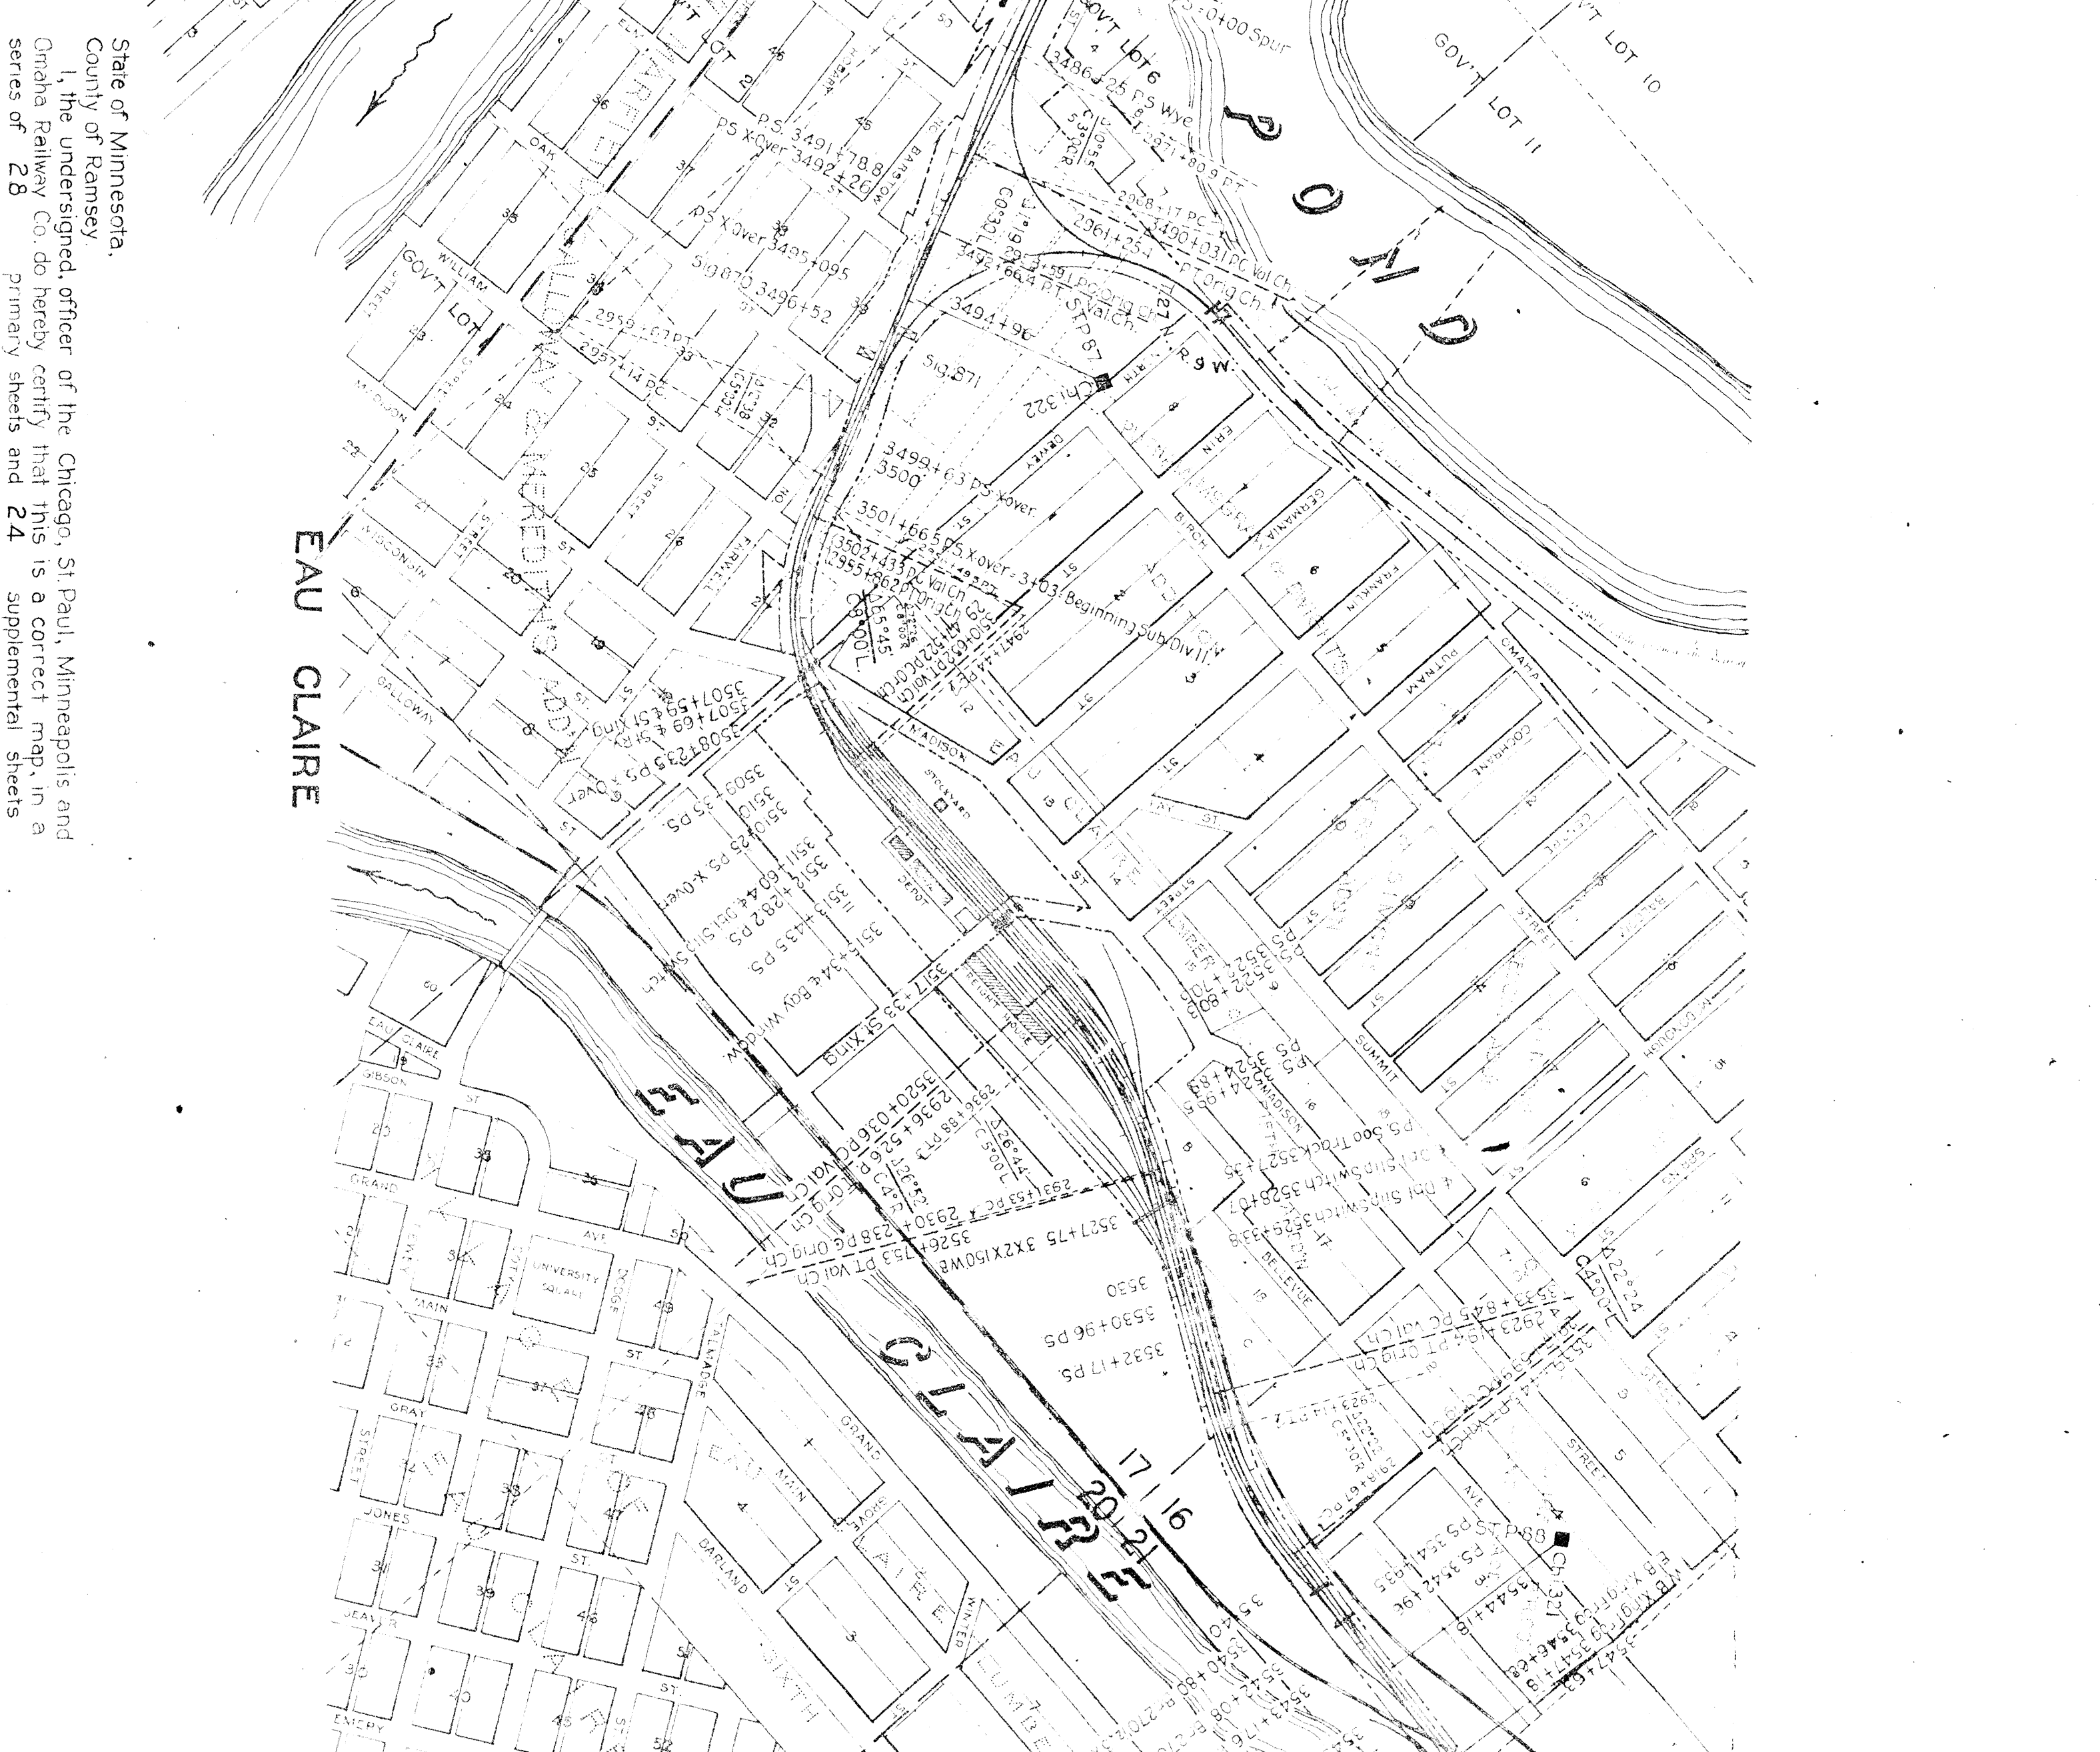

RIGHT OF WAY AND TRACK MA
CHICAGO ST. PAUL MINNEAPOLIS AND OMAHA RA

EASTERN DIVISION
TRUAX TO ELROY
OPERATED BY C. ST. P. M. & O. RY. CO.
STATION 33364.25 TO STATION 3547716.
SCALE, 1 IN. = 40 FT.
OFFICE OF CHIEF ENGINEER,
ST. PAUL, MINN., JUNE 30, 1917.