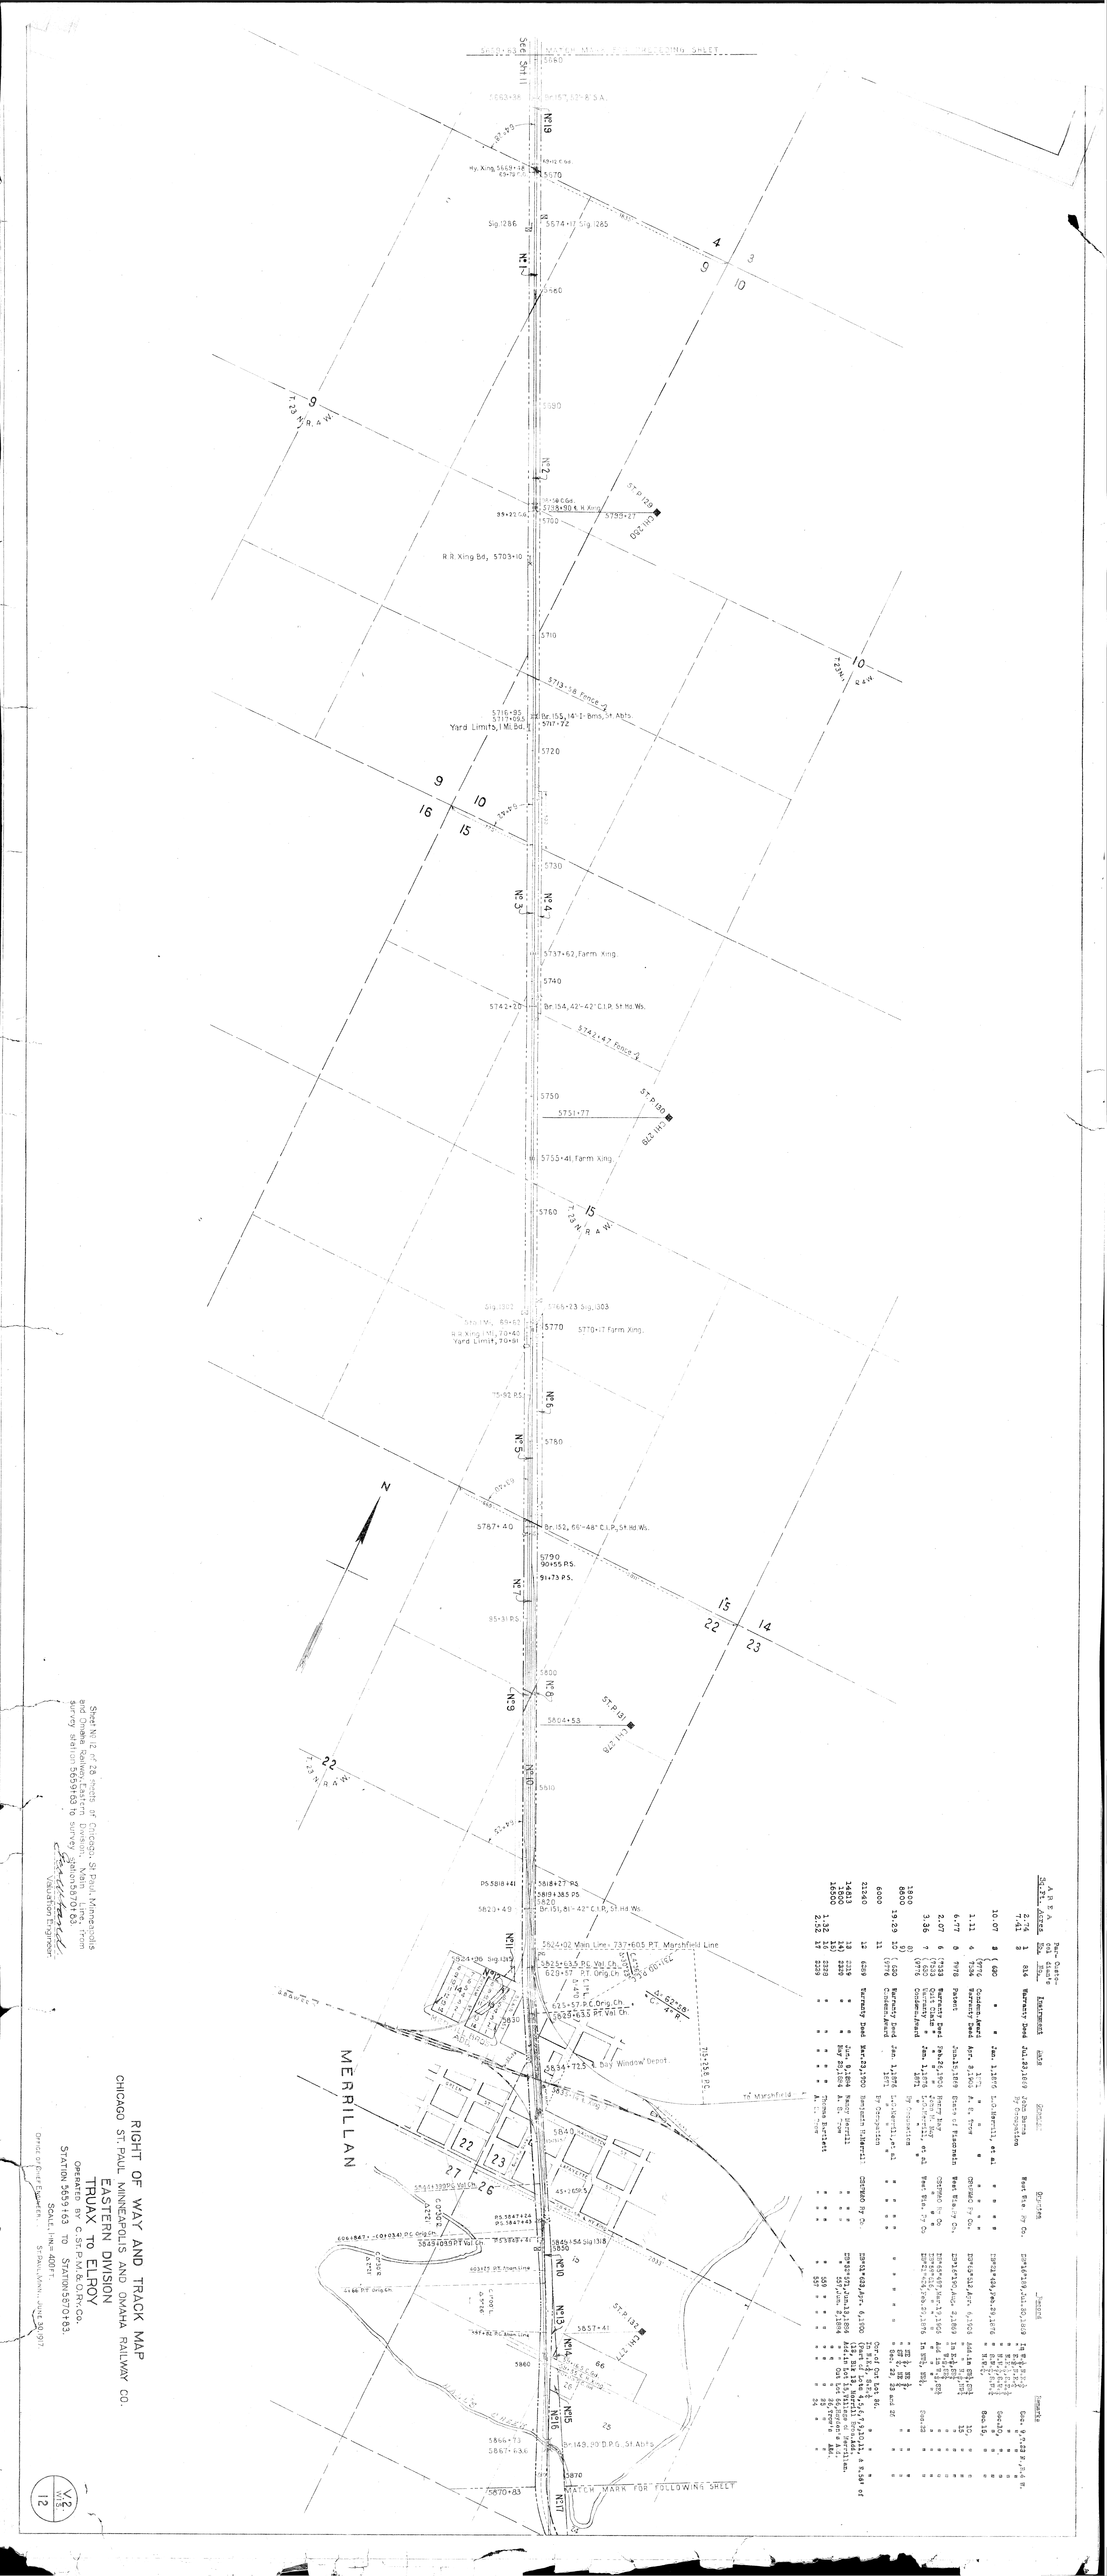
MERRILLAN
Sheet No. 12 of 26 sheets of Chicago, St. Paul, Minneapolis & Omaha Railway Co. Eastern Division Right of Way and Track Map Surveyed, Station 5659+63 to Station 5870+83.
Valuation Engineer.
RIGHT OF WAY AND TRACK MAP
CHICAGO ST. PAUL MINNEAPOLIS AND OMAHA RAILWAY CO.
EASTERN DIVISION
TRUAX to ELROY
OPERATED BY C. ST. P. M. & O. RY. CO.
STATION 5659+63 TO STATION 5870+83.
SCALE, 1 INCH = 400 FT.
OFFICE OF CHIEF ENGINEER, ST. PAUL, MINN., JUNE 30, 1917.
V.E. 12
Sta. 5659+83 MATCH MARK FOR PRECEDING SHEET
Br. 157, 53° R.S.A.
Hy. Xing, 5669+28
Sig. 1286
Sig. 1285
R.R. Xing Bd., 5703+10
5716+95
5717+65
Yard Limits, 1 Mi. Bd.
5717+72
Br. 155, 14° I-Bms., St. Abts.
5737+62, Farm Xing.
5742+29
Br. 154, 42°-42° C.I.P., St. Hd. Ws.
5743+47 Fence, R.
5751+77
5755+41, Farm Xing.
5765+23 Sig. 1303
Sig. 1302
5765+80, R.R. Xing (W.), 79°-62'
Yard Limits, 79°-91'
5770+17 Farm Xing.
5785+92 P.S.
5787+40
Br. 152, 66°-48° C.I.P., St. Hd. Ws.
5790
90-55 P.S.
91-73 P.S.
85-31 P.S.
5804+53
5818+27 P.S.
5819+385 P.S.
5820
Br. 151, 81°-42° C.I.P., St. Hd. Ws.
5823+49
5824+92 Main Line, 737+605 P.T., Marshfield Line
5824+26 Sig. 1284
5825+63.5 P.S. Vel. Ch., 5°-0'
5826+57 P.T. Orig. Ln.
5826.66 Orig. Ln.
625+57.9 P.C. Orig. Ch.
5829+63.5 P.T. Vel. Ch.
5830
5834+73.4 Bay Window Depot
To Marshfield
715+15.8 P.S.
5840
5845+69
5849+05 P.T. Orig. Ln.
5849+05.9 P.T. Vel. Ln.
5850
5857+41
5860
5866+73
5867+36
Br. 143, 89° D.P.G., St. Abts.
5870
5870+83
MATCH MARK FOR FOLLOWING SHEET
T. 23 N., R. 4 W.
T. 24 N., R. 4 W.
T. 23 N., R. 5 W.
T. 24 N., R. 5 W.
N. 19
N. 1
N. 2
N. 3
N. 4
N. 5
N. 6
N. 7
N. 8
N. 9
N. 10
N. 11
N. 12
N. 13
N. 14
N. 15
N. 16
N. 17
ST. P. 138
CH. 250
