AREA Sq.Ft.	AREA Acres	Parcel No.	Customer's No.	Instrument	Date	Grantor	Grantee	Record	Remarks	AREA Sq.Ft.	AREA Acres
	1.26	1	8483	Warranty Deed	May 19,1911	The Wells Company	C.St.P.M.& O. Ry. Co.	DB"75" 73,May 25, 1911	Add.In N.½,N.W.¼ Sec.34,T.20N., R.2W * " N.W.¼,N.E.¼		2.7723
1483		2				By Occupation			Cor N.E.¼,N.W.¼		4.7815
	5.15	3	658	Quit Claim "	Jul.29,1880	John C. Spencer	" " "	DB"28"178,Jul.31,1880	In N.½ "		
	1.29	4	8441	Warranty Deed	May 9,1911	William Zahrte	" " "	DB"75" 66,May 11,1911	Add.In N.½,N.W.¼ " " N.½,N.E.¼		7.8316
	2.34	5				By Occupation			In N.½,N.W.¼		
	4.86	6	(7244 (7245	" "	Dec.14,1868	Eli C. Rudd	West Wis. Ry. Co.	DB"14"477,Jun.23,1869	" N.½,N.W.¼ Sec.35, " S.½,N.W.¼	3.8317 1.9058	
14000		7)	8445	" "	May 9,1911	Alfred C. Hoy	C.St.P.M.& O.Ry.Co.	DB"75" 68,May 15,1911	Add.In S.W.¼,S.W.¼	3.7435	9875
	8.31	8)							Part of S.E.¼,S.W.¼	5.8920	546
	1.05	9	7976	Patent	Jun.16,1869	State of Wisconsin	West Wis. Ry. Co.	DB"16"190,Aug. 2,1869	Cor. S.W.¼,S.W.¼	6.5621	7976
	22.91	10	8482	Warranty Deed	Aug.11,1911	George L. Dunn	C.St.P.M.& O.Ry.Co.	DB"105"70,Aug.19,1911	In S.E.¼, Sec. 2,T.19N., R.2W " N.W.¼, Sec. 1, "	8300	22
1625	4.68	11	5989	Quit Claim "	Jun. 3,1865	D. B. Rudd, et al	" " "	DB"32"110,Jun. 9,1865	Pt N.E.¼,S.E.¼, Sec. 2,		
		12	(2316	" " "	May 29,1865	H. B. Mills	" " "	DB"32"109,Jun. 5,1865	" S.W.¼,N.W.¼, Sec. 1,		
			(2317	" " "	Jun. 6,1865	M. A. Thayer	" " "	DB"32"168,Oct. 1,1865	" S.W.¼,N.W.¼, "		

AREA Sq.Ft.	AREA Acres	Parcel No.	Customer's No.	Instrument	Date	Grantor	Grantee	Record	Remarks	AREA Sq.Ft.	AREA Acres
	2.7723										
		(2316	" " "	May 29,1865	H. B. Mills	" " "	DB"32"109,Jun. 5,1865	" N.E.¼,N.W.¼			
		(2317	" " "	Jun. 6,1865	M. A. Thayer	" " "	DB"32"168,Oct. 1,1865	" S.E.¼,N.W.¼			
		(5450	" " "	Jun. 3,1865	D. B. Rudd, et al	" " "	DB"32"111,Jun. 9,1865	" N.E.¼,S.W.¼,			
		(5450	" " "	Jun. 3,1865	D. B. Rudd, et al	" " "	DB"32"111,Jun. 9,1865	" N.W.¼,S.W.¼,			
		(5450	" " "	Jun. 3,1865	D. B. Rudd, et al	" " "	DB"32"111,Jun. 9,1865	" N.E.¼,S.W.¼,			
		(5450	" " "	May 4,1877	Henry P. Darling	" " "	DB"41"139,May 9,1877	" S.W.¼,S.W.¼,			
	7.8316	7976	Patent		Jun.15,1869	State of Wisconsin	West Wis. Ry. Co.	DB"16"191,Oct.9, 1869	" S.W.¼,S.W.¼, Cor. Sec. 2,T.19N.,R.2W		
		9875	Warranty Deed	Aug.28,1891	Charles L. Johnston By Occupation	C.St.P.M.& O.Ry.Co.	DB"96"258,Nov. 9,1891	In S.½,S.W.¼ " S.½,S.W.¼	Sec. 6, T. 19 R. 1W		
		9875	Warranty Deed	Aug.28,1891	Charles L. Johnston	" " "	DB"96"261, Nov. 9,1891	" S.½,N.W.¼	Sec. 7, " "		
		546	Quit Claim Deed	May 29,1865	George Warren, et al	" " "	DB"32"117, Jun.21,1865	" S.½,S.W.¼			
		7976	Patent	Jun.15,1869	State of Wisconsin	West Wis. Ry. Co.	DB"16"190, Oct. 9,1869	" N.½,N.W.¼	Sec. 7, " "		
		8538	Easement	Sec. 8,1911	O. D. Streeter	C.St.P.M. & O.Ry.Co.	(TOWN "499,Dec.12,1911) (of Misc.	(Ditch at Bridge No 76 Ch 5+3,N.W.¼,	Sec. 8, " "		

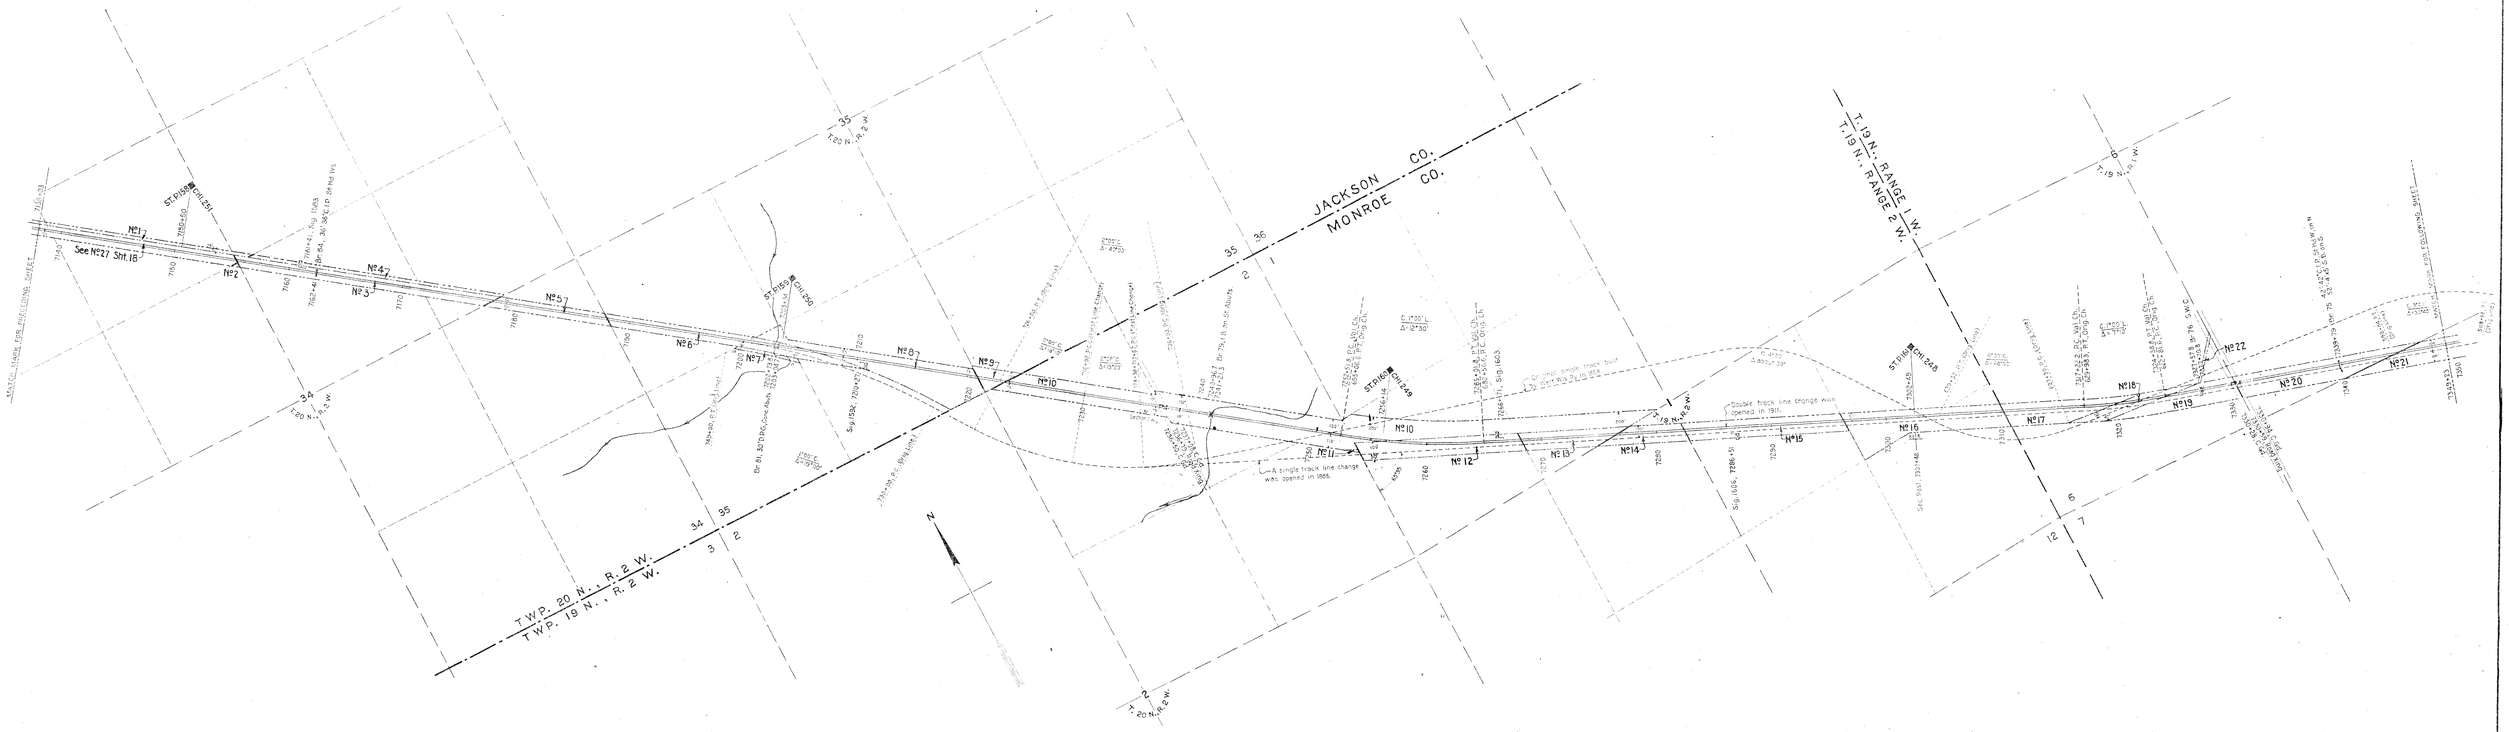

Sheet N° 19 of 28 sheets of Chicago, St. Paul, Minneapolis and Omaha Railway, Eastern Division, Main Line, from survey station 7138+03 to survey station 7349+23.

Valuation Engineer.

RIGHT OF WAY AND TRACK MAP

CHICAGO ST. PAUL MINNEAPOLIS AND OMAHA RAILWAY CO.

EASTERN DIVISION

TRUAX TO ELROY

OPERATED BY C.ST.P.M. & O.RY.CO.

STATION 7138+03 TO STATION 7349+23.

SCALE, 1 INCH = 400 FT.

OFFICE OF CHIEF ENGINEER. ST. PAUL, MINN., JUNE 30, 1917.

V.2 WIS. 19