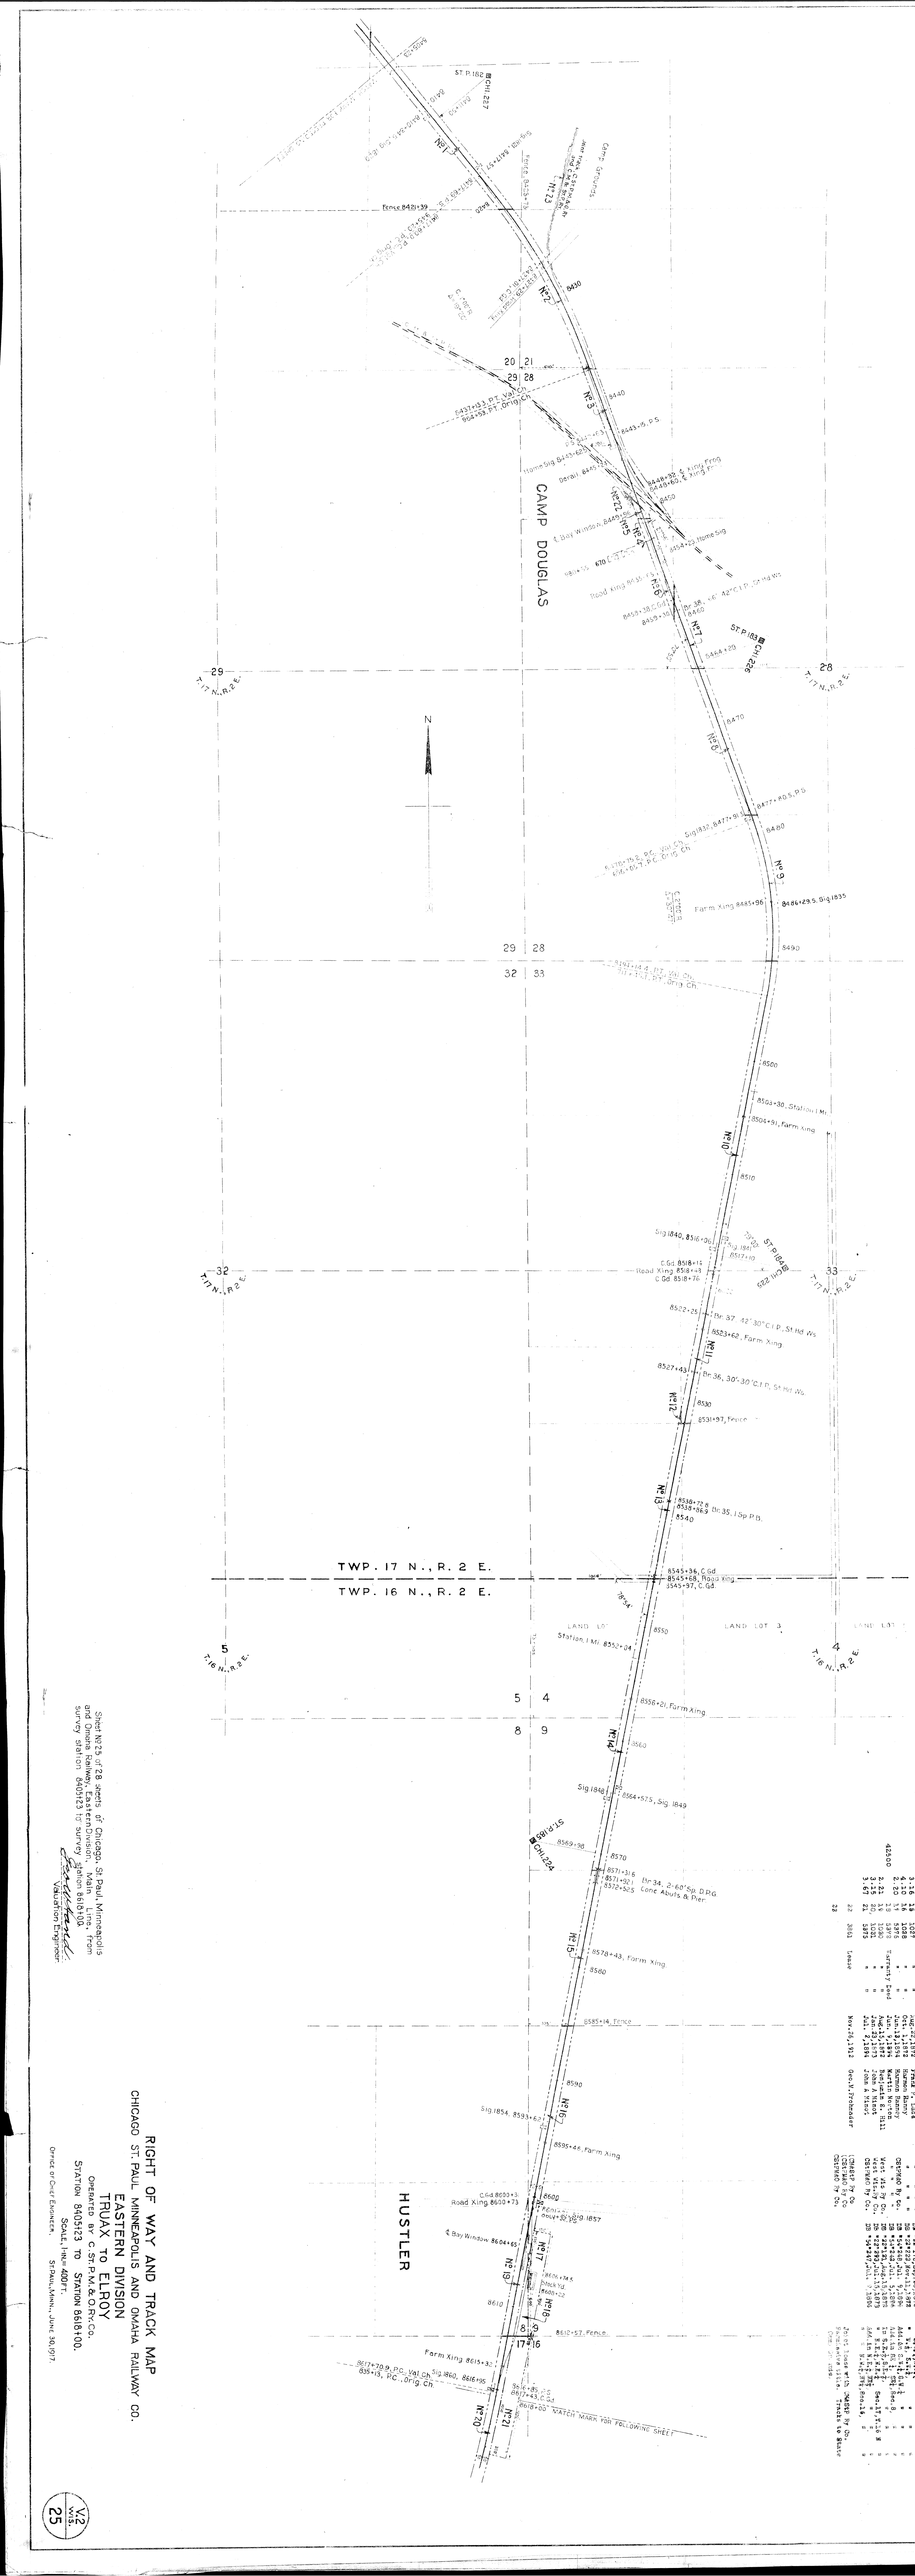
CAMP DOUGLAS
HUSTLER
TWP. 17 N., R. 2 E.
TWP. 16 N., R. 2 E.
T.17 N., R.2 E.
T.16 N., R.2 E.
LAND LOT 1
LAND LOT 2
LAND LOT 3
LAND LOT 4
Station 1 Mi. 8552+24
Station 2 Mi. 8502+30
Road Xing 8599+73
Road Xing 8615+30
Farm Xing 8615+30
Farm Xing 8578+43
Farm Xing 8595+46
Farm Xing 8504+91
Farm Xing 8485+86
Farm Xing 8527+43
Farm Xing 8531+97
Farm Xing 8558+21
Fence 8585+14
Fence 8612+57
Fence 8428+39
Br. 38 Ag'l P. Xing W.
Br. 37 42°30' C.I.P. St Rd W.
Br. 36, 30°-30° C.I.P. St Rd W.
Br. 35, I Sp P.G.
Br. 34, 2-60° Sp. P.R.G. Conc Abuts & Pier
Sig 1840, 8516+26
Sig 1849, 8564+75
Sig 1854, 8593+67
Sig 1860, 8616+95
Sig 1857, 8609+29
Sig 1837, 8471+91
Sig 1835, 8466+29.5
