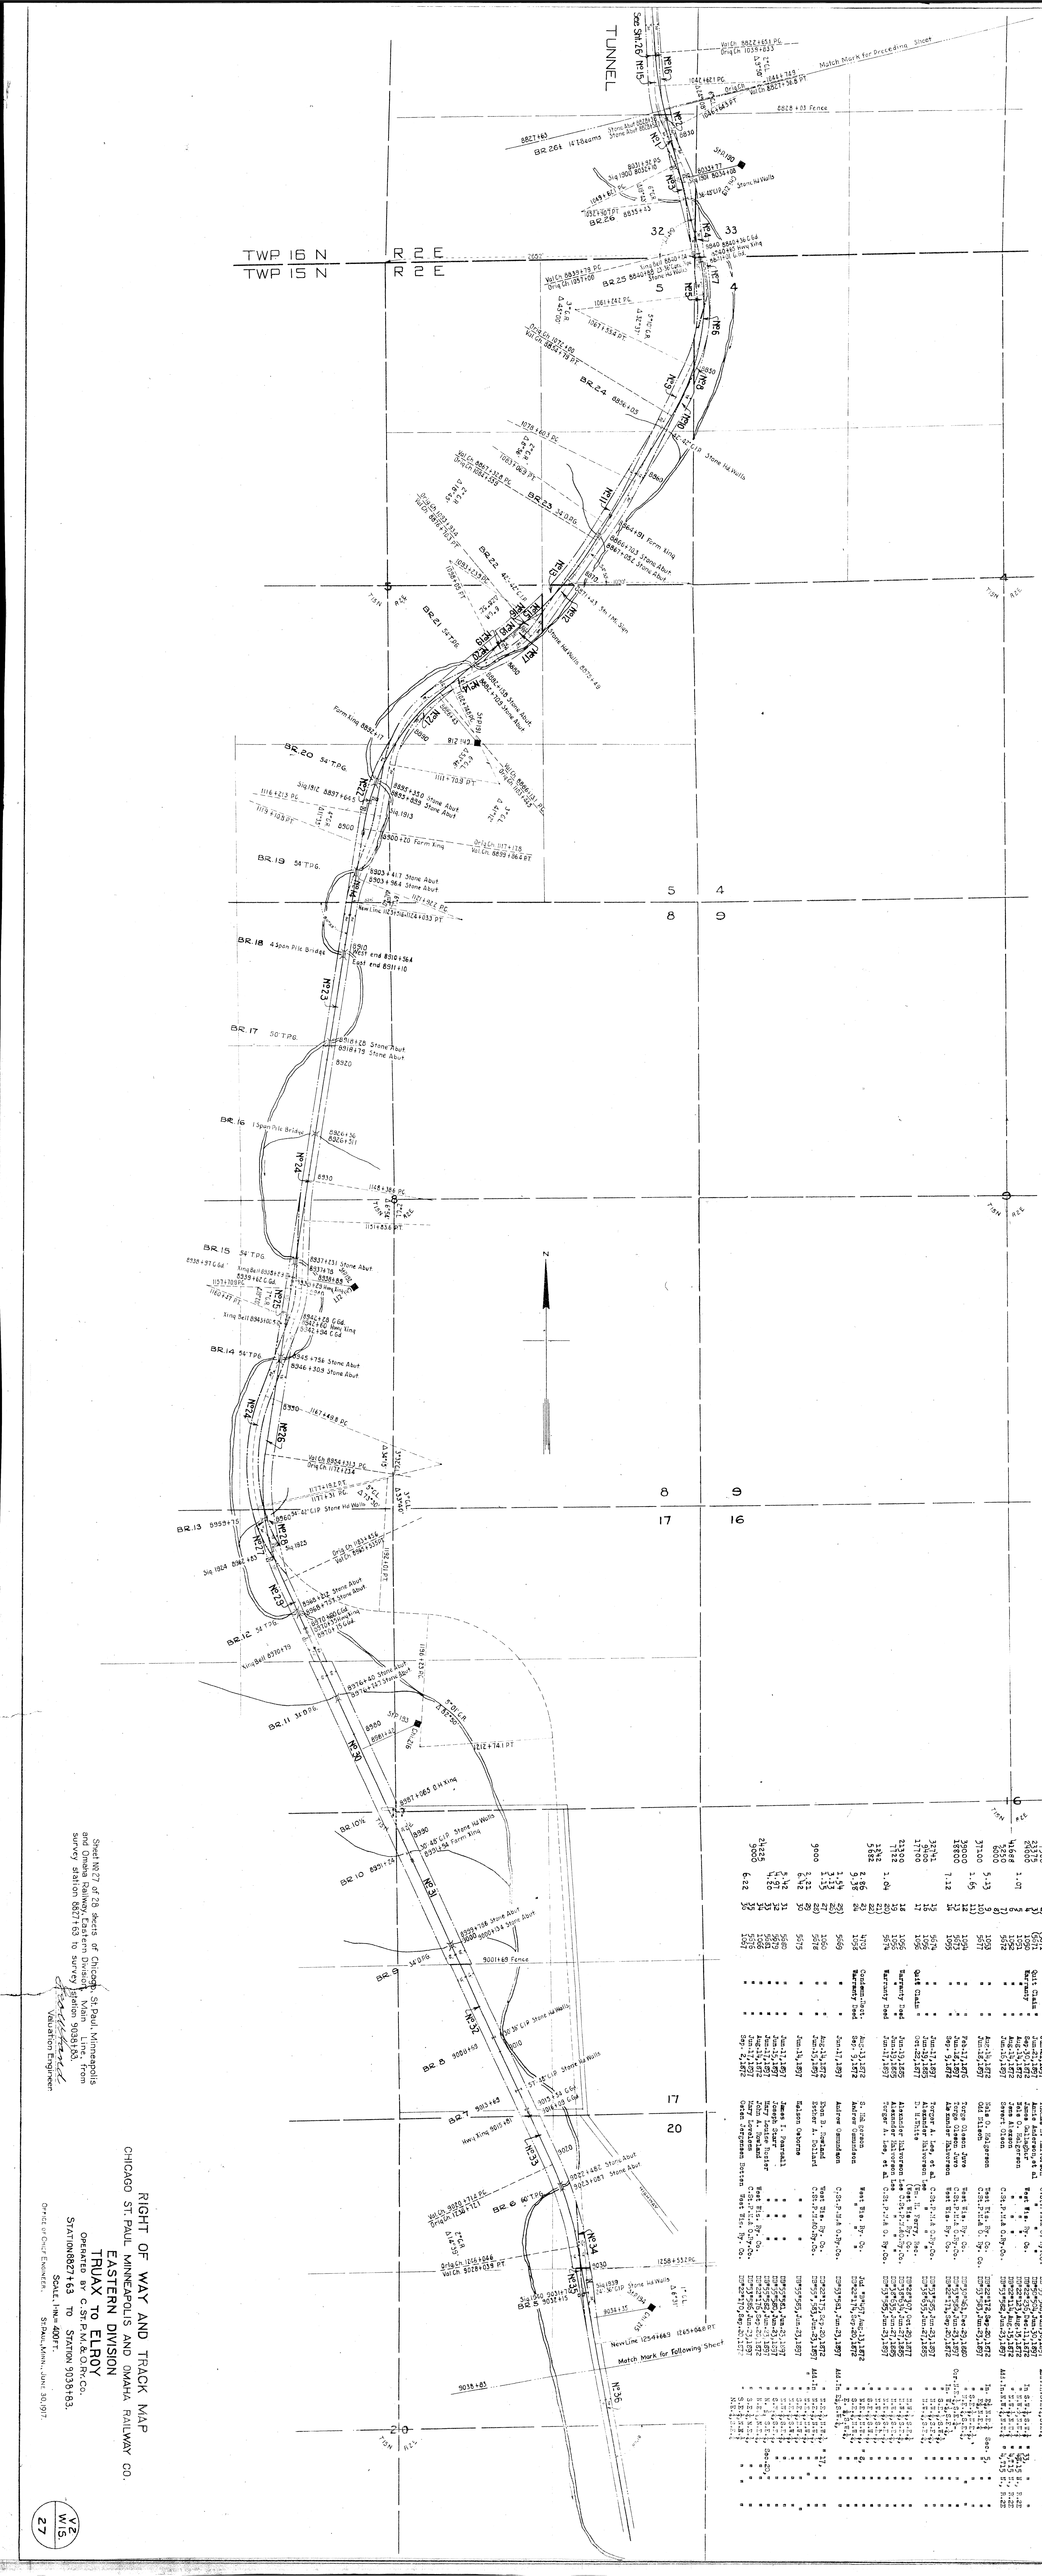

RIGHT OF WAY AND TRACK MAP

CHICAGO ST. PAUL, MINNEAPOLIS AND OMAHA RAILWAY CO.

EASTERN DIVISION

TRUAX to ELROY

OPERATED BY THE Chicago St. Paul, Minneapolis & Omaha Ry. Co.

STATION 8827+63 TO STATION 9036+83.

Sheet No 27 of 28 Sheets of Chicago, St. Paul, Minneapolis and Omaha Railway Co. Property Maps. Beginning at survey station 8827+63 to survey station 9036+83.

Chief Engineer

Valuation Engineer

ST. PAUL, MINN., JULY 30, 1917.

Chief of Chief Engineer's Div.

W2
W.I.S.
27