Parcel No.	Customer's No.	Instrument	Date	Grantor	Grantee	RECORD Book	Page	Date	AREA Acres	Sq. Ft.	Remarks.
1				State Swamp	C.St.P.M.& O.Ry.Co.				6.23		S.½, 12-43-6 W.
2	356	Condemnation	Dec. 1,1882	C. W. Griggs, et al	" " "	Judg.1,Pg.67			3.09		S.W.¼,N.E.¼, " " "
3	356	Condemnation	Dec. 1,1882	J. T. Davis	" " "				2.11		N.W.¼,N.E.¼, " " "
4				State Swamp	" " "				6.20		S.E.¼, 1 " "
5	356	Condemnation	Dec. 1,1882	J. M. Robinson, et al	" " "	" " "			2.44		S.E.¼,N.E.¼, " " "
6	270	Q. C. Dd.	Sep.23,1882	Charles H. Pratt	" " "	6	664	Aug. 6,1883	2.63		W.½, N.E.¼, " " "
7	(5845	Warr. Dd.	Jul.16,1893	John A. Humbird	" " "	29	72	Aug.30,1893	2.71		N.W.¼,N.E.¼, " " "
8	(5845	Warr. Dd.	Aug.22,1893	Alexander Gunn, et al	" " "	29	79	Sep. 5,1893	9.03		S.W.¼,S.E.¼, 36-46-6 W.
9	356	Condemnation	Dec. 1,1882	Alexander Gunn, et al	" " "	Judg.1,Pg.67			1.70		S.W.¼,S.E.¼, " " "
10	"			Antoine Arpin	" " "	" " "			2.04		S.E.¼,S.W.¼, " " "
11	423	Condemnation	May 22,1883	Peter McGulgan	" " "	6	603	May 22,1883	3.15		N.E.¼,S.W.¼, " " "
12	(356	Condemnation	Dec. 1,1882	Alexander Gunn, et al	" " "	Judg.1,Pg.67			6.44		E.½, N.W.¼, " " "
	(349	Condemnation	Aug.15,1883	Isaac H. Wing	" " "	6	671	Aug.15,1883			" " "
13				U. S.	" " "					10350	N.W.¼,N.E.¼, " " "
14	7976	Patent	Feb.14,1884	State of Wis.	" " "	14	9	Dec. 9,1885	20.80		25 " "

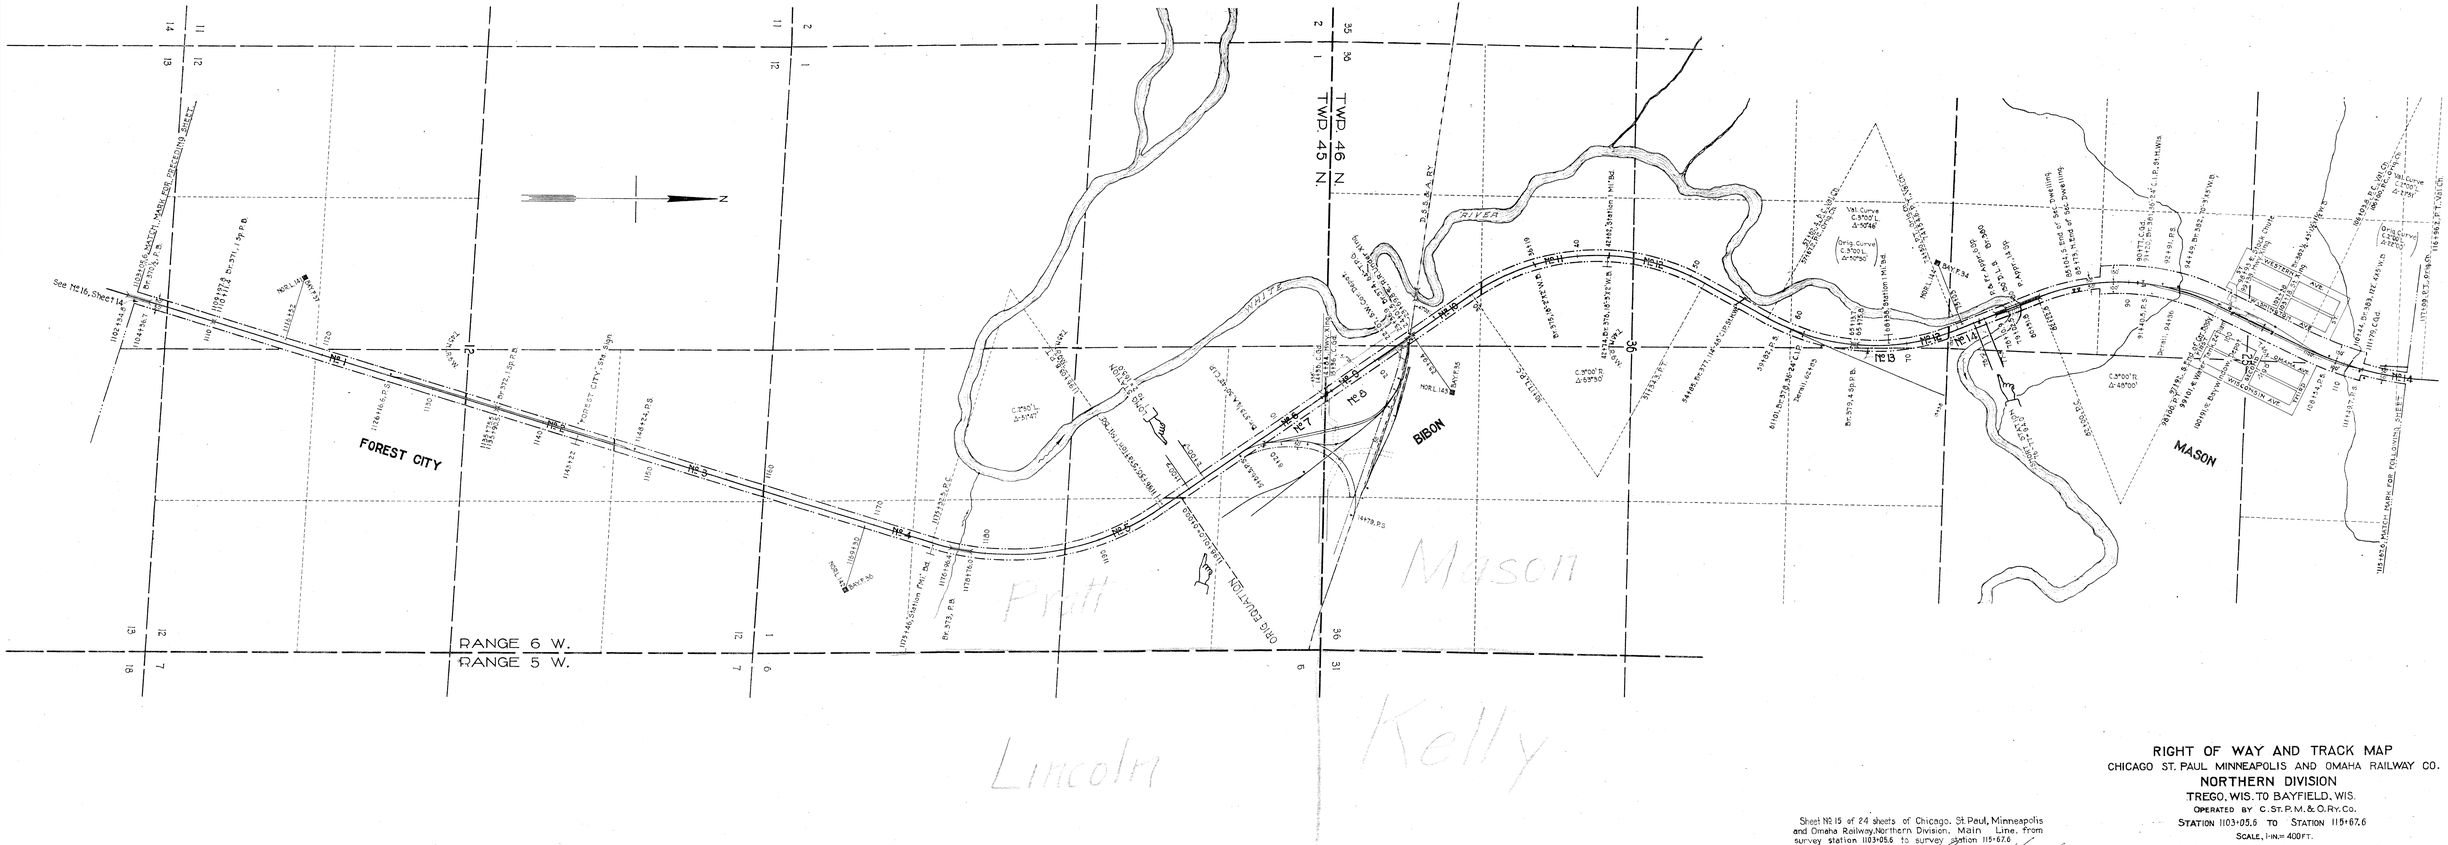

RIGHT OF WAY AND TRACK MAP
CHICAGO ST. PAUL MINNEAPOLIS AND OMAHA RAILWAY CO.
NORTHERN DIVISION
TREGO, WIS. TO BAYFIELD, WIS.
OPERATED BY C. ST. P. M. & O. RY. Co.
STATION 1103+05.6 TO STATION 1157+67.6
SCALE, 1 IN. = 400 FT.
OFFICE OF CHIEF ENGINEER. ST. PAUL, MINN., JUNE 30, 1917.

Sheet No. 15 of 24 sheets of Chicago, St. Paul, Minneapolis and Omaha Railway, Northern Division, Main Line, from survey station 1103+05.6 to survey station 1157+67.6

Valuation Engineer

V.10 WIS. 15