
 


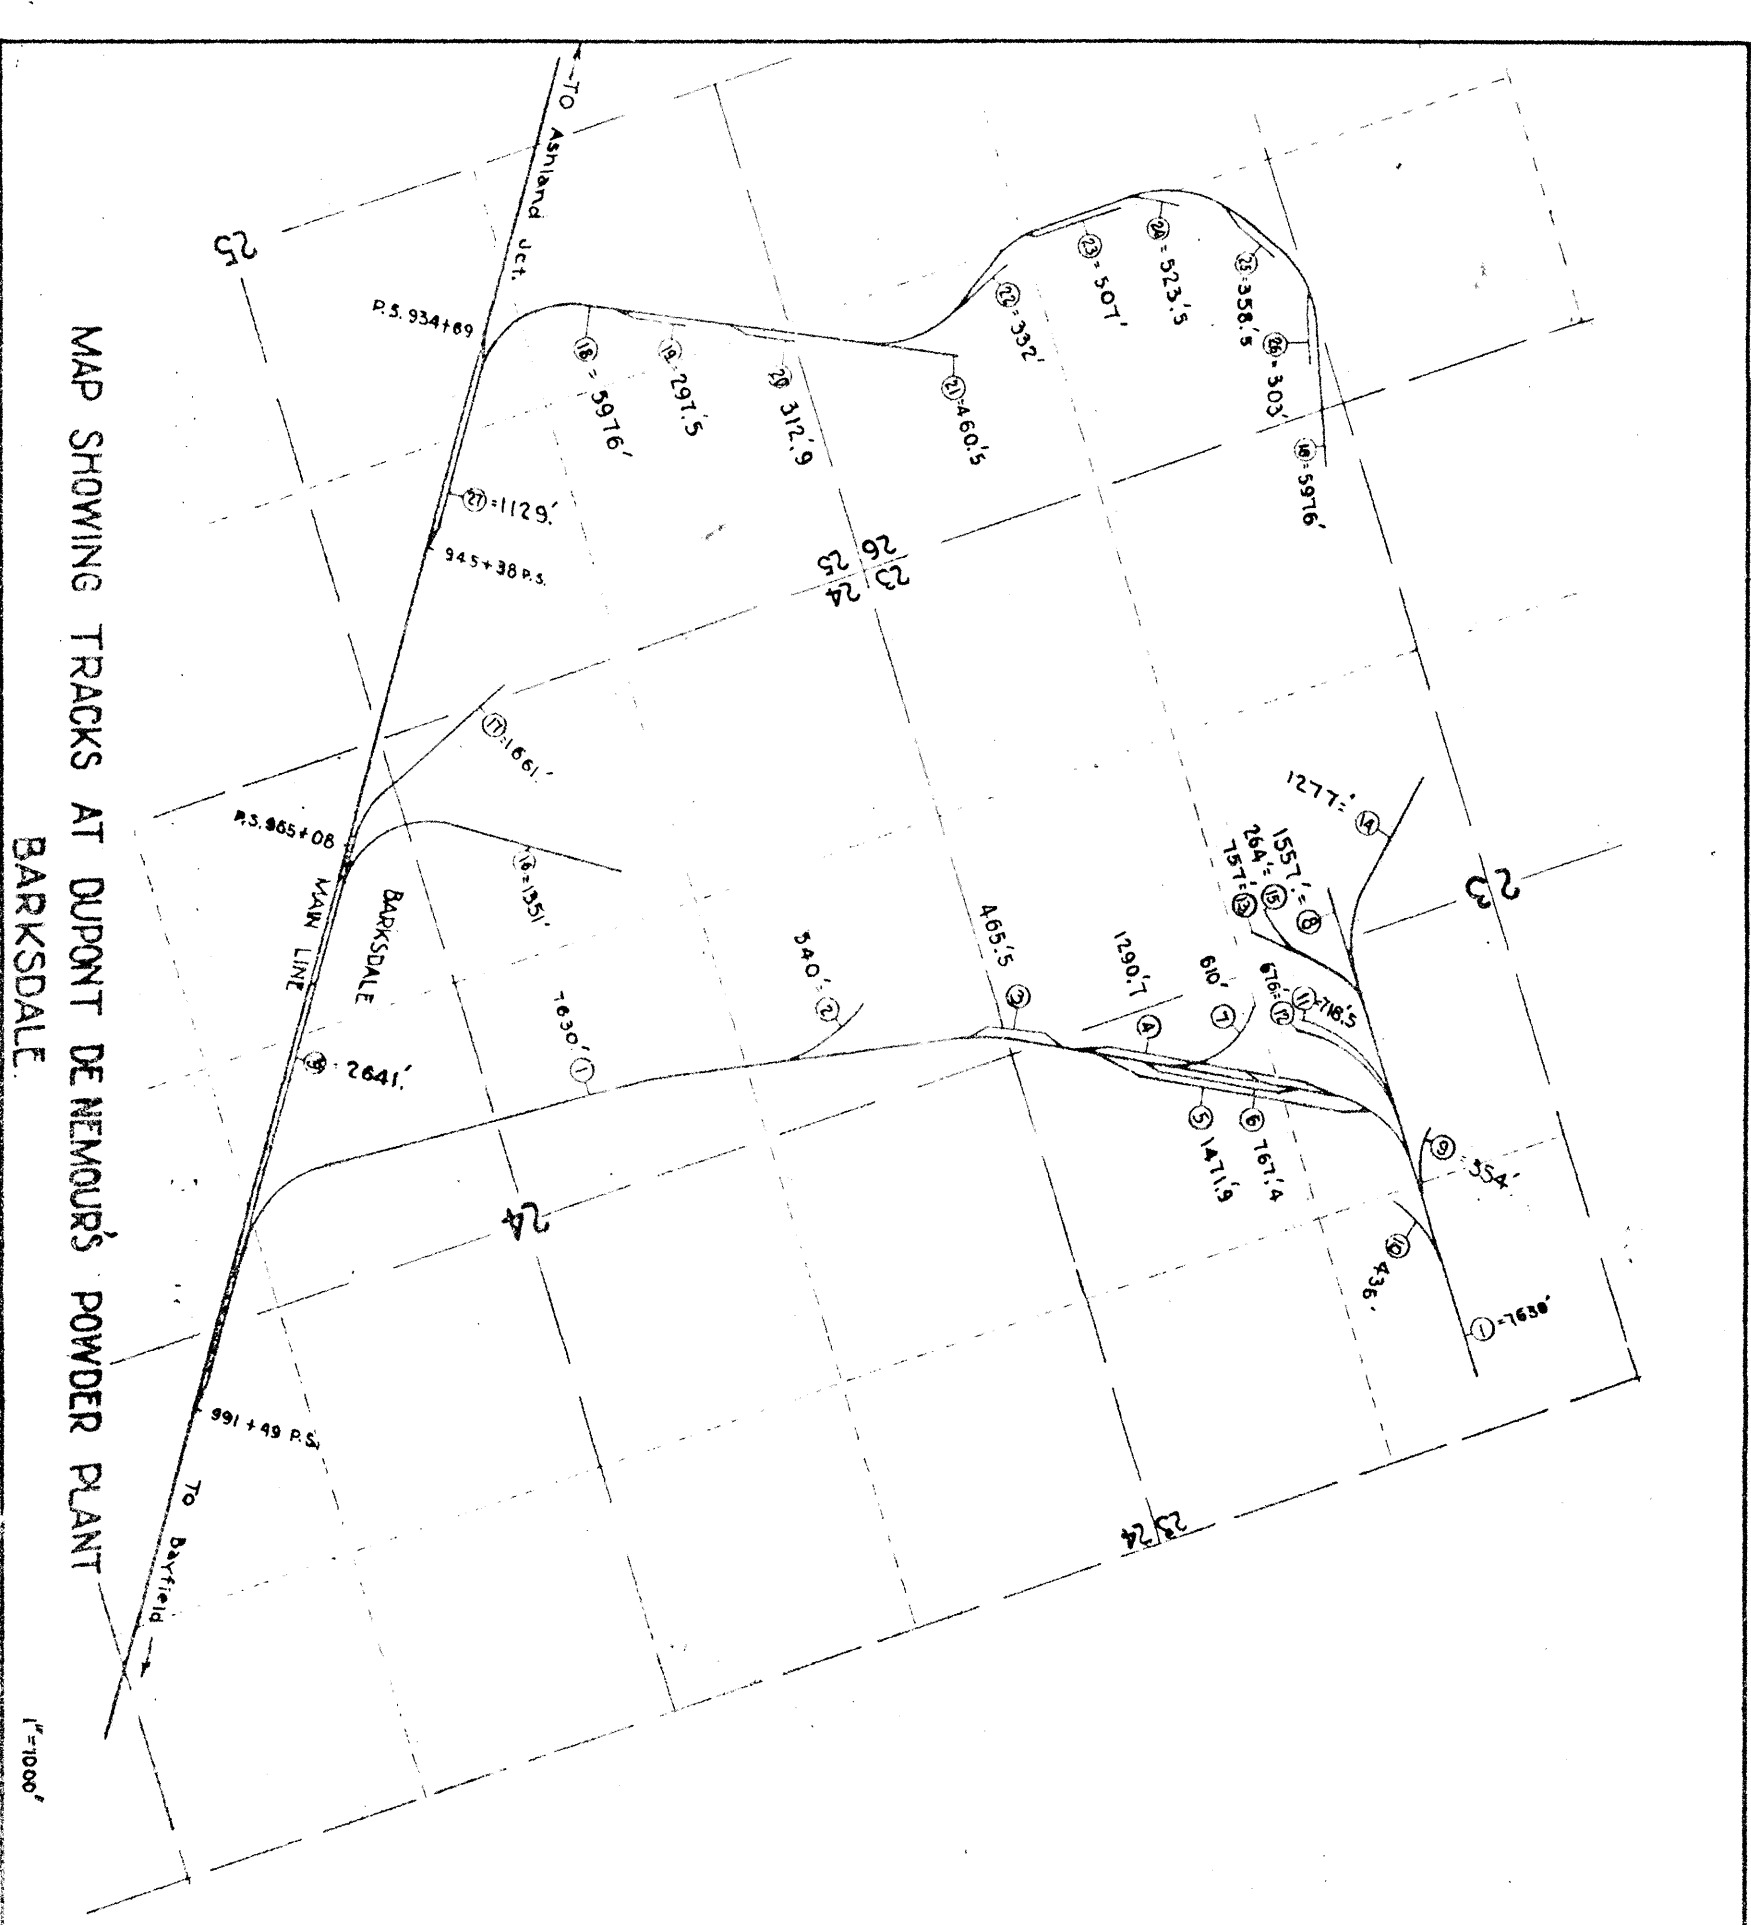

Pat. Ques.	Inst.	Date	Grantee	Grantee	Book	Page	Date	Area	Remarks
1	356	Aug. 15, 1883	Isaac H. Wing	C.S.P.M. & O. by Co.	6	671	Aug. 15, 1883	3.65	S.W. 1/4 S.E. 1/4
2	356	Dec. 1, 1882	Robinson D. Pike	"	Judg.	11	Feb. 67 to 110	2.07	N.W. 1/4 S.E. 1/4
3	356	Dec. 1, 1882	William D. Williams	"	Judg.	11	Feb. 67 to 110	5.29	Gov't Lots 1-2

RIGHT OF WAY AND TRACK MAP
CHICAGO ST. PAUL MINNEAPOLIS AND OMAHA RAILWAY CO.
NORTHERN DIVISION
TREGO, WIS. TO BAYFIELD, WIS.
OPERATED BY C. ST. P. M. & O. R. R. CO.
STATION 963+577 TO STATION 1174+992
SCALE: 1 IN. = 400 FT.
OFFICE OF CHIEF ENGINEER
ST. PAUL, MINN., JUNE 30, 1917