


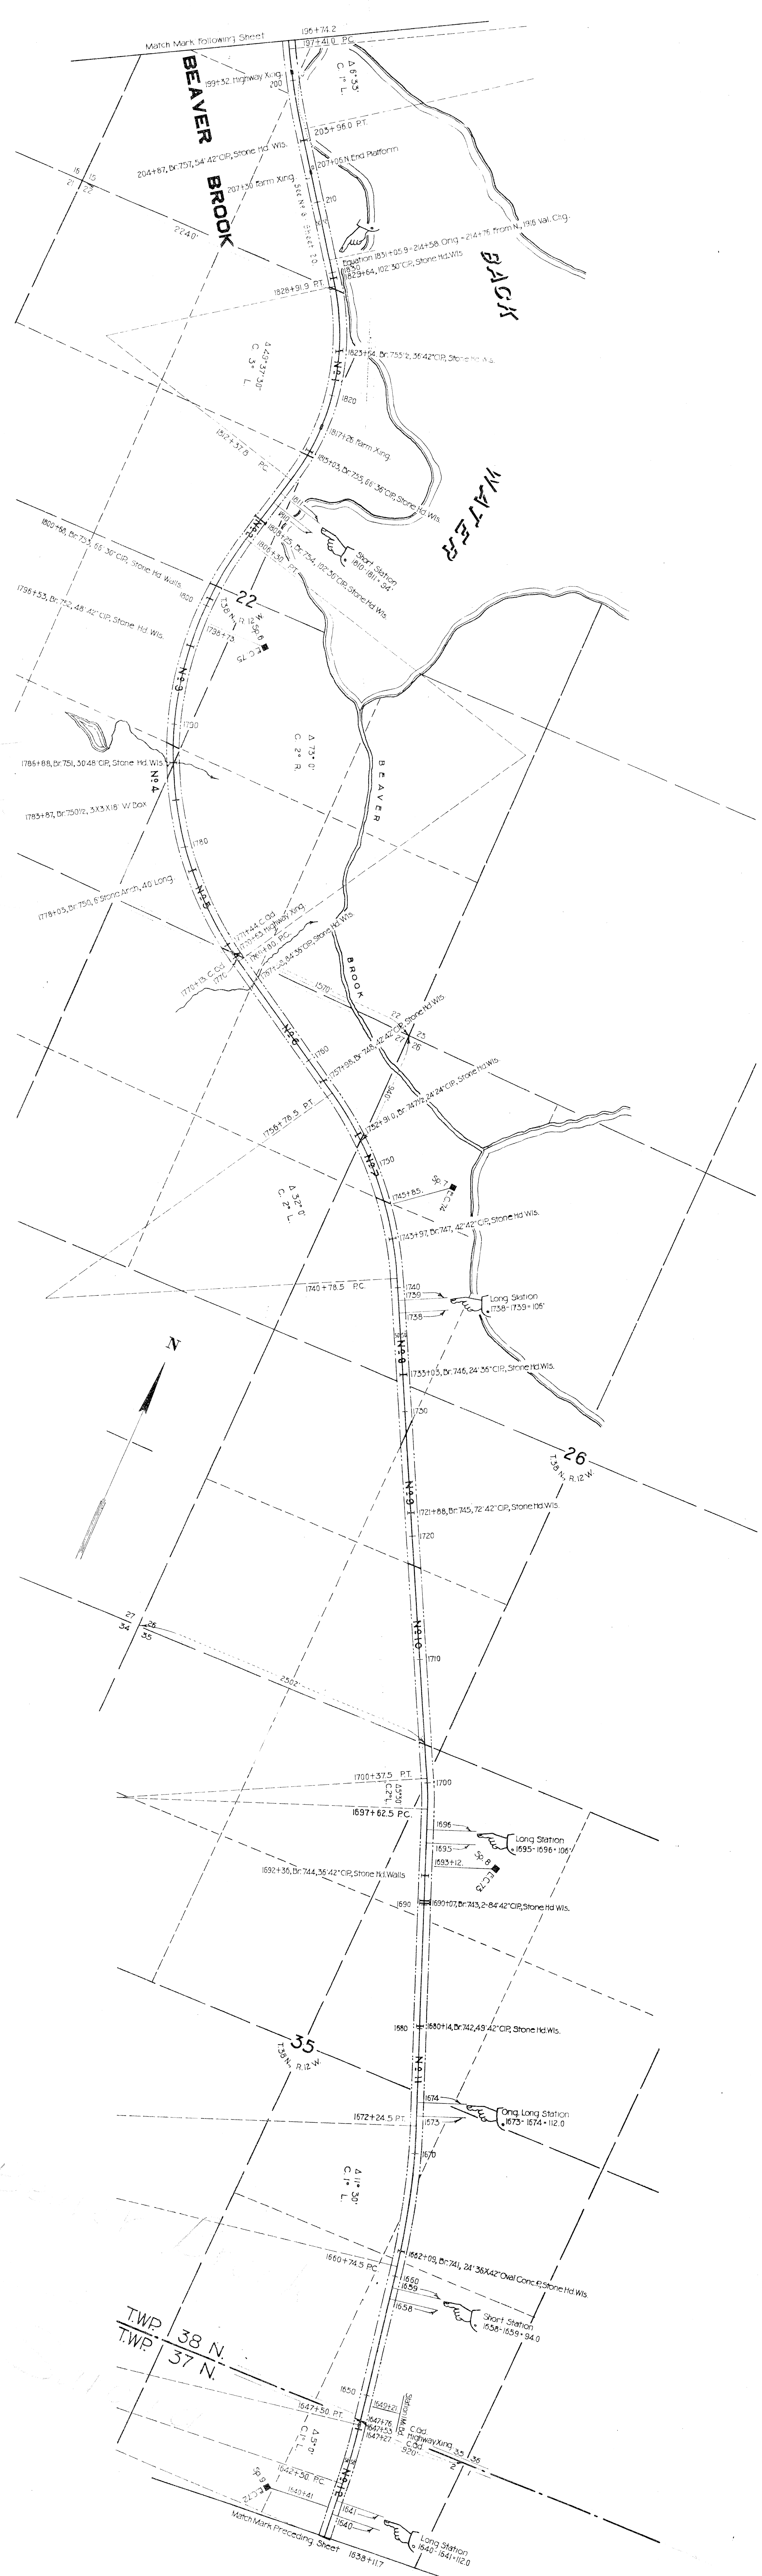

P.L. - Quarter Section		Instrument		Date		Station		Survey		R.R.C.O.D. Date		A.R.A. Date		Remarks	
1	1	Q. C. D.		Dec. 2, 1900		By Occupation		C. F. & K. Ry. Co.		1900		2.97		N.W. 1/4 Sec. 36, T. 38 N., R. 12 W.	
2	2	Q. C. D.		Mar. 24, 1893		By Occupation		C. F. & K. Ry. Co.		1900		3.07		S.W. 1/4 Sec. 36, T. 38 N., R. 12 W.	
3	3	Q. C. D.		Dec. 2, 1890		By Occupation		C. F. & K. Ry. Co.		1900		3.17		E.W. 1/4 Sec. 36, T. 38 N., R. 12 W.	
4	4	Q. C. D.		Jan. 4, 1901		By Occupation		C. F. & K. Ry. Co.		1900		4.12		S.E. 1/4 Sec. 36, T. 38 N., R. 12 W.	

RIGHT OF WAY AND TRACK MAP
CHICAGO, ST. PAUL, MINNEAPOLIS & OMAHA RAILWAY
NORTHERN DIVISION
EAU CLAIRE, WIS. TO SPOONER, WIS.
CREATED BY C. ST. P. M.A.O. EX. CO.
SCALE: 1 IN. = 100 FT.
DATE: 1907/7/2
OFFICE OF CHIEF ENGINEER
ST. PAUL, MINN.

