


ST LOUIS BAY

MINNESOTA
WISCONSIN

S
U
P
E
R
I
O
R
B
A
Y

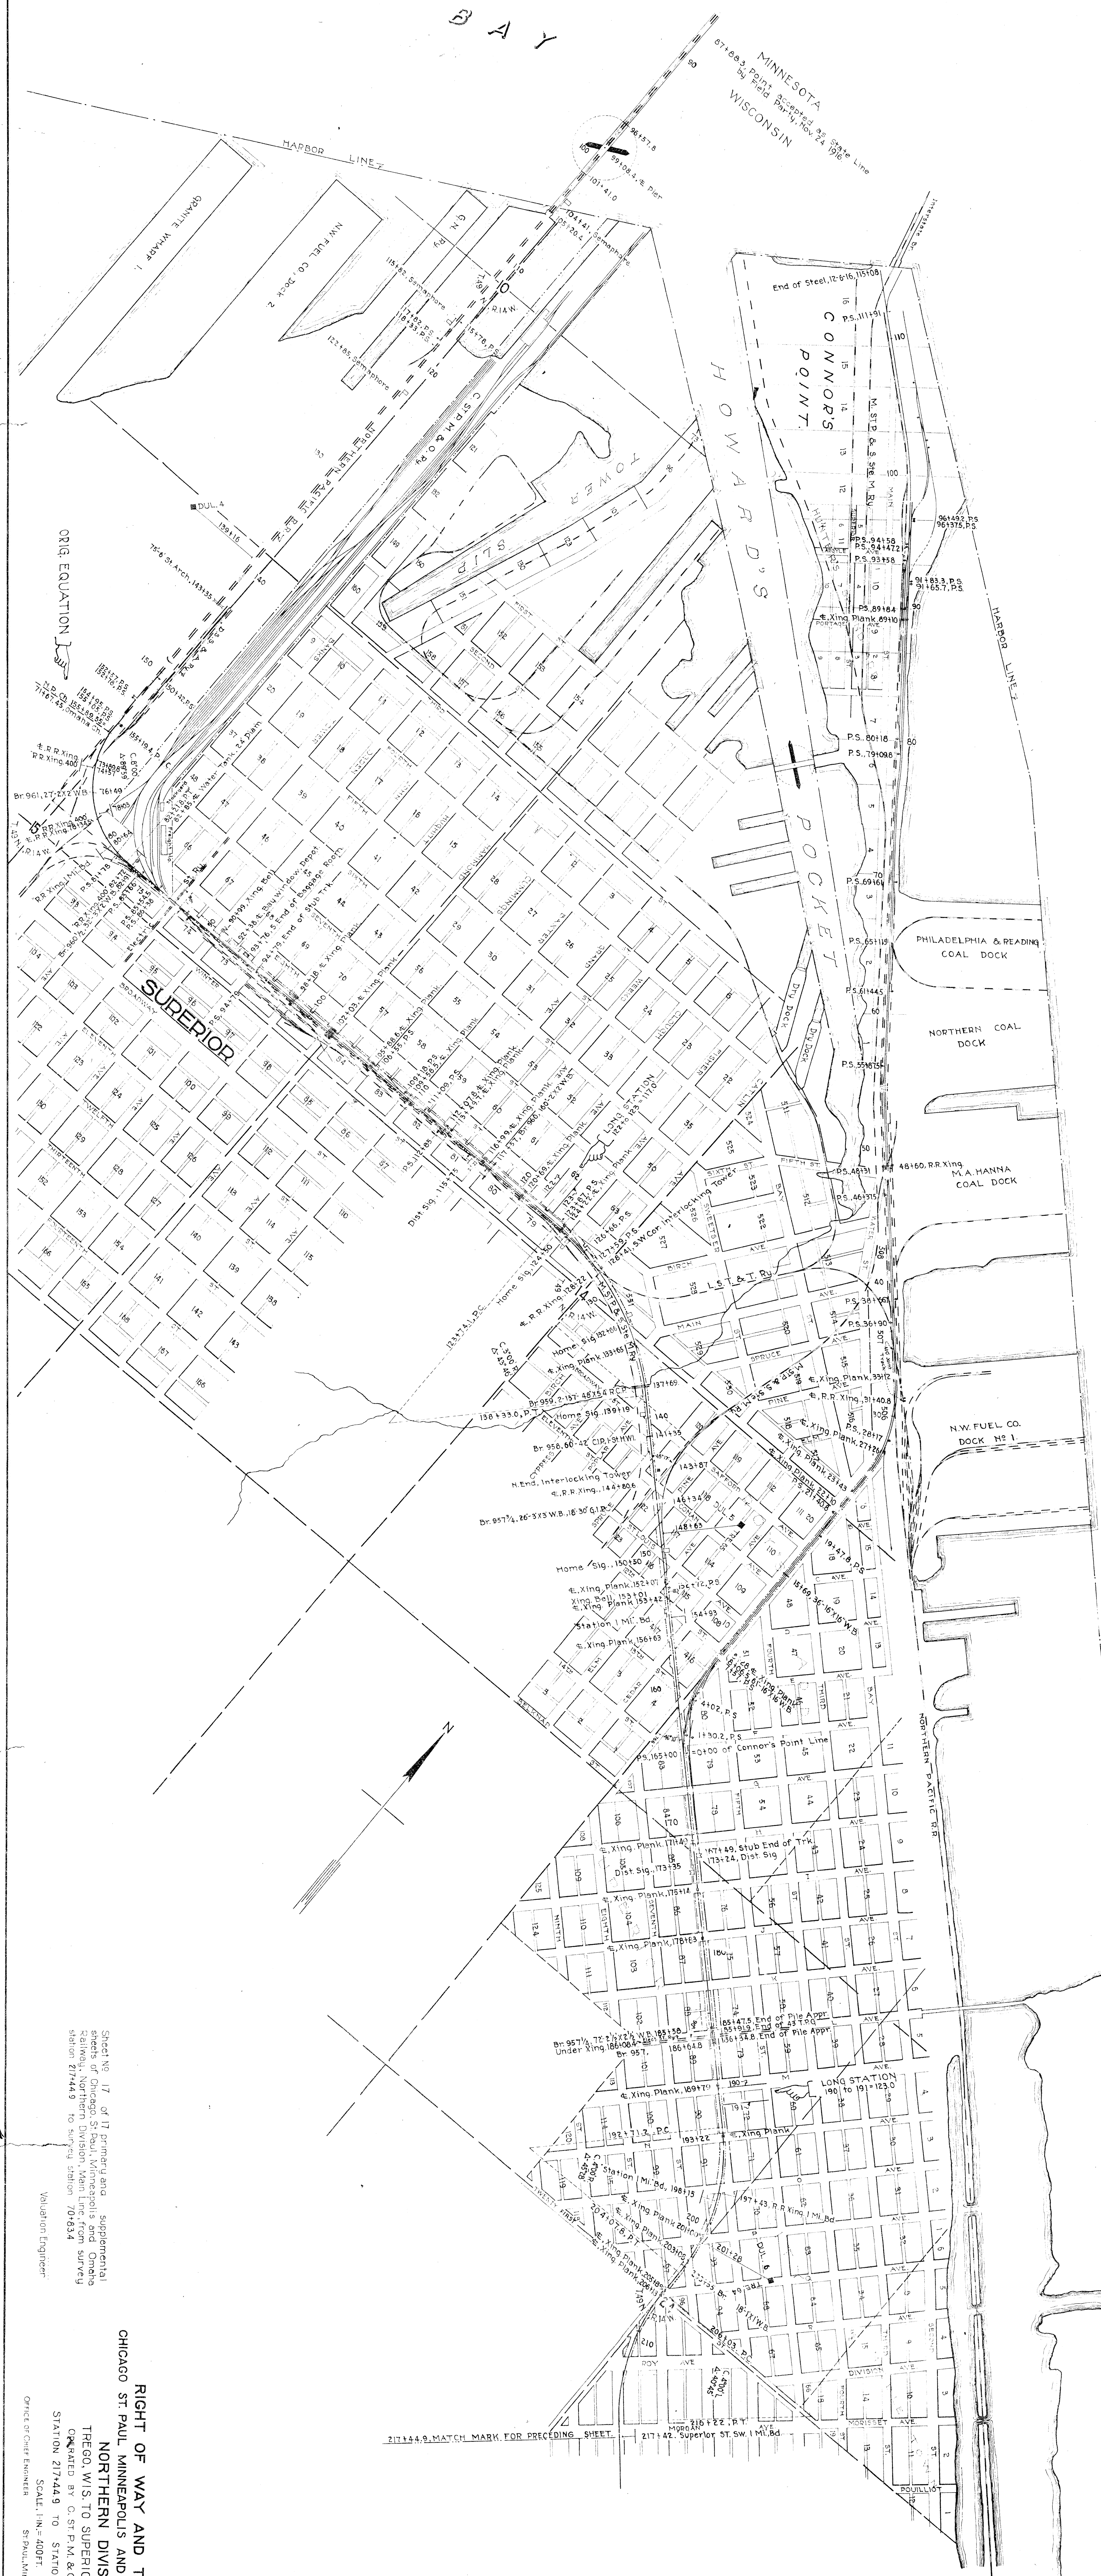

RIGHT OF WAY AND TRACK MAP
CHICAGO ST. PAUL MINNEAPOLIS AND OMAHA RAILWAY CO.
NORTHERN DIVISION

Sheet No. 17 of 17 primary and supplemental
plans of Chicago St. Paul, Minneapolis and Omaha
Railway, Northern Division, Main Line from survey
SCALE: 1"=400 FT.
ST. PAUL, MINN., JUNE 30, 1917

