


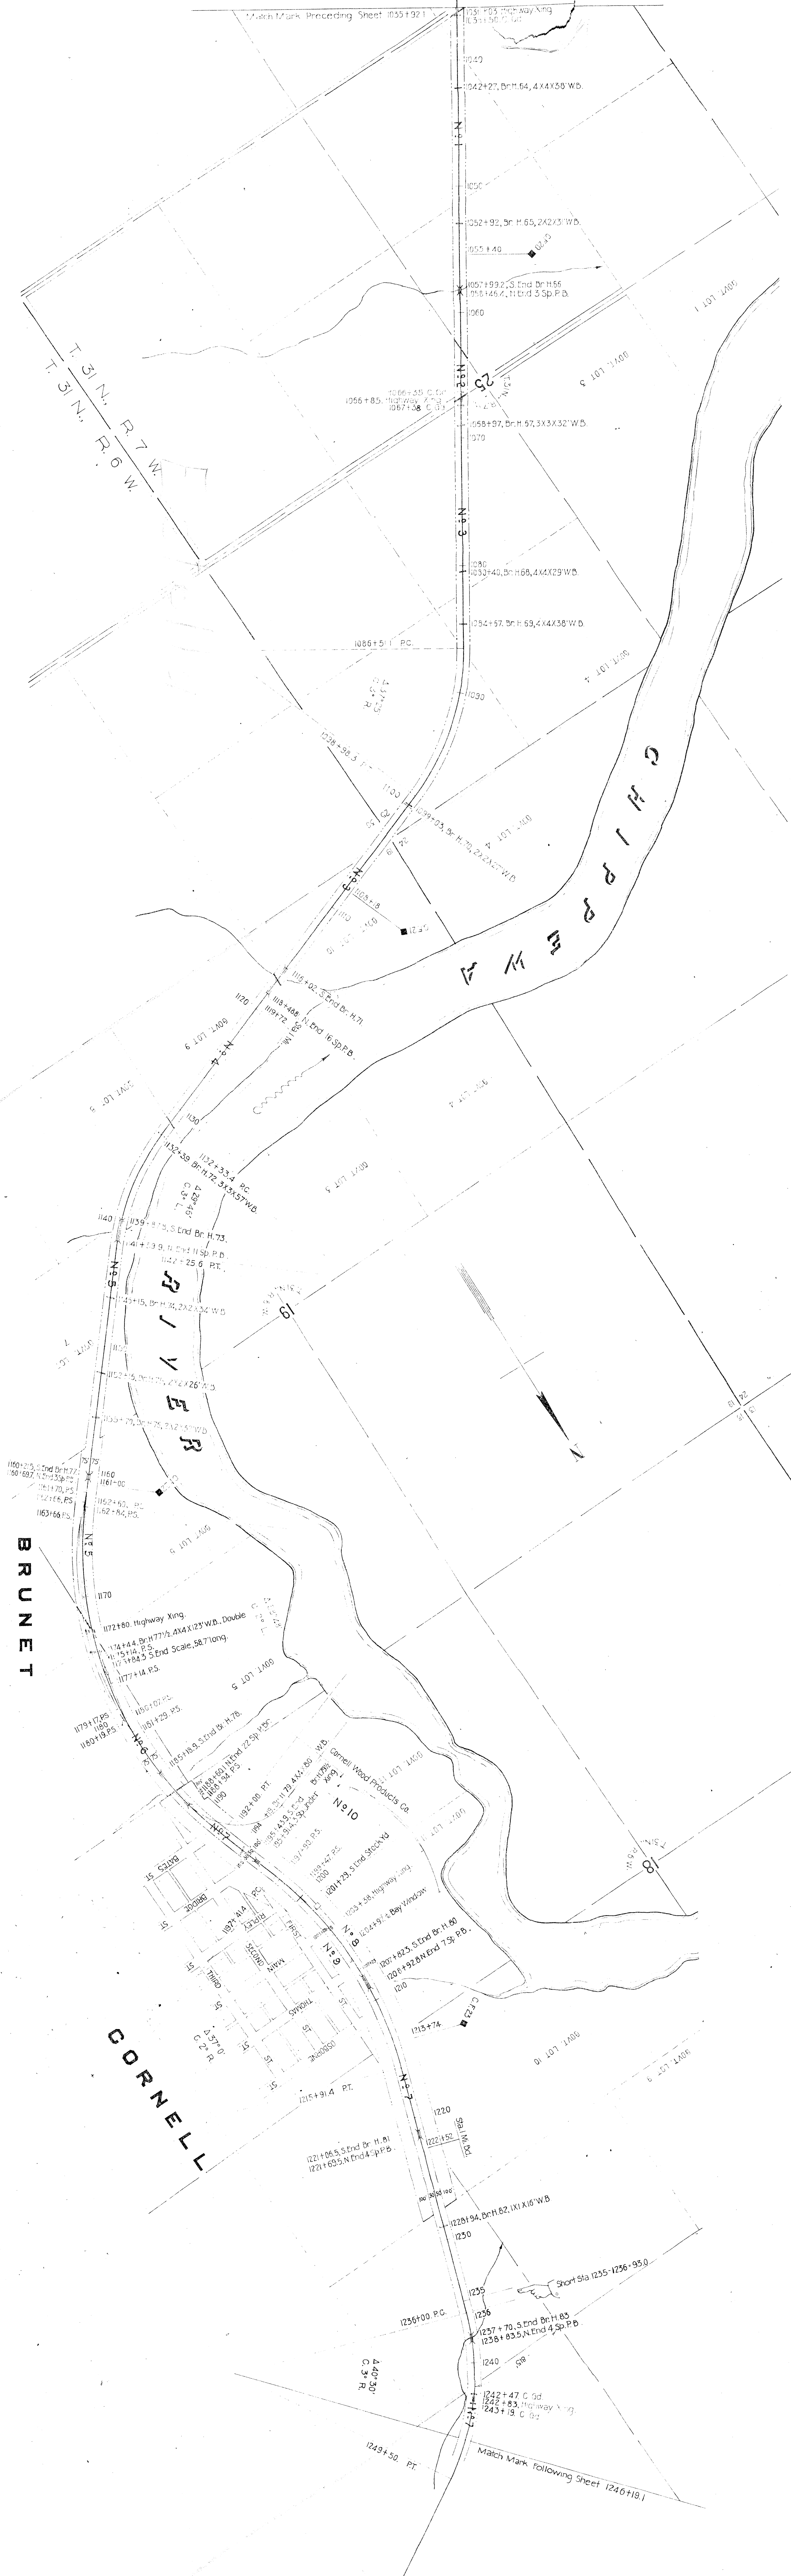

	Car. Quato- rel. Acute	Instrument	Date	Station	Gravities	HOA. LINE	DATE	ARR. STATION	REMARKS
1	6750	Warr. Ds.	Apr. 29, 1902	Cornell University & Power Co.	"	84	220 July 15, 1902	6.09	S.W. 1.
2	6768	Warr. Ds.	Apr. 29, 1902	H. L. Jew, et al.	"	84	220 July 15, 1902	8600	N.W. 1/4 S.E. 3.
3	6780	Warr. Ds.	Apr. 29, 1902	Cornell University & Power Co.	"	84	220 July 15, 1902	11.06	N.W. 1/4 N.W. 1.
4	6780	Warr. Ds.	Apr. 29, 1902	Cornell University & Power Co.	"	84	220 July 15, 1902	15.00	N.W. 1/4 N.W. 1.
5	6780	Warr. Ds.	Apr. 29, 1902	Cornell University & Power Co.	"	84	220 July 15, 1902	15.00	Gov't Lot 9.
6	6780	Warr. Ds.	Apr. 29, 1902	Cornell University & Power Co.	"	84	220 July 15, 1902	15.00	Gov't Lot 5, 6, 7, 8.
7	6780	Warr. Ds.	Apr. 29, 1902	Cornell University & Power Co.	"	84	220 July 15, 1902	14.87	S.W. 1/4 N.W. 1.
8	6780	Warr. Ds.	Apr. 29, 1902	Cornell University & Power Co.	"	84	220 July 15, 1902	14.82	Secs. 11, 16, 6, 7, 31 N. R. 6 W.
9	6780	Warr. Ds.	Apr. 29, 1902	Cornell University & Power Co.	"	84	220 July 15, 1902	9.31	Secs. 11, 16.
10	6804	Warr. Ds.	Jan. 1, 1903	Harriet Julia Wg. Co. C.S.P.M. Co. & Co.	"	84	220 July 15, 1902	9.31	Industrial tracks at Cornell.

RIGHT OF WAY AND TRACK MAP
CHICAGO, ST. PAUL, MINNEAPOLIS & OMAHA RAILWAY
OPERATED BY C. ST. P. M. & O. RY. CO.


Valuation Engineer

ST. PAUL, MINN.

SCALE: 1 IN. = 400 FT.

DATE: JUNE 30, 1917.

OFFICE OF CHIEF ENGINEER

ST. PAUL, MINN.

5