


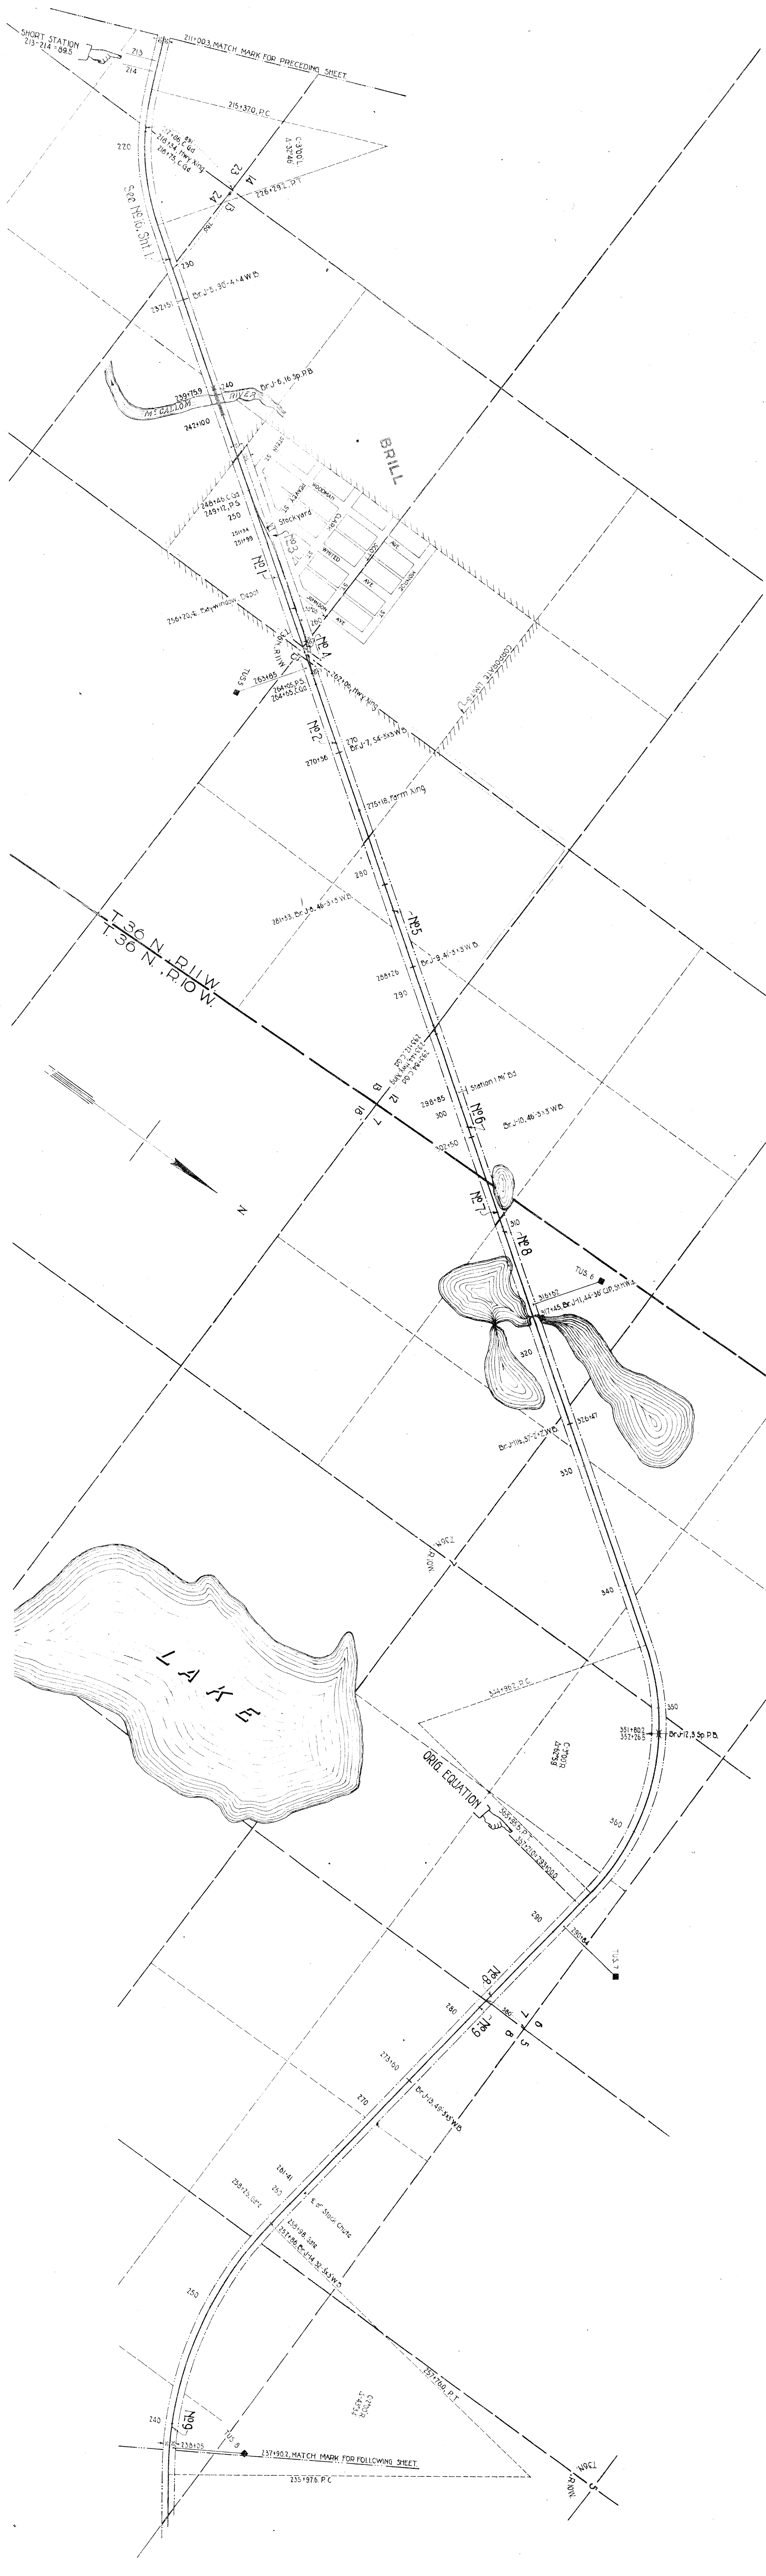

V.14 W.14, Sheet No. 2.										SCHEDULE OF PROPERTY.									
Particulars.										F. O. R. D. E. A. A. E. A. A.									
No.	Acres.	Inst.	Date.	Grantor.	Grantee.	Book.	Page.	Date.	Acres.	St. L.	Remarks.								
1	6839	Warr. De.	Jul. 6, 1901	Ellen Monroe	Chicago Valley & N. W. Ry. Co.	27	141	Aug. 2, 1901	3.40		N. E. 1/4 Sec. 11, T. 36 N., R. 10 W.								
2	"	"	"	"	"	"	"	"	"		S. E. 1/4 Sec. 11, T. 36 N., R. 10 W.								
3	8287	Q. C. De.	Aug. 30, 1900	Chas. O. Childs	C. V. & N. W. Ry. Co.	27	395	Sept. 27, 1901	2.50		S. E. 1/4 Sec. 11, T. 36 N., R. 10 W.								
4	6834	Condemnation	Jul. 6, 1901	P. M. Parker, et al	"	27	246	Oct. 19, 1901	2.00		S. E. 1/4 Sec. 11, T. 36 N., R. 10 W.								
5	6835	Warr. De.	Aug. 31, 1901	Felix Bailey	"	27	241	Oct. 19, 1901	2.92		S. E. 1/4 Sec. 11, T. 36 N., R. 10 W.								
6	7918	Patent	Dec. 19, 1874	State of Wisconsin	North Wisconsin Ry.	14	494	Aug. 8, 1901	31.00		S. W. 1/4 Sec. 11, T. 36 N., R. 10 W.								
7	6665	Warr. De.	May 13, 1901	The Knapp-Stout & Co.	"	17	488	May 17, 1901	15.76		S. E. 1/4 Sec. 11, T. 36 N., R. 10 W.								
8	6664	Warr. De.	May 24, 1901	William J. Starr	"	27	45	Nov. 21, 1901	11.44		S. E. 1/4 Sec. 11, T. 36 N., R. 10 W.								

Sheet No. 2 of 16 sheets of Chicago, St. Paul, Minneapolis and Omaha Railway Co. Division, Park, from Survey Station 211+00.3 to 237+90.2.

RIGHT OF WAY AND TRACK MAP
CHICAGO ST. PAUL MINNEAPOLIS AND OMAHA RAILWAY CO.
NORTHERN DIVISION
TUSCOBIA, WIS. TO PARK FALLS, WIS.
OPERATED BY C. ST. P. & M. & O. CO.
STATION 211+00.3 TO STATION 237+90.2
SCALE, 1 IN. = 400 FT.
OFFICE OF CHIEF ENGINEER, ST. PAUL, MINN.
1910.