


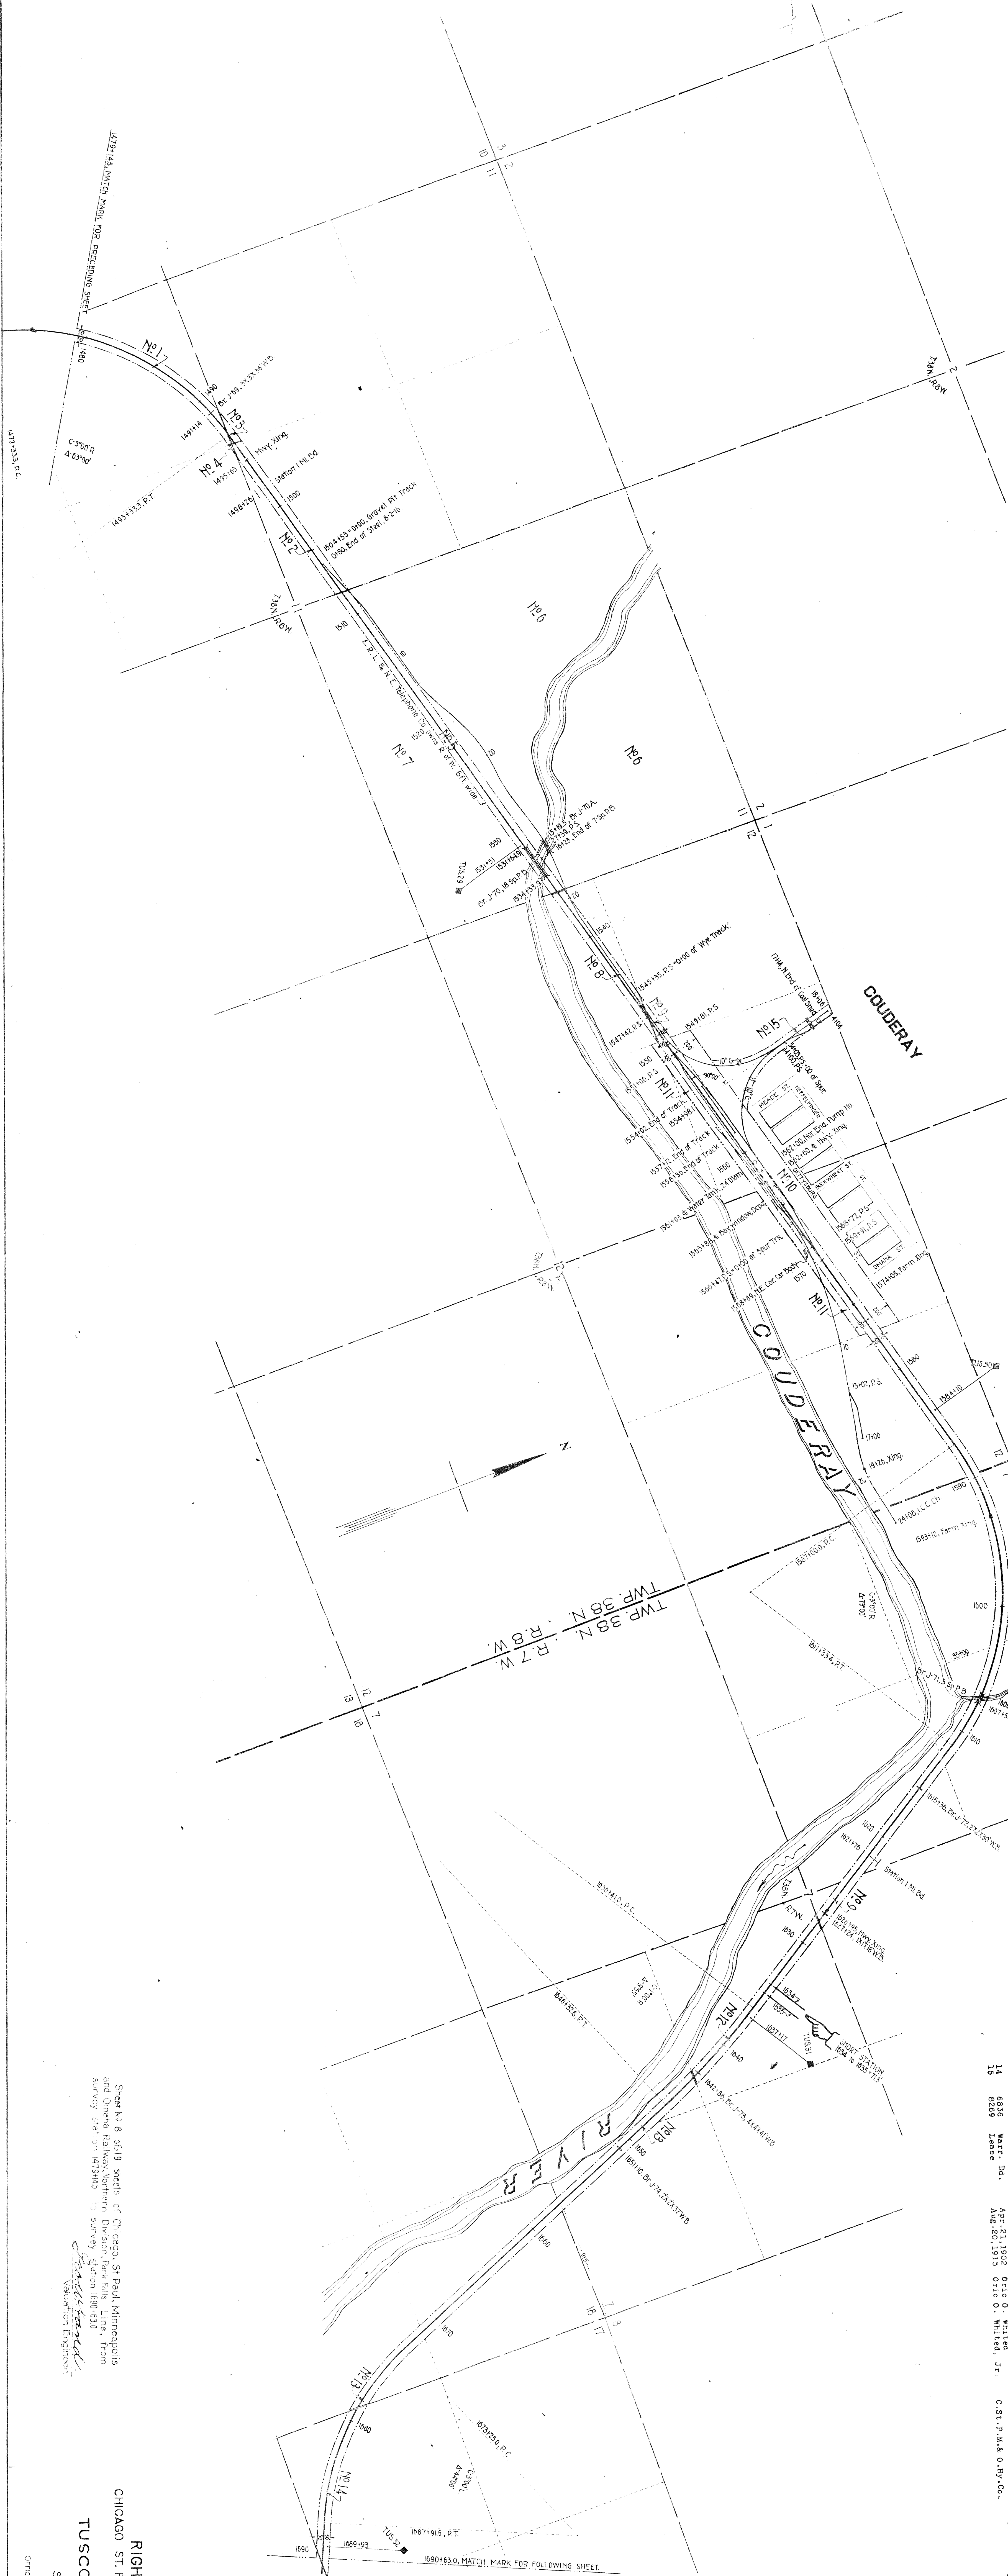

V.14 W.1, Sheet No. 6.

SCHEDULE OF PROPERTY.

Pat. Cuto- col. dant's	Instrument	Date	Grantor	Grantee	Book	Page	Area Acres	Remarks
1	6686 A. Warr. Da.	Dec. 10, 1901	John Arpin Lumber Co.	Chipp. Valley & N.W. Ry. Co.	20	623	3.95	N.W. 1/4 S.W. 1/4
2	"	"	"	"	"	"	3.14	S.W. 1/4 N.W. 1/4
3	6683 Warr. Da.	Apr. 19, 1902	Chippewa Farm Land Co.	"	23	66	10.90	S.W. 1/4 N.W. 1/4
4	6687 Q. C. Da.	Dec. 2, 1901	Daniel Shaw Lumber Co.	"	20	213	6.39	S.W. 1/4 N.W. 1/4
5	6687 Q. C. Da.	Aug. 26, 1909	E. C. Blundell	"	20	213	114.56	S.W. 1/4 N.W. 1/4
6	6687 Q. C. Da.	Dec. 16, 1901	John Arpin Lumber Co.	"	20	623	36.57	S.W. 1/4 N.W. 1/4
7	6685 A. Warr. Da.	Apr. 19, 1902	Chippewa Farm Land Co.	"	23	66	10.47	S.W. 1/4 N.W. 1/4


Valuation Engineer.

RIGHT OF WAY AND TRACK MAP
CHICAGO ST. PAUL, MINNEAPOLIS AND OMAHA RAILWAY CO.
NORTHERN DIVISION
TUSCOBIAWIS, TO PARK FALLS, WIS.
OPERATED BY C.S.P.M. & O.R.Y.CO.

SCALE 1 IN. = 400 FT.

OFFICE OF CHIEF ENGINEER, ST. PAUL, MINN., 1916.