


MIQHQA M

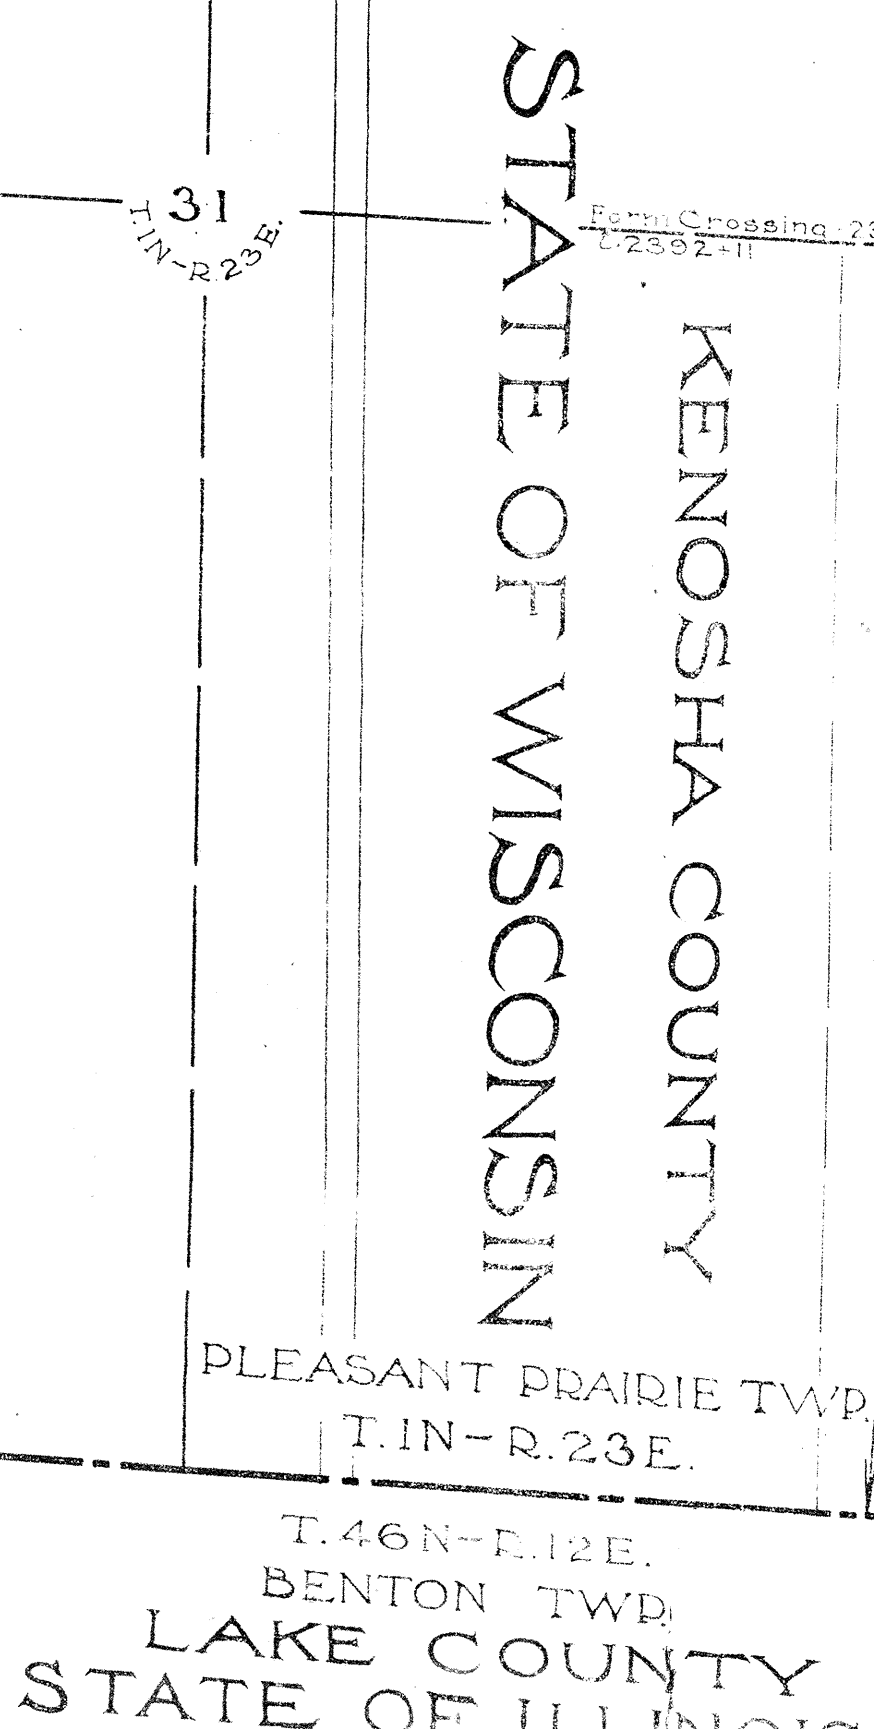










Sheet No. 1 of 9 Primary sheet
and 31 supplemental sheets
of C. & N.W. 1/4 from survey
station 236952.4 to survey station 2571

Valuation Engineer

RIGHT OF WAY AND TRACK MAP
CHICAGO AND NORTH-WESTERN RAILWAY.
OPERATED BY THE
C. & N.-W. RY. CO.
WISCONSIN DIVISION
L.-WIS. STATE LINE to MILWAUKEE, W
STA. 2365+52.4 TO STA. 2575+85
SCALE: 1 IN. = 400 FT.

WIS.