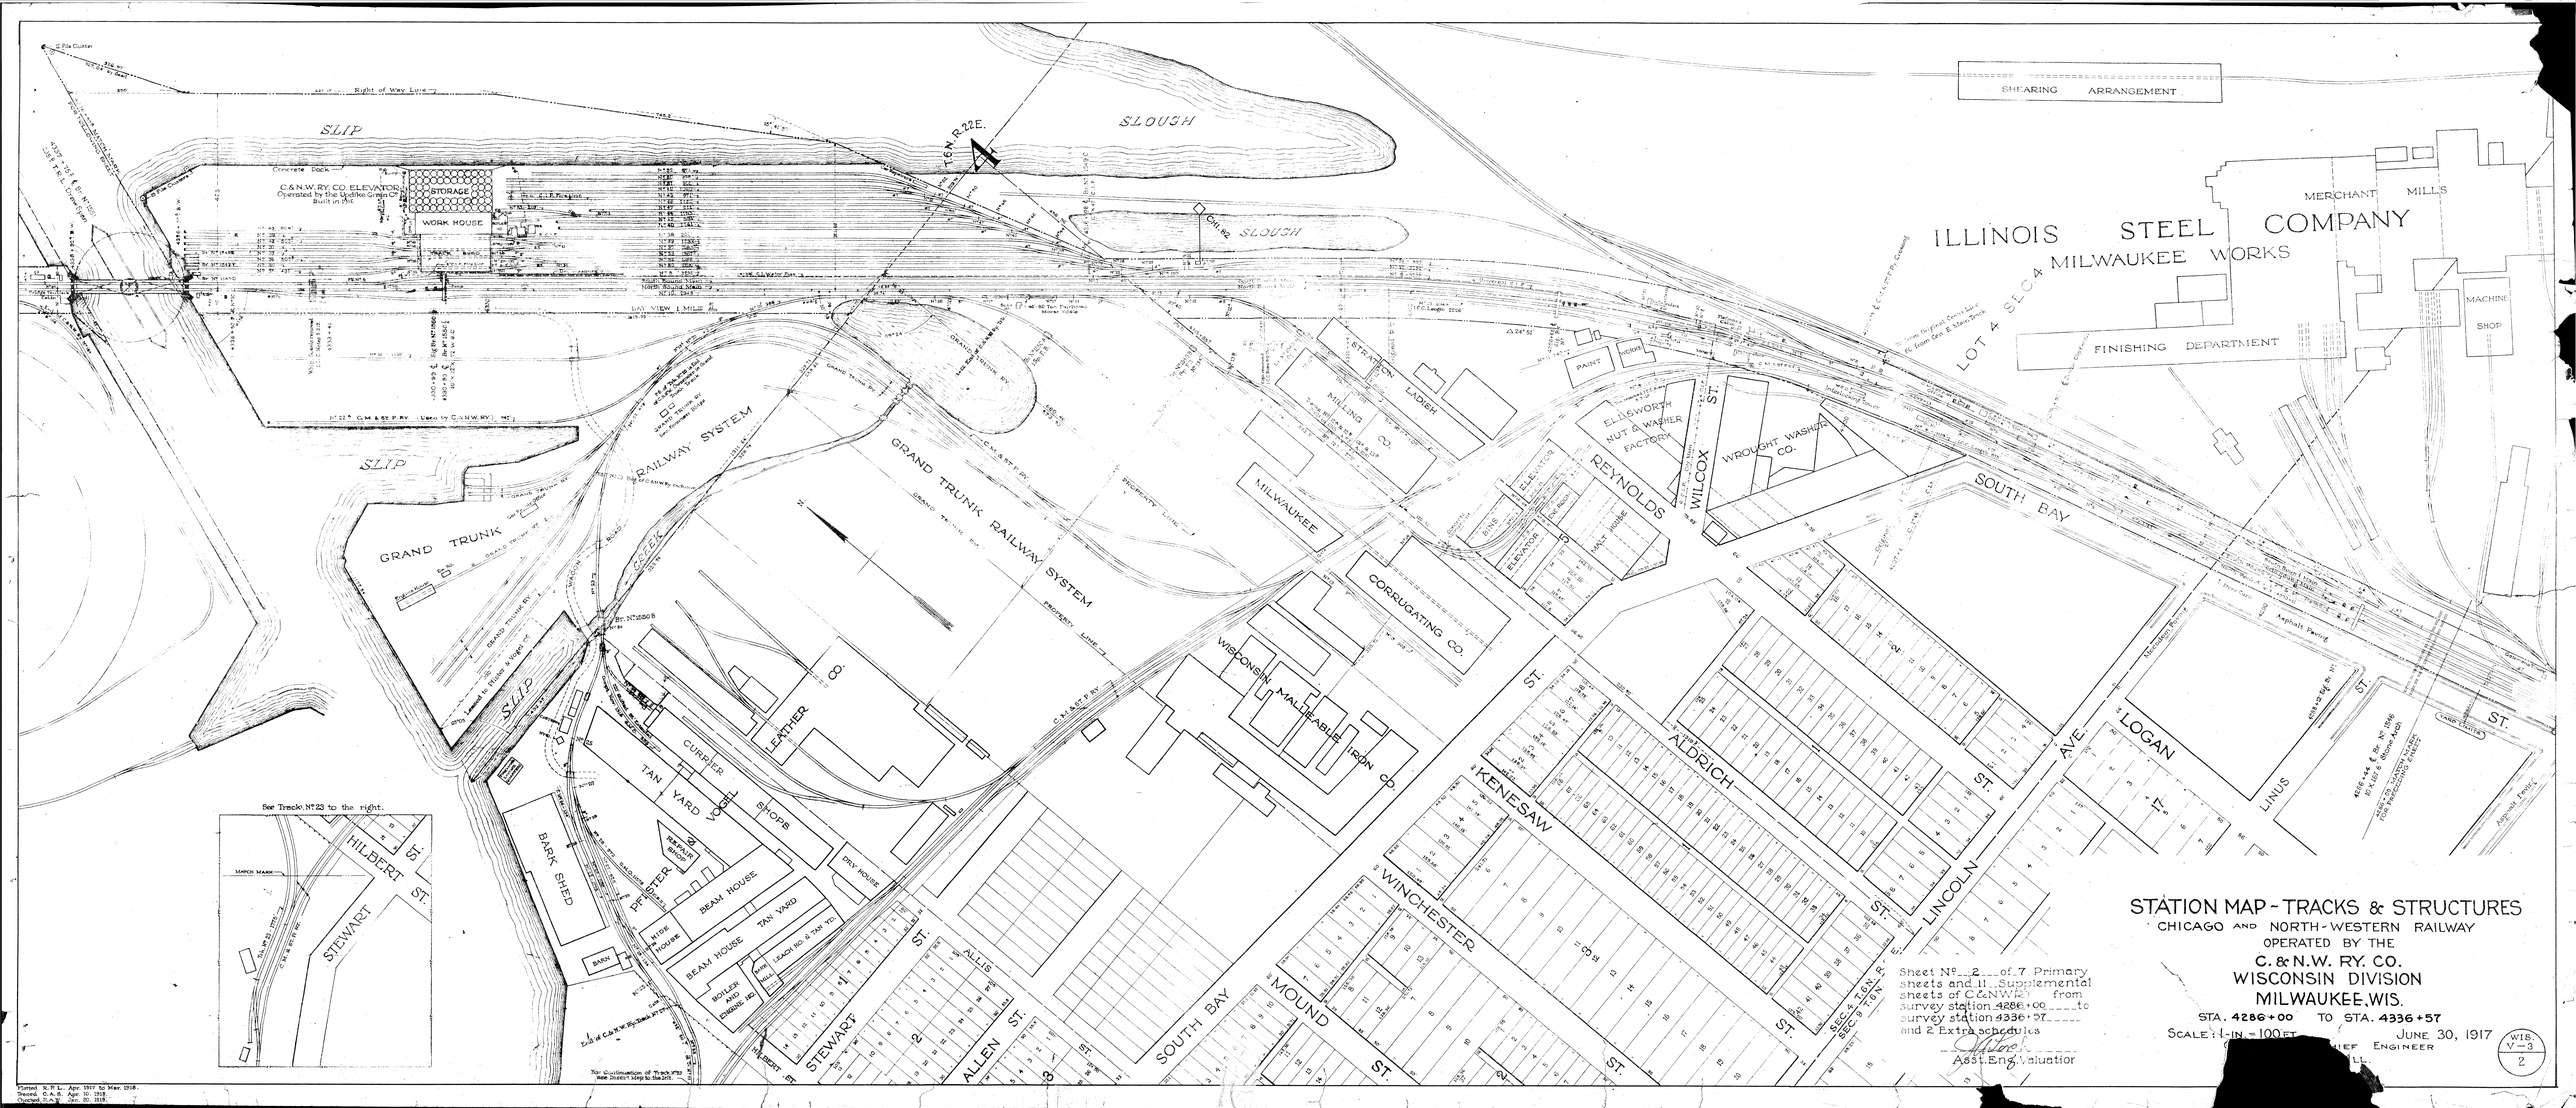
SHEARING ARRANGEMENT
SLIP
SLOUGH
T.6 N. R.22 E.
Ch. 62 SLOUGH
C.&N.W.RY.CO. ELEVATOR
Operated by the Lyndhus Grain Co.
Built in 1912
STORAGE
WORK HOUSE
Concrete Dock
Right of Way Line
BAY VIEW 1 MILE
ILLINOIS STEEL COMPANY
MILWAUKEE WORKS
MERCHANT MILLS
MACHINE SHOP
FINISHING DEPARTMENT
LOT 4 SEC 4
GRAND TRUNK RAILWAY SYSTEM
GRAND TRUNK
CREEK
STRAIN LADISH MILLING CO.
PAINT SHOP
ELLISWORTH NUT & WASHER FACTORY
WROUGHT WASHER CO.
WILCOX ST.
REYNOLDS
ELEVATOR
BINS
WAIT HOUSE
MILWAUKEE
CORRUGATING CO.
WISCONSIN MALLEABLE IRON CO.
LEATHER CO.
CURRIER
TAN YARD
WOOL SHOPS
REPAIR SHOP
BARK SHED
DRY HOUSE
BEAM HOUSE
BOILER AND ENGINE HO.
BARN
SOUTH BAY
ALDRICH ST.
KENESAW
WINCHESTER
MOUND ST.
LINCOLN ST.
LOGAN AVE.
LINUS
STEWART ST.
ALLEN ST.
HILBERT ST.
See Tracks Nº 23 to the right.
MARCH MARK
Asphalt Paving
Macadam Paving
Cobble Pav. St.
Asphalt Curb
Sheet Nº 2 of 7 Primary sheets and 11 Supplemental sheets of C&NWRY from survey station 4286+00 to survey station 4336+57 and 2 Extra schedules
Asst. Eng. Valuation
STATION MAP - TRACKS & STRUCTURES
CHICAGO AND NORTH-WESTERN RAILWAY
OPERATED BY THE
C. & N.W. RY. CO.
WISCONSIN DIVISION
MILWAUKEE, WIS.
STA. 4286+00 TO STA. 4336+57
SCALE: 1-IN. = 100 FT.
JUNE 30, 1917
CHIEF ENGINEER
WIS. V-3 2
Plotted: R. P. L., Apr. 1917 to Mar. 1918.
Traced: C. A. S., Apr. 10, 1918.
Checked: H. A. B., Apr. 10, 1918.