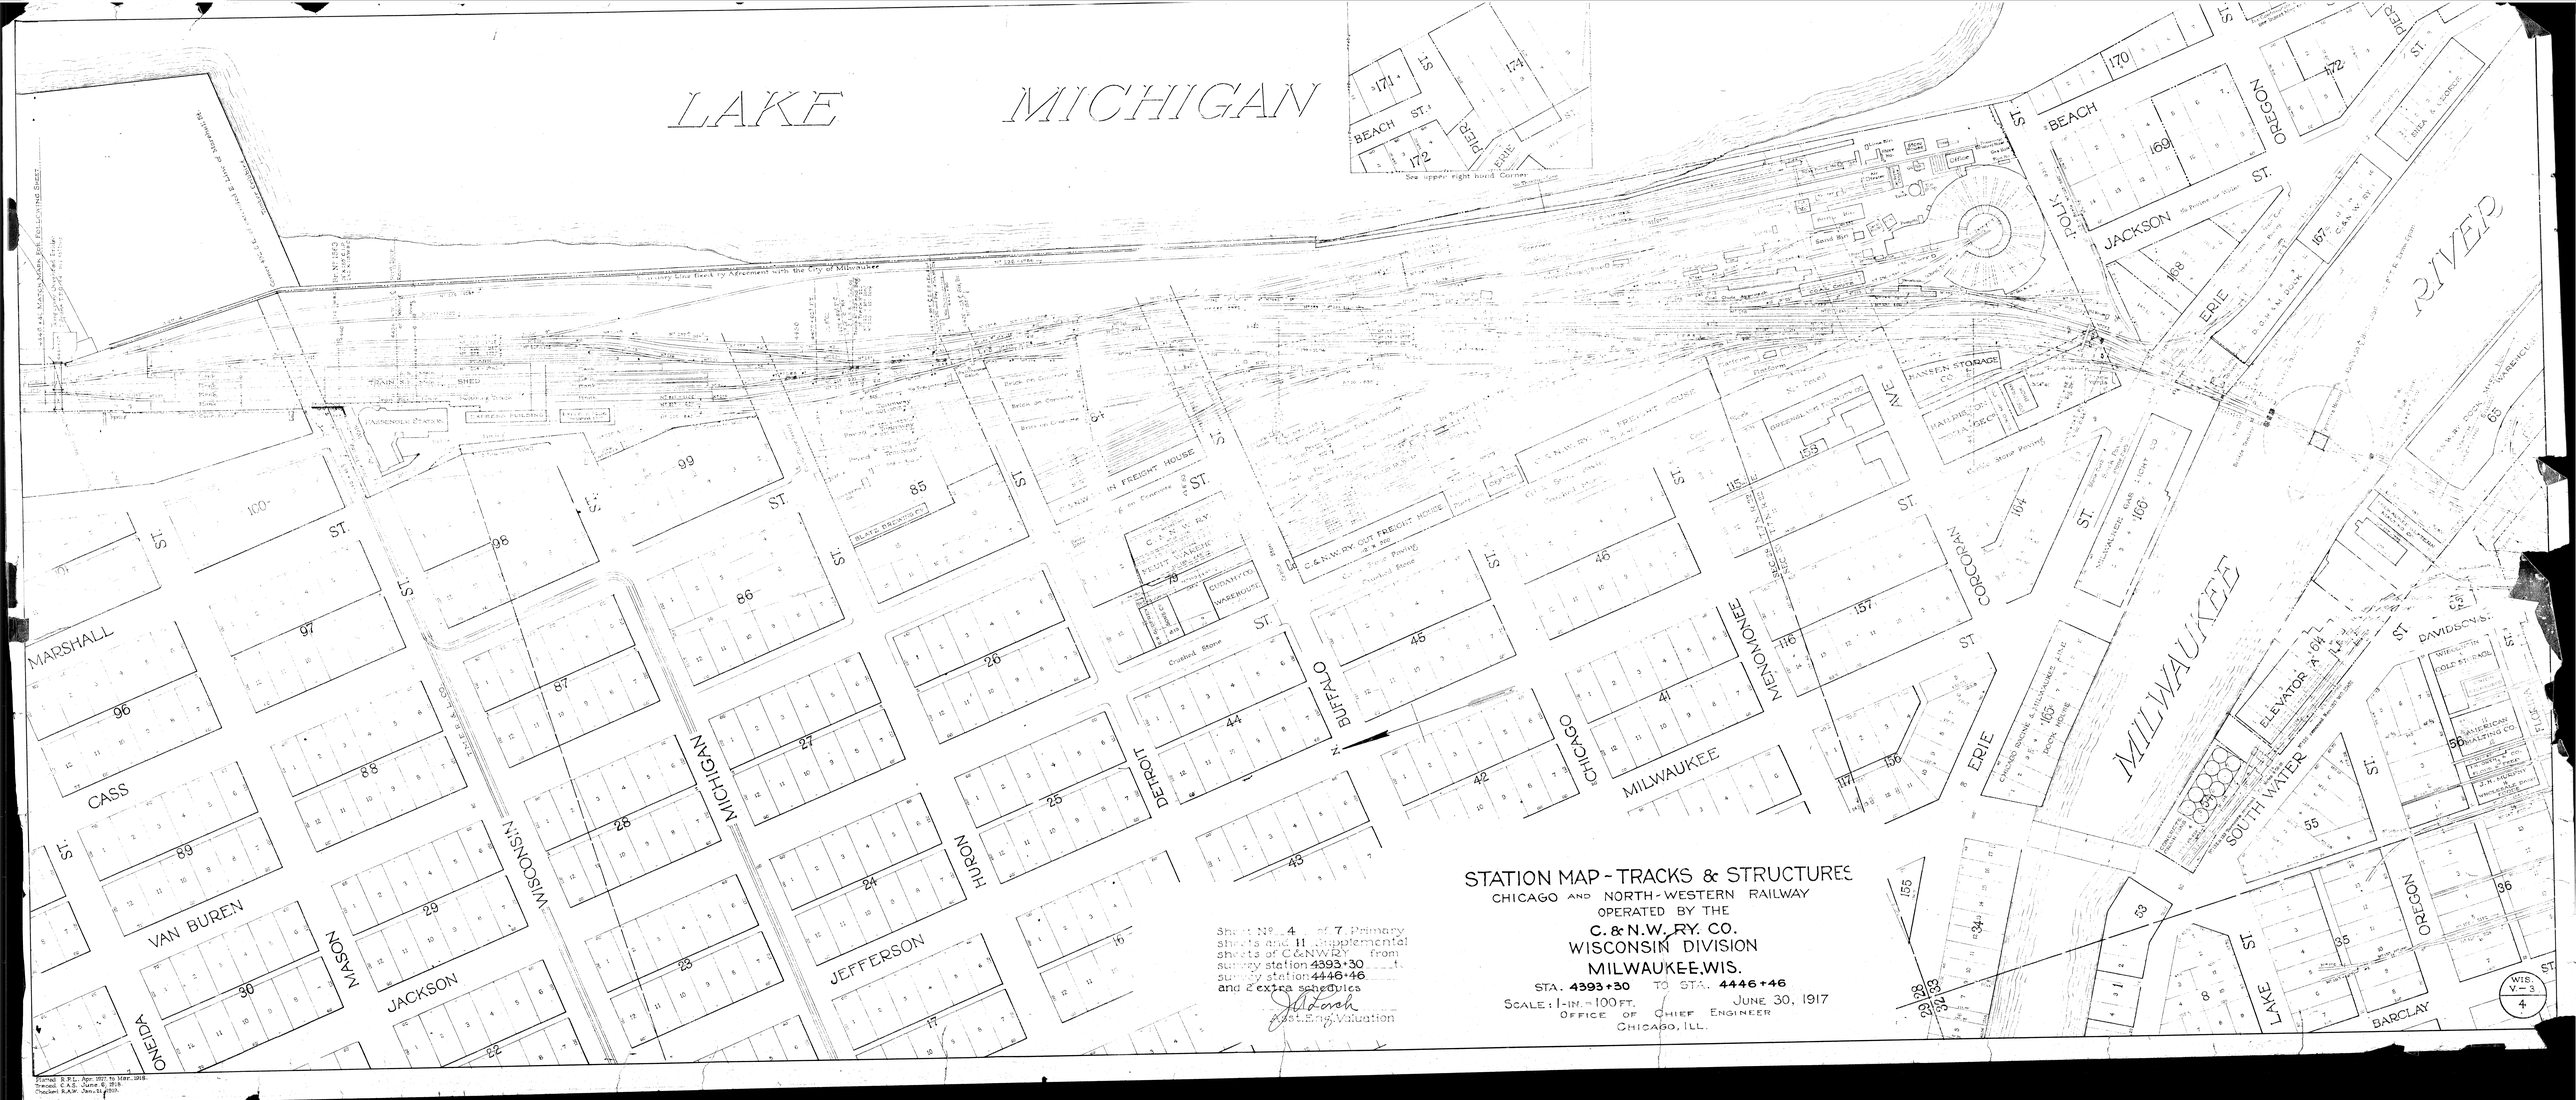
LAKE MICHIGAN
RIVER
MILWAUKEE
MARSHALL
CASS
VAN BUREN
JACKSON
ONEIDA
MASON
WISCONSIN
MICHIGAN
HURON
JEFFERSON
DETROIT
BUFFALO
CHICAGO
MENOMONEE
ERIE
OREGON
BEACH
POLK
SOUTH WATER
DAVIDSON
BARCLAY
LAKE
CORCORAN
MILWAUKEE
STATION MAP - TRACKS & STRUCTURES
CHICAGO AND NORTH-WESTERN RAILWAY
OPERATED BY THE
C. & N.W. RY. CO.
WISCONSIN DIVISION
MILWAUKEE, WIS.
STA. 4393+30 TO STA. 4446+46
SCALE: 1-IN. = 100 FT. JUNE 30, 1917
OFFICE OF CHIEF ENGINEER
CHICAGO, ILL.
Sheet No. 4 of 7 Primary sheets and 11 supplemental sheets of C&NW Ry. from survey station 4393+30 to survey station 4446+46 and 2 extra schedules
Asst. Engr. Valuation
See upper right hand Corner
Planned D.R.L. Apr. 1917 to Mar. 1918.
Traced C.A.B. June 6, 1918.
Checked R.A.W. Jan. 11, 1921.
WIS V-3 4