



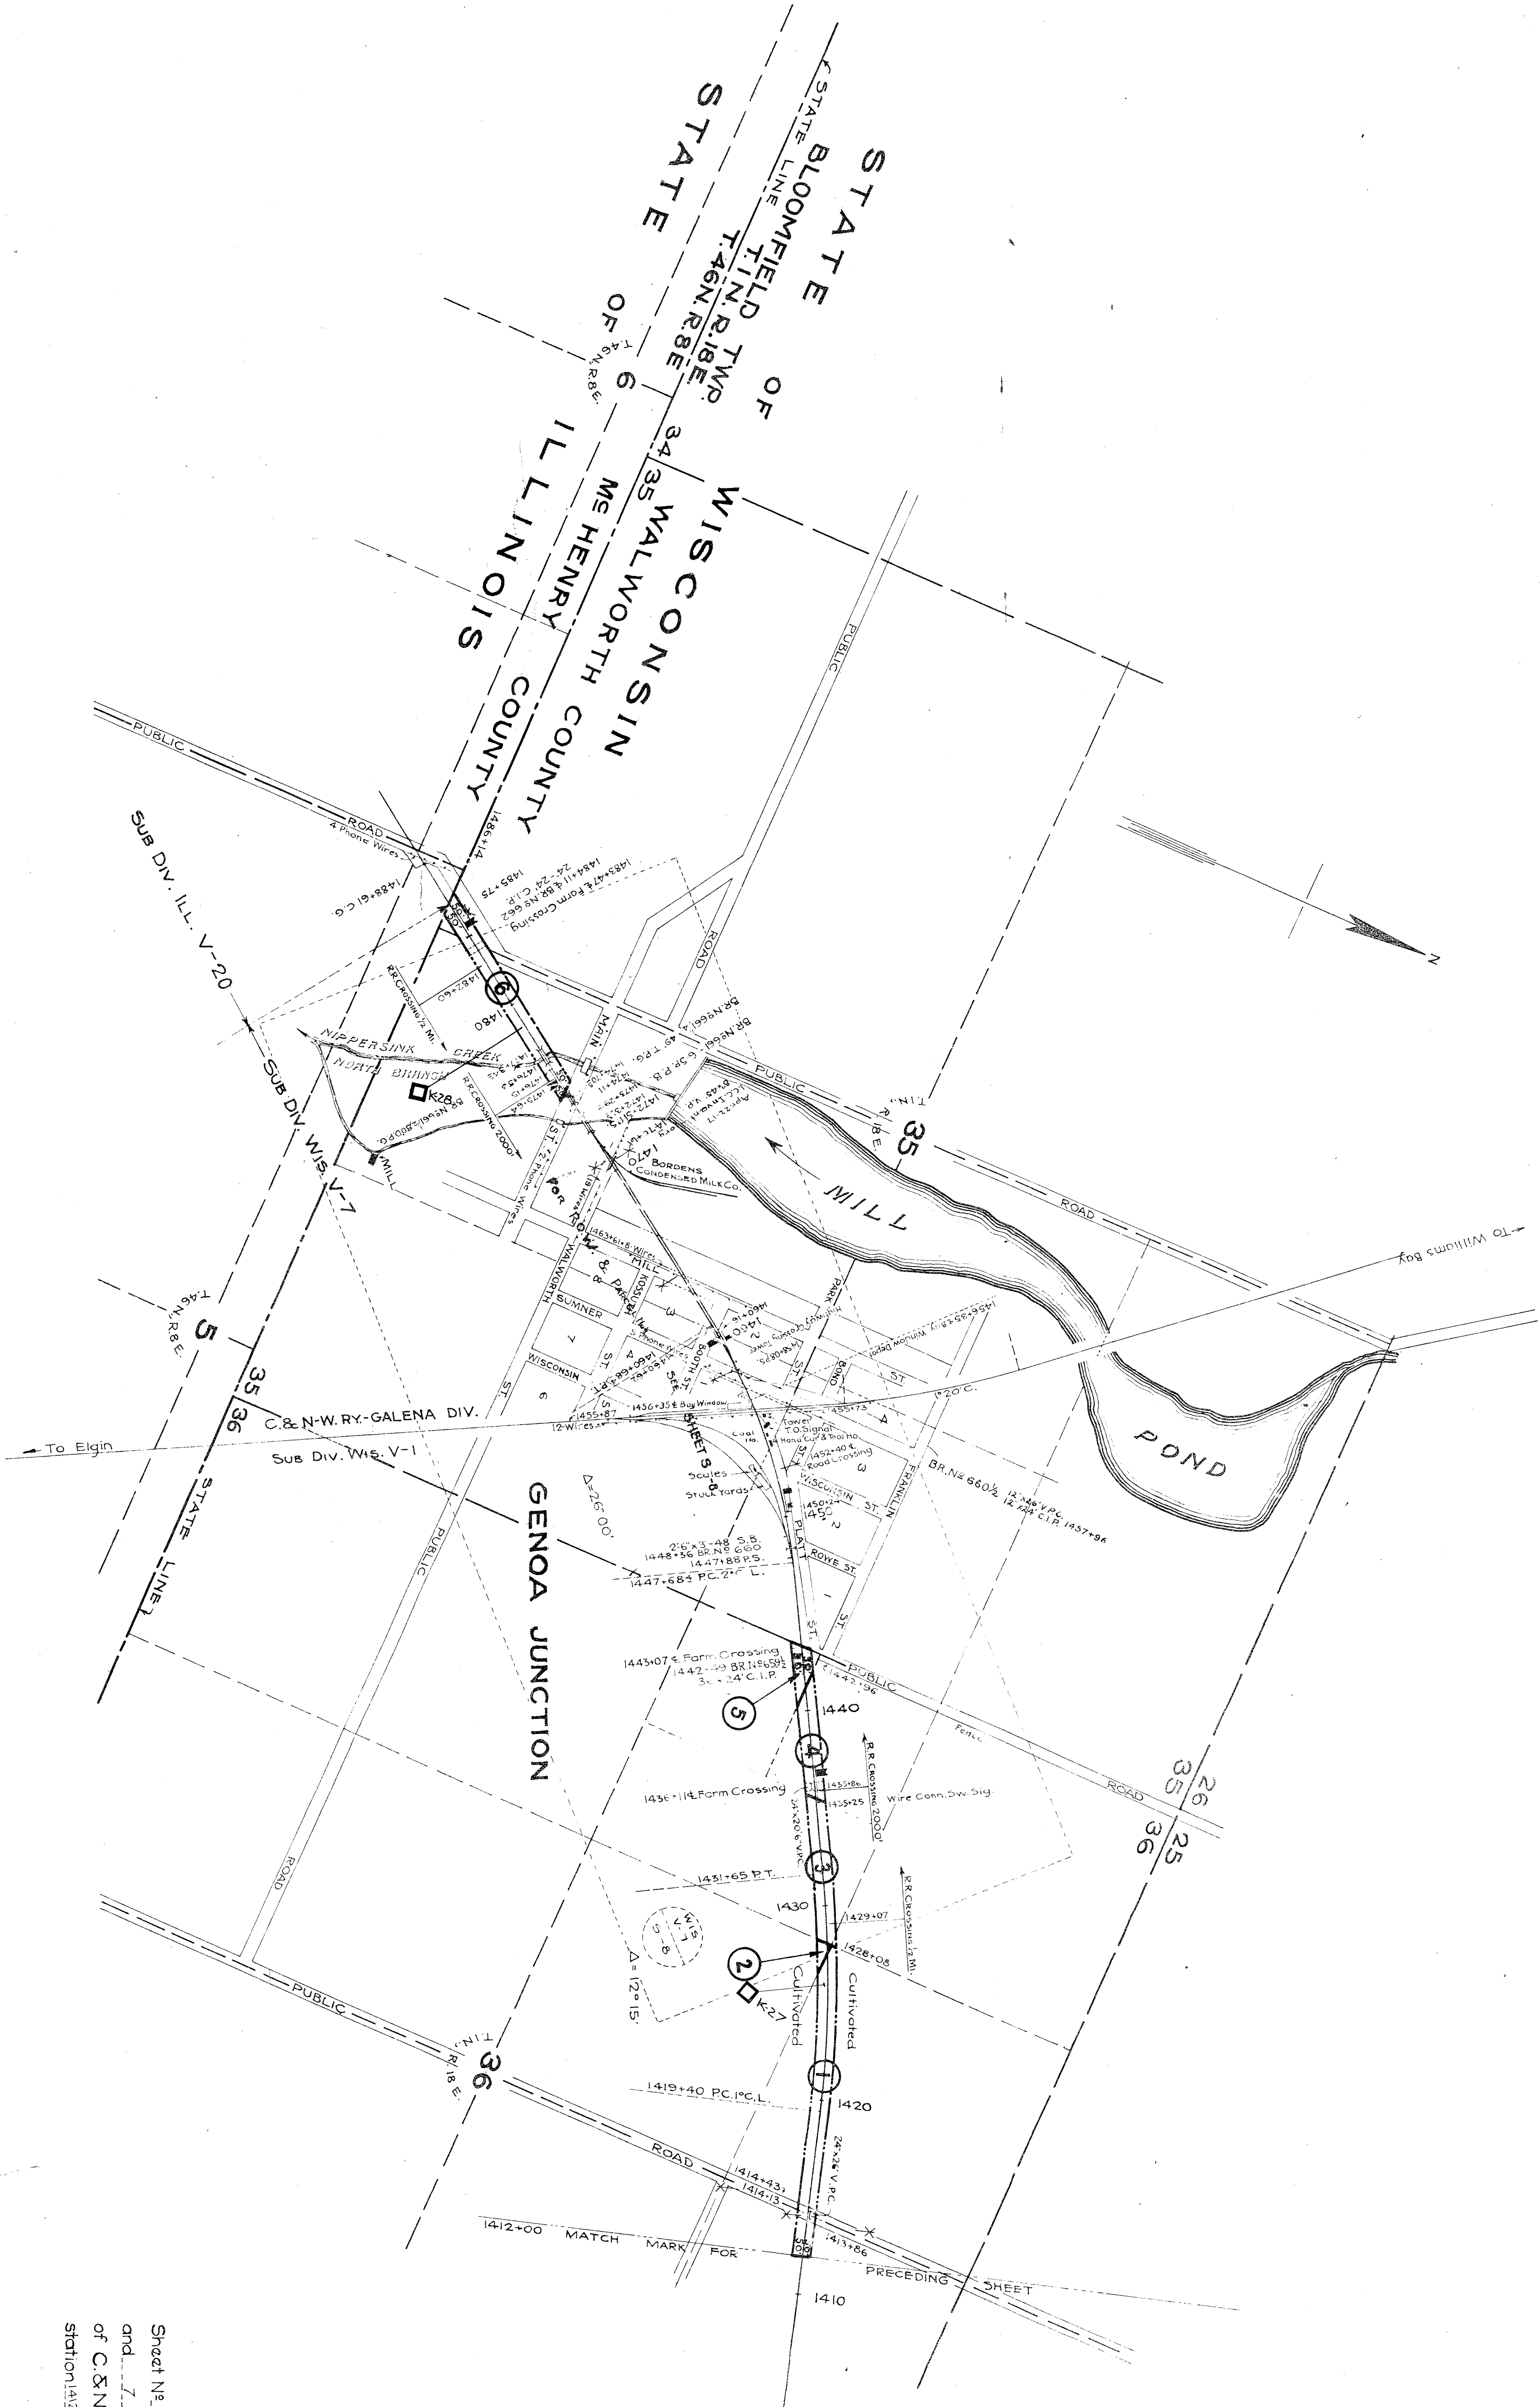

RIGHT OF WAY AND TRACK MAP
CHICAGO AND NORTH-WESTERN RAILWAY
OPERATED BY THE
C. & N. W. RY. CO.
WISCONSIN DIVISION
KENOSHA, WIS. TO GENOA JCT., WIS.
STA. 1412+00 TO STA. 1486+14
SCALE: 1 IN. = 400 FT.
OFFICE OF CHIEF ENGINEER
CHICAGO, ILL.
JUNE 30, 1917