



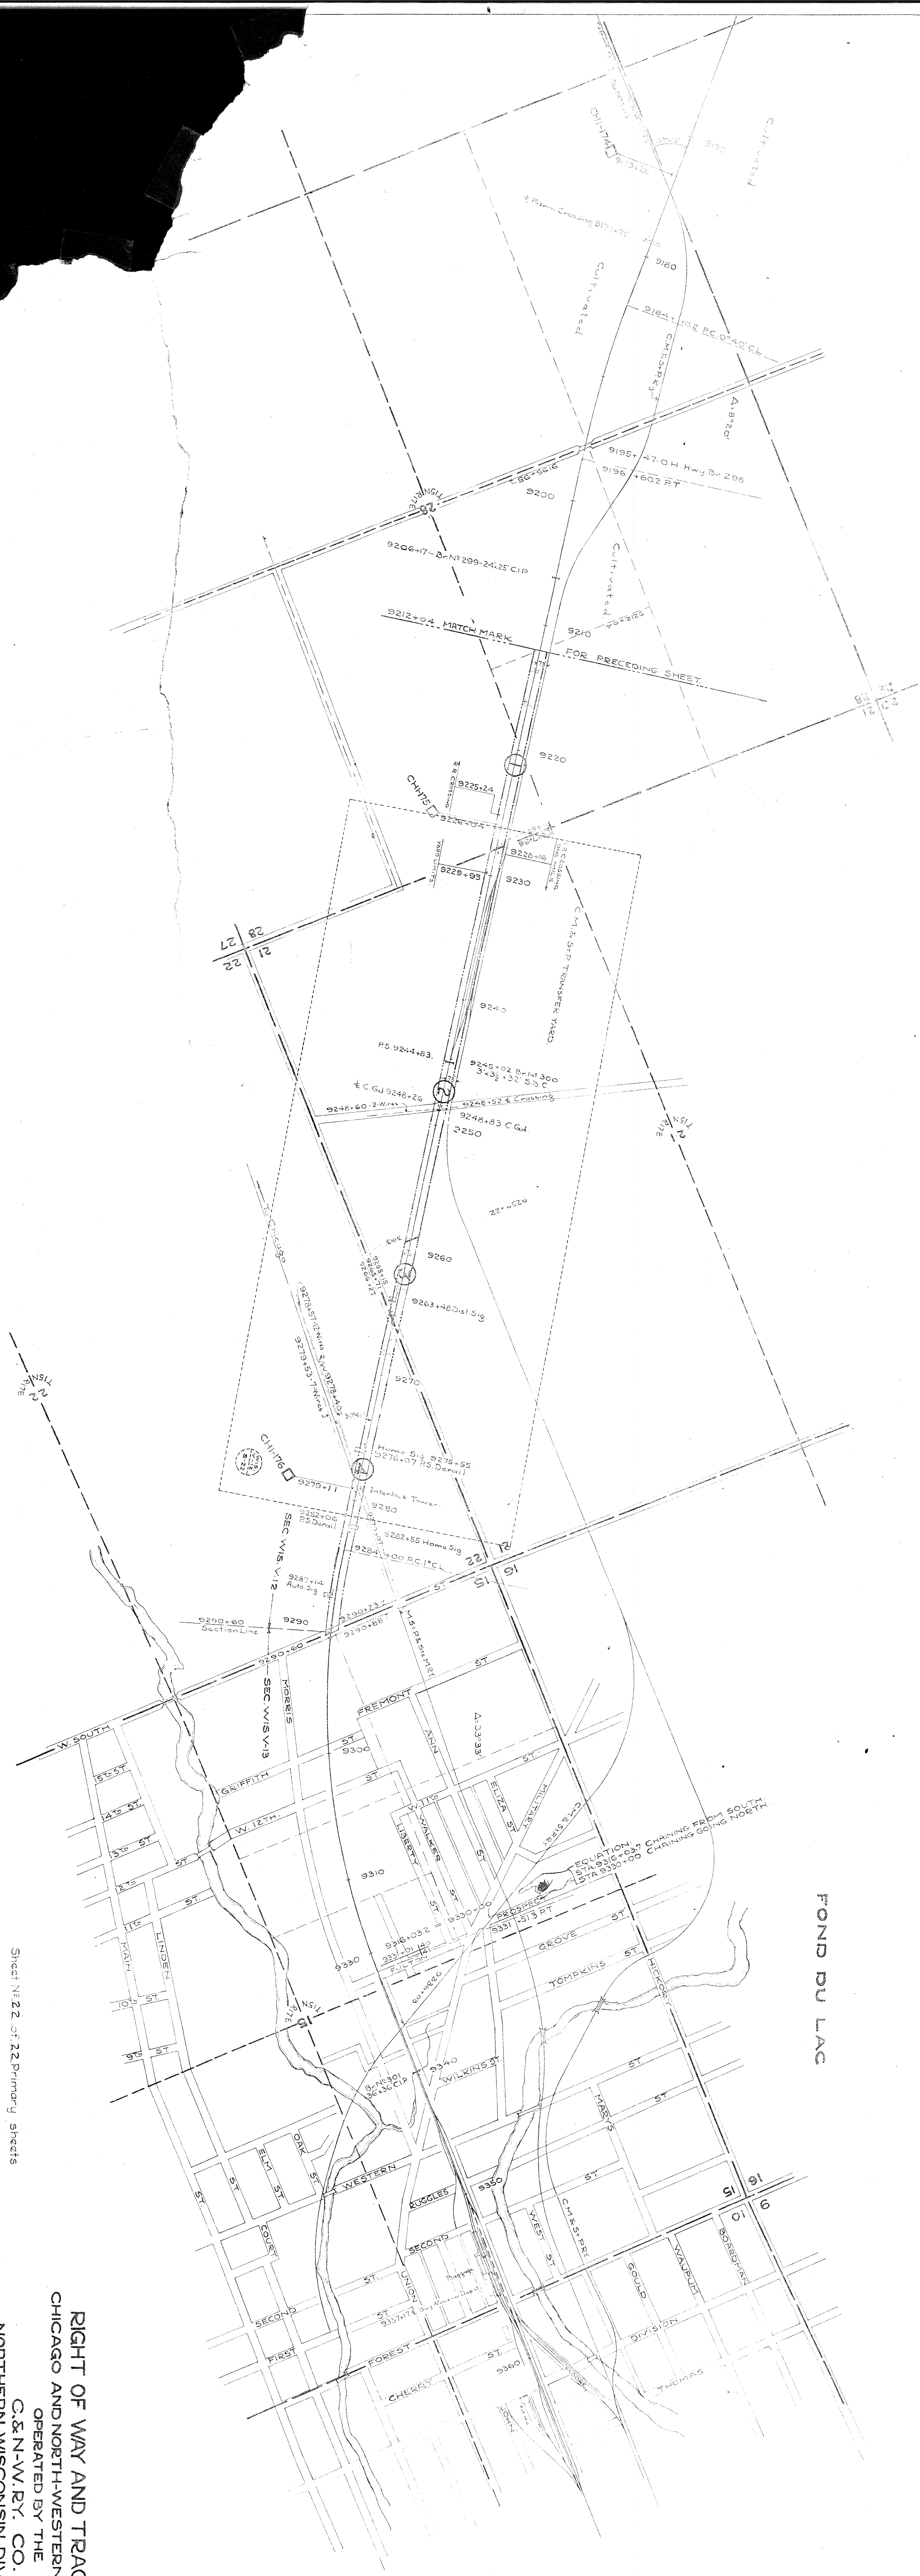

RIGHT OF WAY AND TRACK MAP
CHICAGO AND NORTH-WESTERN RAILWAY
OPERATED BY THE
C.&N.W.RY. CO.
NORTHERN WISCONSIN DIVISION
JANESVILLE, WIS. TO FOND DU LAC, WIS.
STA. 9212+04 TO STA. 9290+60
SCALE: 1"=400'-FT.
JUNE 30, 1917
OFFICE OF CHIEF ENGINEER
CHICAGO, ILL.