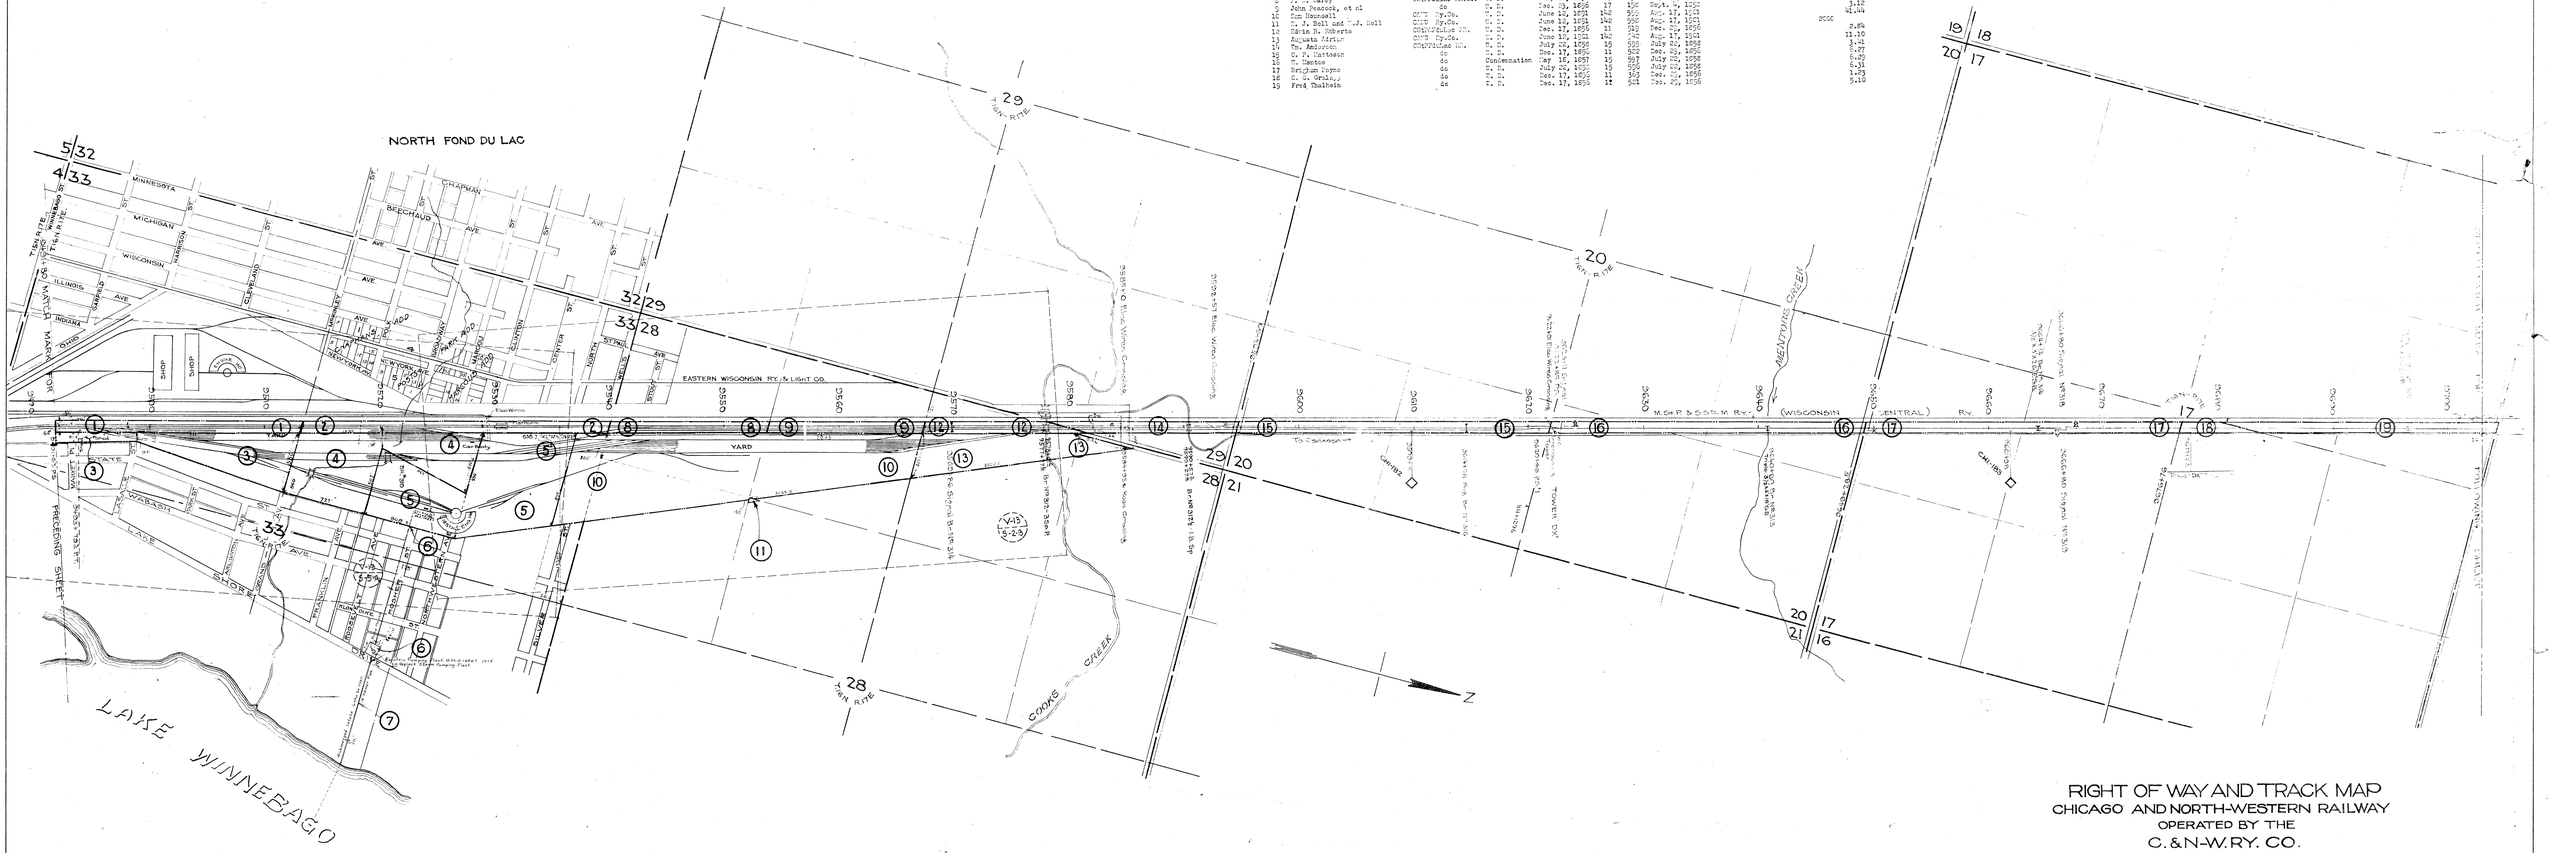

No.	GRANTOR	GRANTEE	RECORDED	Book	Page	Date	AMOUNT	AREA Square	Ac.
1	John Nichols	C&NWPduLac Rly.Co.	T. D.	July 28, 1856	17	53	Aug. 17, 1856		0.01
2	Mason C. Darling	do	T. D.	Dec. 25, 1856	11	516	Dec. 30, 1856		0.82
3	T. H. Post	C&NW Ry.Co.	T. D.	June 12, 1901	140	540	Aug. 17, 1901		11.30
4	Geo. T. Post	C&NW Ry.Co.	T. D.	July 12, 1901	140	546	Aug. 17, 1901		17.32
5	Fairfield Sawyer	C&NW Ry.Co.	T. D.	June 12, 1901	140	551	Aug. 17, 1901		23.74
6	Fairfield C. Sawyer	C&NW Ry.Co.	W. D.	Nov. 10, 1901	124	523	Dec. 10, 1901	23860	
7	Geo. T. Post	C&NW Ry.Co.	T. D.	Nov. 14, 1901	124	522	Dec. 10, 1901	2500	
8	C. C. Carey	C&NWPdu Lac Rly.Co.	W. D.	July 29, 1856	17	52	Aug. 17, 1856		3.17
9	John Peacock, et al	do	T. D.	Jan. 13, 1856	17	150	Sept. 4, 1856		3.32
10	Jas Peacock	C&NW Ry.Co.	T. D.	June 12, 1901	142	560	Aug. 17, 1901		41.44
11	E. J. Doll and T.S. Doll	C&NW Ry.Co.	T. D.	June 12, 1901	142	562	Aug. 17, 1901	2000	
12	Edwin H. Roberts	C&NWPdu Lac Rly.Co.	T. D.	Dec. 17, 1856	21	710	Dec. 20, 1856		2.84
13	Augusta Adrian	C&NW Ry.Co.	T. D.	June 12, 1901	142	561	Aug. 17, 1901		11.10
14	Th. Anderson	C&NWPdu Lac Rly.Co.	T. D.	July 28, 1856	17	555	July 29, 1856		3.31
15	C. P. Lattesen	do	T. D.	Dec. 17, 1856	11	502	Dec. 23, 1856		6.27
16	T. Clarke	do	Condemnation	Sep 16, 1857	17	557	July 29, 1856		5.79
17	Brigham Payne	do	T. D.	July 29, 1856	15	556	July 29, 1856		5.31
18	C. C. Grubb,	do	T. D.	Dec. 17, 1856	11	503	Dec. 23, 1856		1.03
19	Fred Thalhein	do	T. D.	Dec. 17, 1856	11	504	Dec. 20, 1856		5.10

Platted: S.K.Y.-Nov.28-1916.
Traced: W.C.D.-Dec.18-1916.
Checked: S.K.Y.-Feb.8-1917.

Sheet No. 2 of 17 Primary Sheets and 33 Supplemental Sheets of C.&N.W.Ry. from Survey Station 9491+80 to Survey Station 9703+00

Valuation Engineer

RIGHT OF WAY AND TRACK MAP
CHICAGO AND NORTH-WESTERN RAILWAY
OPERATED BY THE
C. & N-W. RY. CO.
NOR. WIS. DIVISION
FOND DU LAC, WIS. to GREEN BAY, WIS.
STA. 9491+80 TO STA. 9703+00
SCALE 1-IN. = 400-FT. JUNE 30, 1917.
OFFICE OF CHIEF ENGINEER
CHICAGO, ILL.

WIS V-13 2