NO.	GRANTOR	GRANTEE	INSTRUMENT	D A T E	RECORD Book	Page	Date	REMARKS	A R E A Sq.Ft.	Ac.
1	J. Wolf	S.& F.du Lac RR.	W. D.	Dec. 27, 1877	44	518	Apr. 10, 1876			2.31
2	A. P. Lyman, et al	C.&N.W.Ry.Co.	W. D.	July 22, 1861	47	135	Aug. 29, 1861			3.25
	Possessory Title								1350	
3	L. Wolf	S.& M.RR.Co.	W. D.	Dec. 25, 1858	43	466	Feb. 15, 1877			3.36
4	K. Fruwalar	S.& M.RR.Co.	W. D.	Dec. 30, 1856	43	467	Feb. 15, 1877			0.26
5	L. Eastman									0.09
6	Possessory Title									3.43
7	L. Ortmire	S.& M.RR.Co.	W. D.	Dec. 22, 1858	43	466	Feb. 15, 1877			3.32
8	H. Rosenfelt	S.& M.RR.Co.	W. D.	Dec. 23, 1858	43	472	Feb. 15, 1877			1.76
9	G. Freshtet	S.& M.RR.Co.	W. D.	Dec. 29, 1858	43	468	Feb. 15, 1877	9A(.57 Ac.)bought with Parcel #9 since sold.		1.19
10	K. Schleich	S.& M.RR.Co.	W. D.	Dec. 22, 1858	43	479	Feb. 15, 1877	10A(1.36 Ac)bought with Parcel #10 since sold.		2.20
11	L. Witt	S.& M.RR.Co.	W. D.	Jan. 7, 1859	43	476	Feb. 15, 1877	11A(.905 Sq.Ft.)bought with 10195 Parcel #11 since sold.		
12	T. Swart	S.& M.RR.Co.	W. D.	Jan. 4, 1859	43	477	Feb. 15, 1877	12A(0.70 Ac.)bought with Parcel #12 since sold.		4.11
13	W. Witte	S.& M.RR.Co.	W. D.	Sept. 4, 1856	1	463	Sept.13, 1856	13A(1.31 Ac.)bought with Parcel #13 since sold.		2.16
14	Plymouth Furniture Co.	C.& N.W.Ry.Co.	Easement	Nov. 9, 1906	135	521	Nov. 11, 1906		15300	

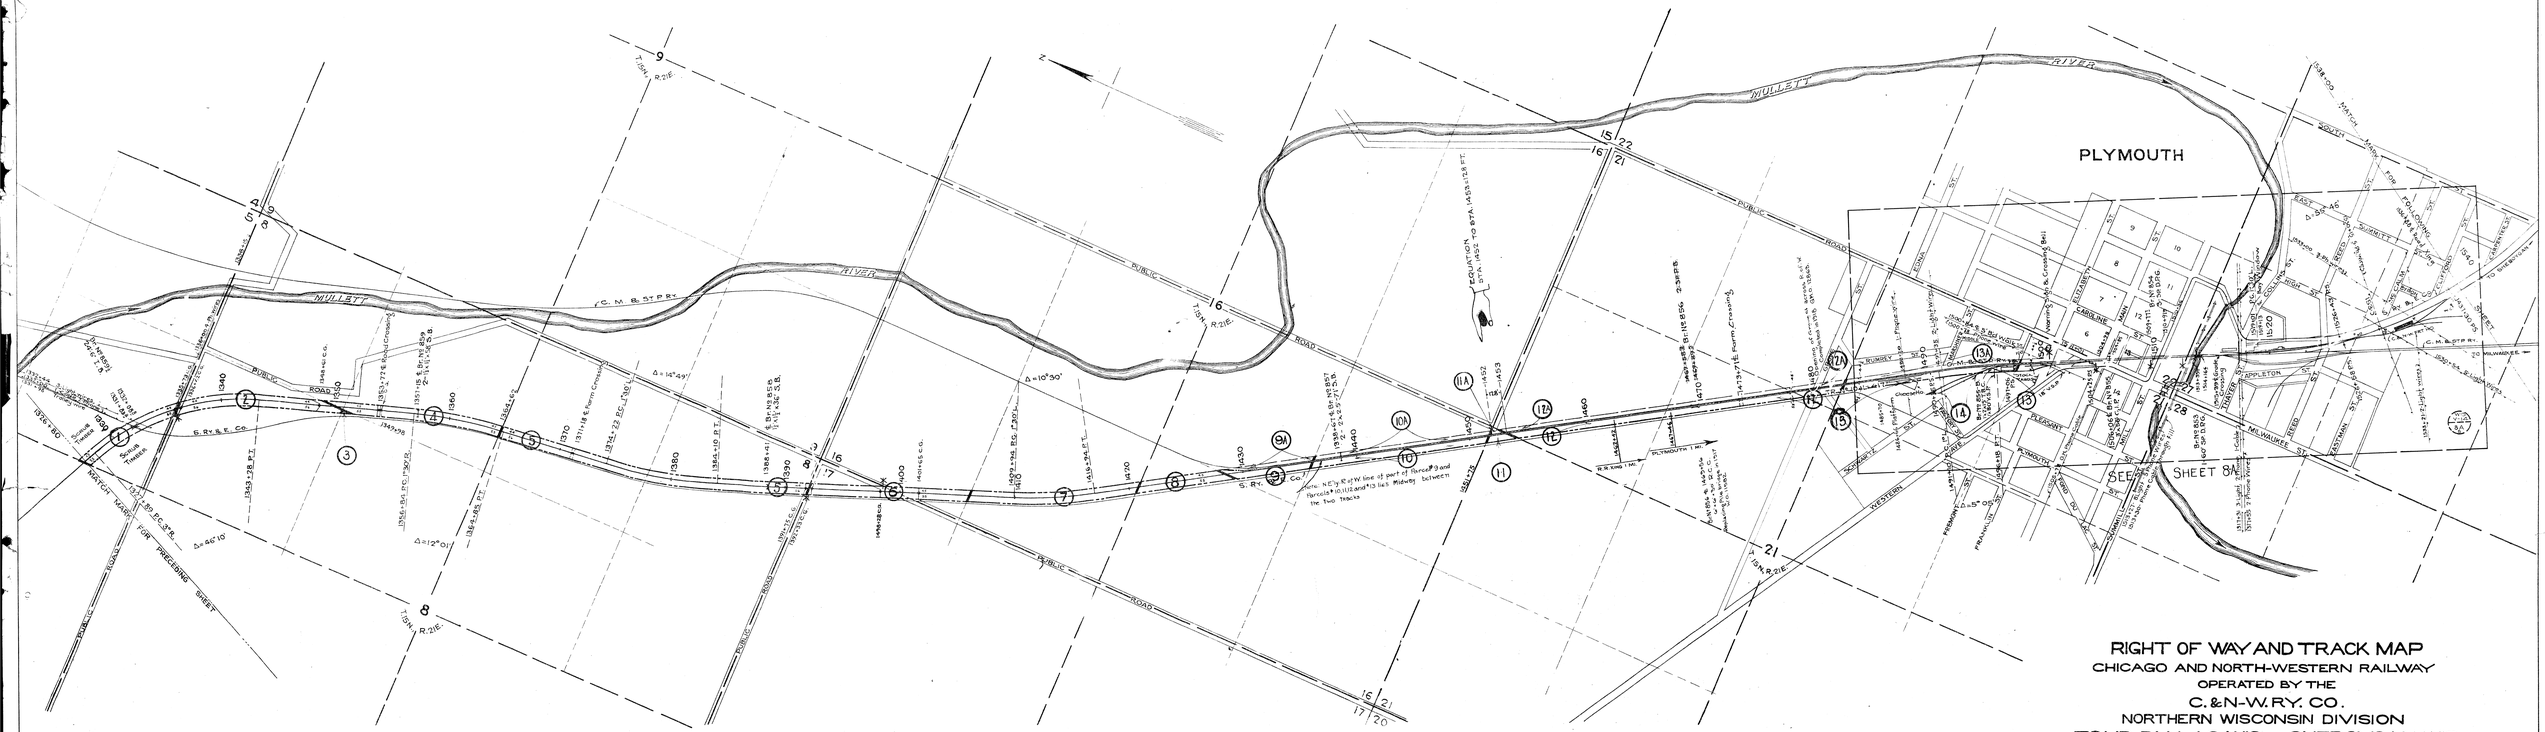

PLATTED - R.G.C. - AUG. 10, 1916.
TRACED - V.W.C. - AUG. 24, 1916.
CHECKED - R.G.C. - SEPT. 13, 1916.

Sheet No. 8 of 17 C & N.W. Ry
From Survey Station 1326+80
To Survey Station 1538+00
12-P. 5-S.

W. M. Hansen
Valuation Engineer.

RIGHT OF WAY AND TRACK MAP
CHICAGO AND NORTH-WESTERN RAILWAY
OPERATED BY THE
C. & N-W. RY. CO.
NORTHERN WISCONSIN DIVISION
FOND DU LAC, WIS. TO SHEBOYGAN, WIS.
STA. 1326+80 TO STA. 1538+00

SCALE: 1 IN. = 400 FT. JUNE 30, 1917
OFFICE OF CHIEF ENGINEER
CHICAGO, ILL.

WIS. V-14
8