
No.	GRANTOR	GRANTEE	INSTRUMENT	DATE	RECORDS Book	Page	Date	REMARKS	AREA Sq.Ft.	Ac.
1	J. Craig	S.& P.&Lac.RR.Co.	W. D.	July 5, 1870	43	321	Feb. 15, 1877			1.37
2	Sheboygan Construction Co.	C.& N.W.Ry.Co.	Easement	July 13, 1909	Land Constr. Office				7690	
3	M. Bennett	S. & W. RR.Co.	W. D.	July 1, 1857	43	476	Feb. 18, 1875		14000	
4	O. P. Cole	S. & W. RR.Co.	W. D.	July 15, 1856	43	441	Feb. 15, 1877			3.19
5	J. Leighton	S. & W. RR.Co.	W. D.	Oct. 31, 1856	43	339	Feb. 15, 1877		20500	
6	E. B. Steadman, et al	S. & W. RR.Co.	W. D.	July 21, 1856	43	360	Feb. 15, 1877			2.58
7	W. Farnsworth	S. & W. RR.Co.	W. D.	Dec. 29, 1856	43	339	Feb. 15, 1877			3.34
	J. O. Thayer	C.M.& N.W.Ry.Co.	W. D.	July 7, 1881	46	339	July 10, 1881			
8	Possessory title									3.29
9	J. McKenna	S.& W.RR.Co.	W. D.	July 15, 1856	43	336	Feb. 15, 1877			1.84
10	J. Spelany	S.& W.RR.Co.	W. D.	Dec. 12, 1856	43	426	Feb. 15, 1877			0.84
	J. Seeley	S.& W.RR.Co.	W. D.	Aug. 4, 1858	43	334	Feb. 15, 1877			
11	W. J. Balkins, et al	C.& N.W.Ry.Co.	Easement	Sept.28, 1899	68	592	Dec. 15, 1899			1.17
	W. J. Balkins, et al	Do	"	Nov. 25, 1901	Not Recorded					
	J. M. Kohler Sons Co.	Do	"	July 19, 1905	"	"				
	J. M. Kohler Sons Co.	Do	"	June 28, 1915	"	"				
	Kohler Co.	Do	"	Feb. 29, 1916	"	"				
12	Possessory title								24000	
13	L. Book	S.& W.RR.Co.	W. D.	Dec. 6, 1856	43	328	Feb. 15, 1877			2.97
14	A. Kanaschenner	S.& W.RR.Co.	W. D.	Aug. 15, 1856	43	328	Feb. 15, 1877			1.76
15	S. Wagner, et al	S.& W.RR.Co.	W. D.	Feb. 20, 1857	43	335	Feb. 15, 1877			1.00
16	Possessory title								6750	
17	A. T. Lyman	S.& W.RR.Co.	W. D.	Jan. 3, 1857	43	431	Feb. 15, 1877			8.23
18	Possessory title									1.57

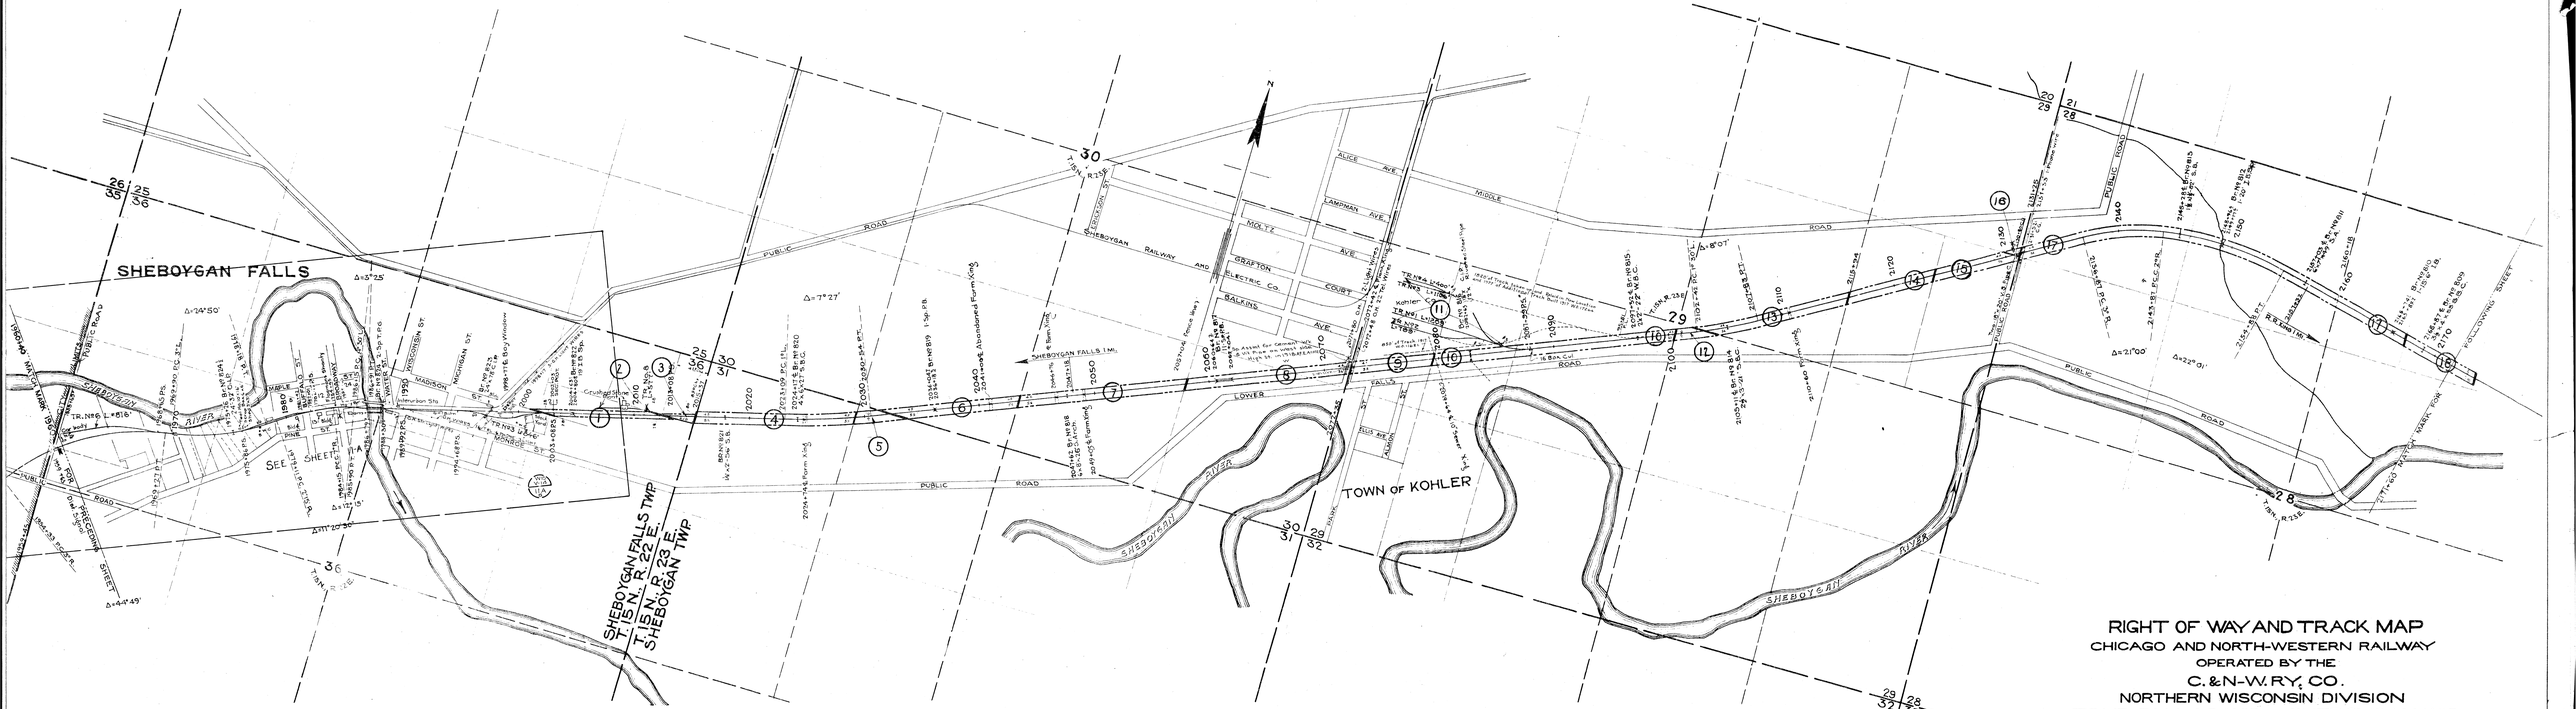

PLATTED - R.G.C. - JUNE 24, 1916.
TRACED - V.W.C. - AUG. 17, 1916.
CHECKED - R.G.C. - SEPT. 11, 1916

Sheet No. 11 of 17 C.& N.W. Ry.
From Survey Station 1960+40
To Survey Station 2171+60
12-P. 5-S.

Valuation Engineer

RIGHT OF WAY AND TRACK MAP
CHICAGO AND NORTH-WESTERN RAILWAY
OPERATED BY THE
C.&N-W.RY. CO.
NORTHERN WISCONSIN DIVISION
FOND DU LAC, WIS. TO SHEBOYGAN, WIS.
STA. 1960+40 TO STA. 2171+60
SCALE: 1 IN. = 400 FT. JUNE 30, 1917.
OFFICE OF CHIEF ENGINEER
CHICAGO, ILL.

WIS. V-14 11