


SHEBOYGAN

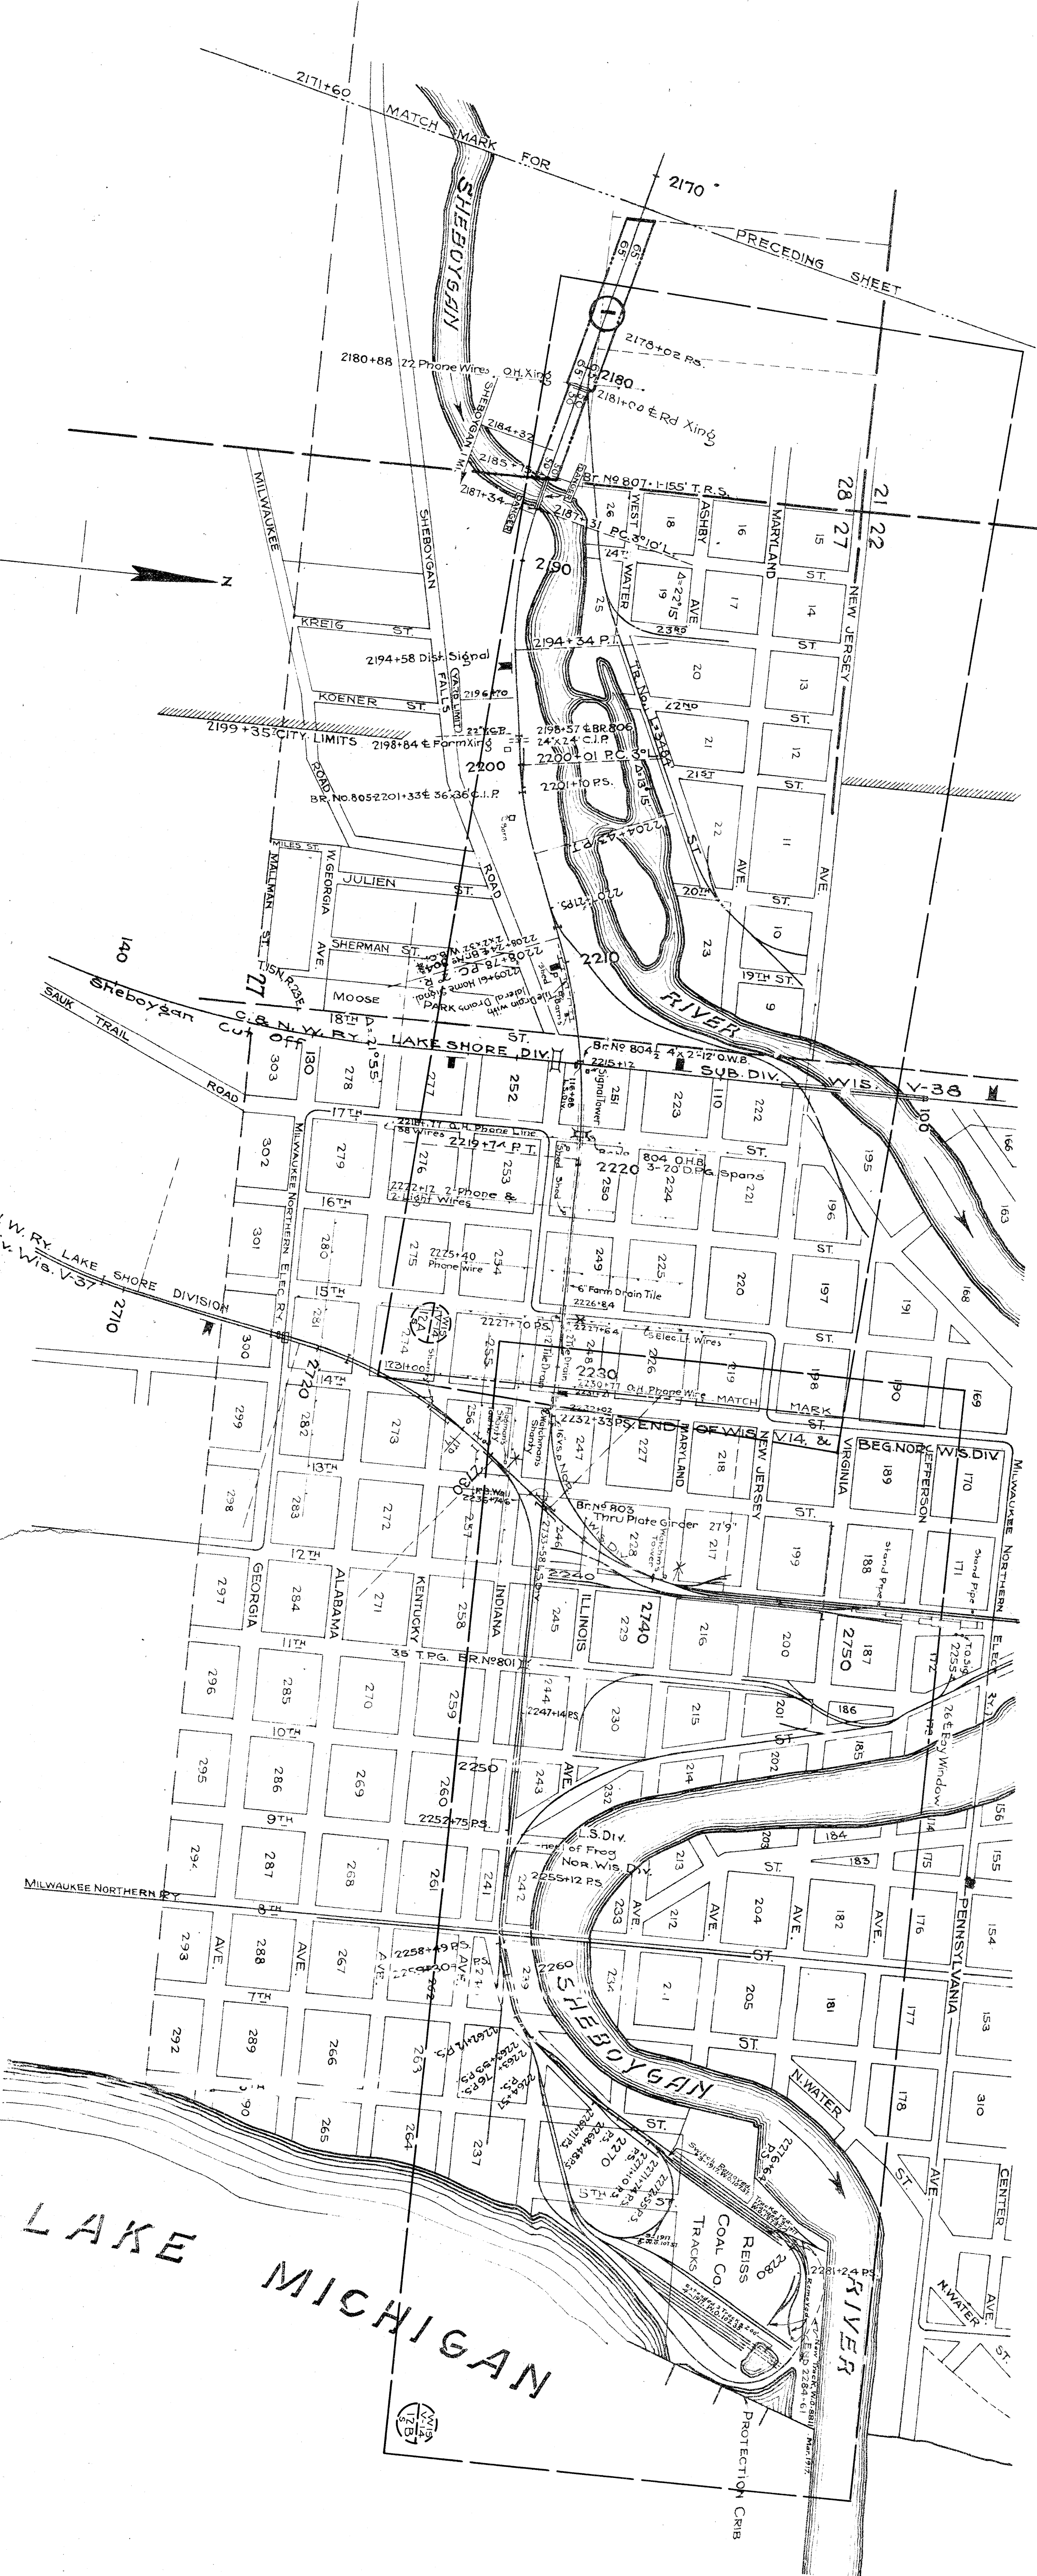

LAKE MICHIGAN

RIGHT OF WAY AND TRACK MAP
CHICAGO AND NORTH-WESTERN RAILWAY
OPERATED BY THE
C. & N.W. RY. CO.

NORTHERN WISCONSIN DIVISION
FOND DU LAC, WIS. TO SHEBOYGAN, WIS.

Sheet No. 12, of 17, C. & N.W. Ry.
from Survey Station 2171+00
to Survey Station 2232+33
12-P. 5-S.
JUNE 30 1917.
CHICAGO, ILL.

Valuation Engineer