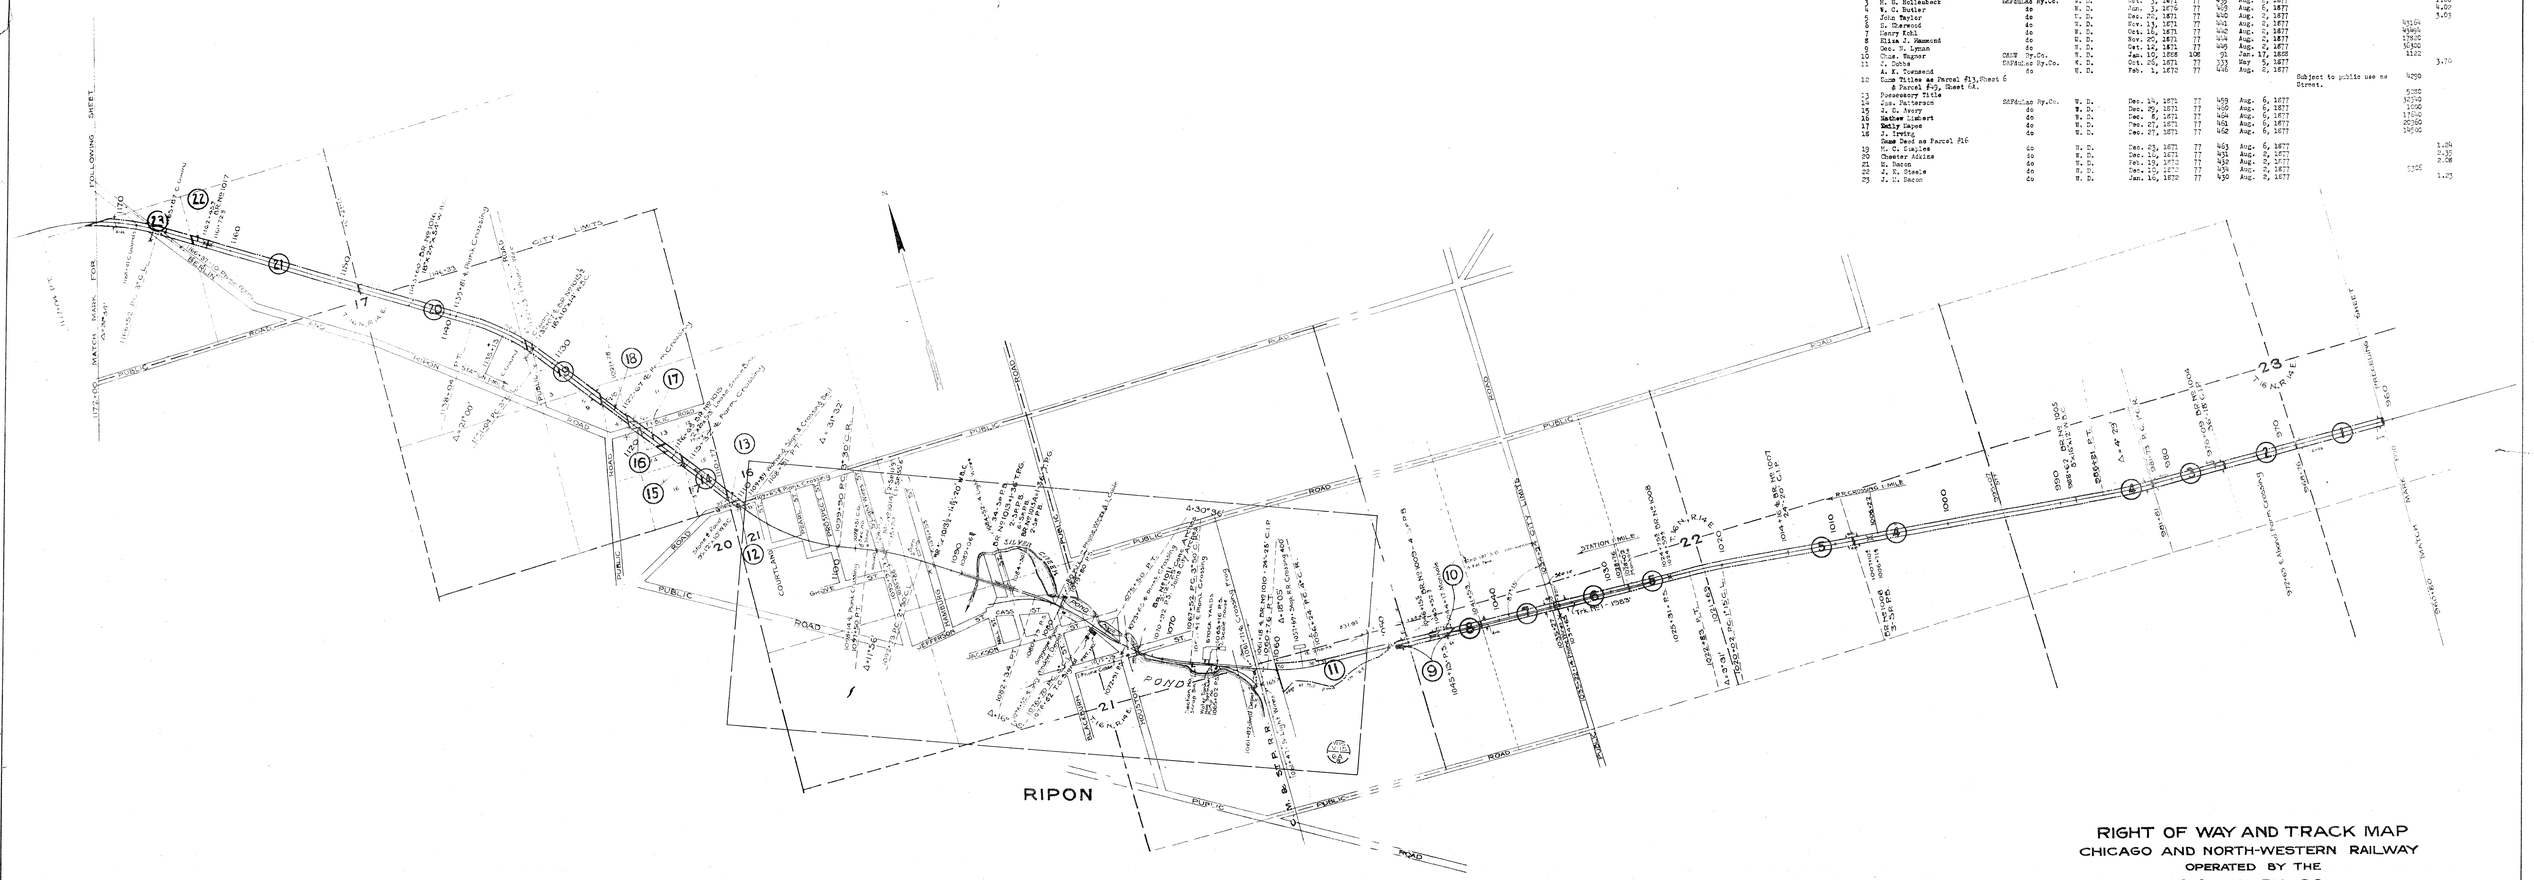

No.	GRANTOR	GRANTEE	INSTRUMENT	D A T E		RECORD Book	Page	Date	REMARKS	AREA Sq.Ft.	Ac.
1	J. E. Barlow	C&FdeLac Ry.Co.	W. D.	Dec. 22, 1871	77		438	Aug. 6, 1877			1.01
2	Possessory Title										1.00
3	H. S. Hollenbeck	C&FdeLac Ry.Co.	W. D.	Oct. 3, 1871	77		439	Aug. 6, 1877			1.00
4	W. C. Butler	do	W. D.	Jan. 3, 1876	77		403	Aug. 6, 1877			4.00
5	John Taylor	do	W. D.	Dec. 20, 1871	77		440	Aug. 6, 1877			3.05
6	H. Harwood	do	W. D.	Nov. 13, 1871	77		441	Aug. 6, 1877		43100	
7	Henry Kohl	do	W. D.	Oct. 16, 1871	77		442	Aug. 6, 1877		43965	
8	Eliza J. Hammond	do	W. D.	Nov. 20, 1871	77		444	Aug. 6, 1877		17500	
9	Geo. H. Lyman	do	W. D.	Oct. 12, 1871	77		445	Aug. 6, 1877		16800	
10	Chas. Wagner	C&NW Ry.Co.	W. D.	Jan. 10, 1868	108		91	Jan. 17, 1868		1122	
11	J. Dohs	C&FdeLac Ry.Co.	W. D.	Oct. 26, 1871	77		333	May 5, 1877			3.70
12	A. K. Townsend Same Titles as Parcel #13, Sheet 6 & Parcel #42, Sheet 6A.	do	W. D.	Feb. 1, 1872	77		446	Aug. 6, 1877	Subject to public use as Street.	4200 5200	
13	Possessory Title									32300	
14	Jas. Patterson	C&FdeLac Ry.Co.	W. D.	Dec. 14, 1871	77		459	Aug. 6, 1877		1000	
15	J. C. Avery	do	W. D.	Dec. 29, 1871	77		460	Aug. 6, 1877		17500	
16	Mathew Clement	do	W. D.	Dec. 8, 1871	77		494	Aug. 6, 1877		20300	
17	Emily Capes	do	W. D.	Dec. 27, 1871	77		461	Aug. 6, 1877		19500	
18	J. Irvin Same Deed as Parcel #16	do	W. D.	Dec. 27, 1871	77		462	Aug. 6, 1877		15600	
19	W. C. Hughes	do	W. D.	Dec. 23, 1871	77		463	Aug. 6, 1877			1.84
20	Chester Adkins	do	W. D.	Dec. 16, 1871	77		431	Aug. 6, 1877			2.35
21	H. Bacon	do	W. D.	Feb. 13, 1872	77		432	Aug. 6, 1877			2.08
22	J. R. Steele	do	W. D.	Dec. 16, 1871	77		434	Aug. 6, 1877		5205	
23	J. D. Bacon	do	W. D.	Jan. 16, 1872	77		430	Aug. 6, 1877			1.23

PLATTED - R.G.C. - DEC. 12, 1916.
TRACED - V.W.C. - DEC. 30, 1916.
CHECKED - R.G.C. - JAN. 6, 1917.

Sheet No. 6 of 13 C & N.W. Ry.
From Survey Station 960+80
To Survey Station 1172+00
10-P. 3-5.

Valuation Engineer.

RIGHT OF WAY AND TRACK MAP
CHICAGO AND NORTH-WESTERN RAILWAY
OPERATED BY THE
C. & N.-W. RY. CO.
NORTHERN WISCONSIN DIVISION
FOND DU LAC, WIS. TO PRINCETON, WIS.
STA. 960+80 TO STA. 1172+00
SCALE 1-IN. = 400 FT. JUNE 30, 1917.
OFFICE OF CHIEF ENGINEER.
CHICAGO, ILL.

WIS. V-15 6