


PLATTED - R.G.C. - DEC. 18, 1916
TRACED - V.W.C. - JAN. 4, 1917
CHECKED - R.G.C. - JAN. 10, 1917

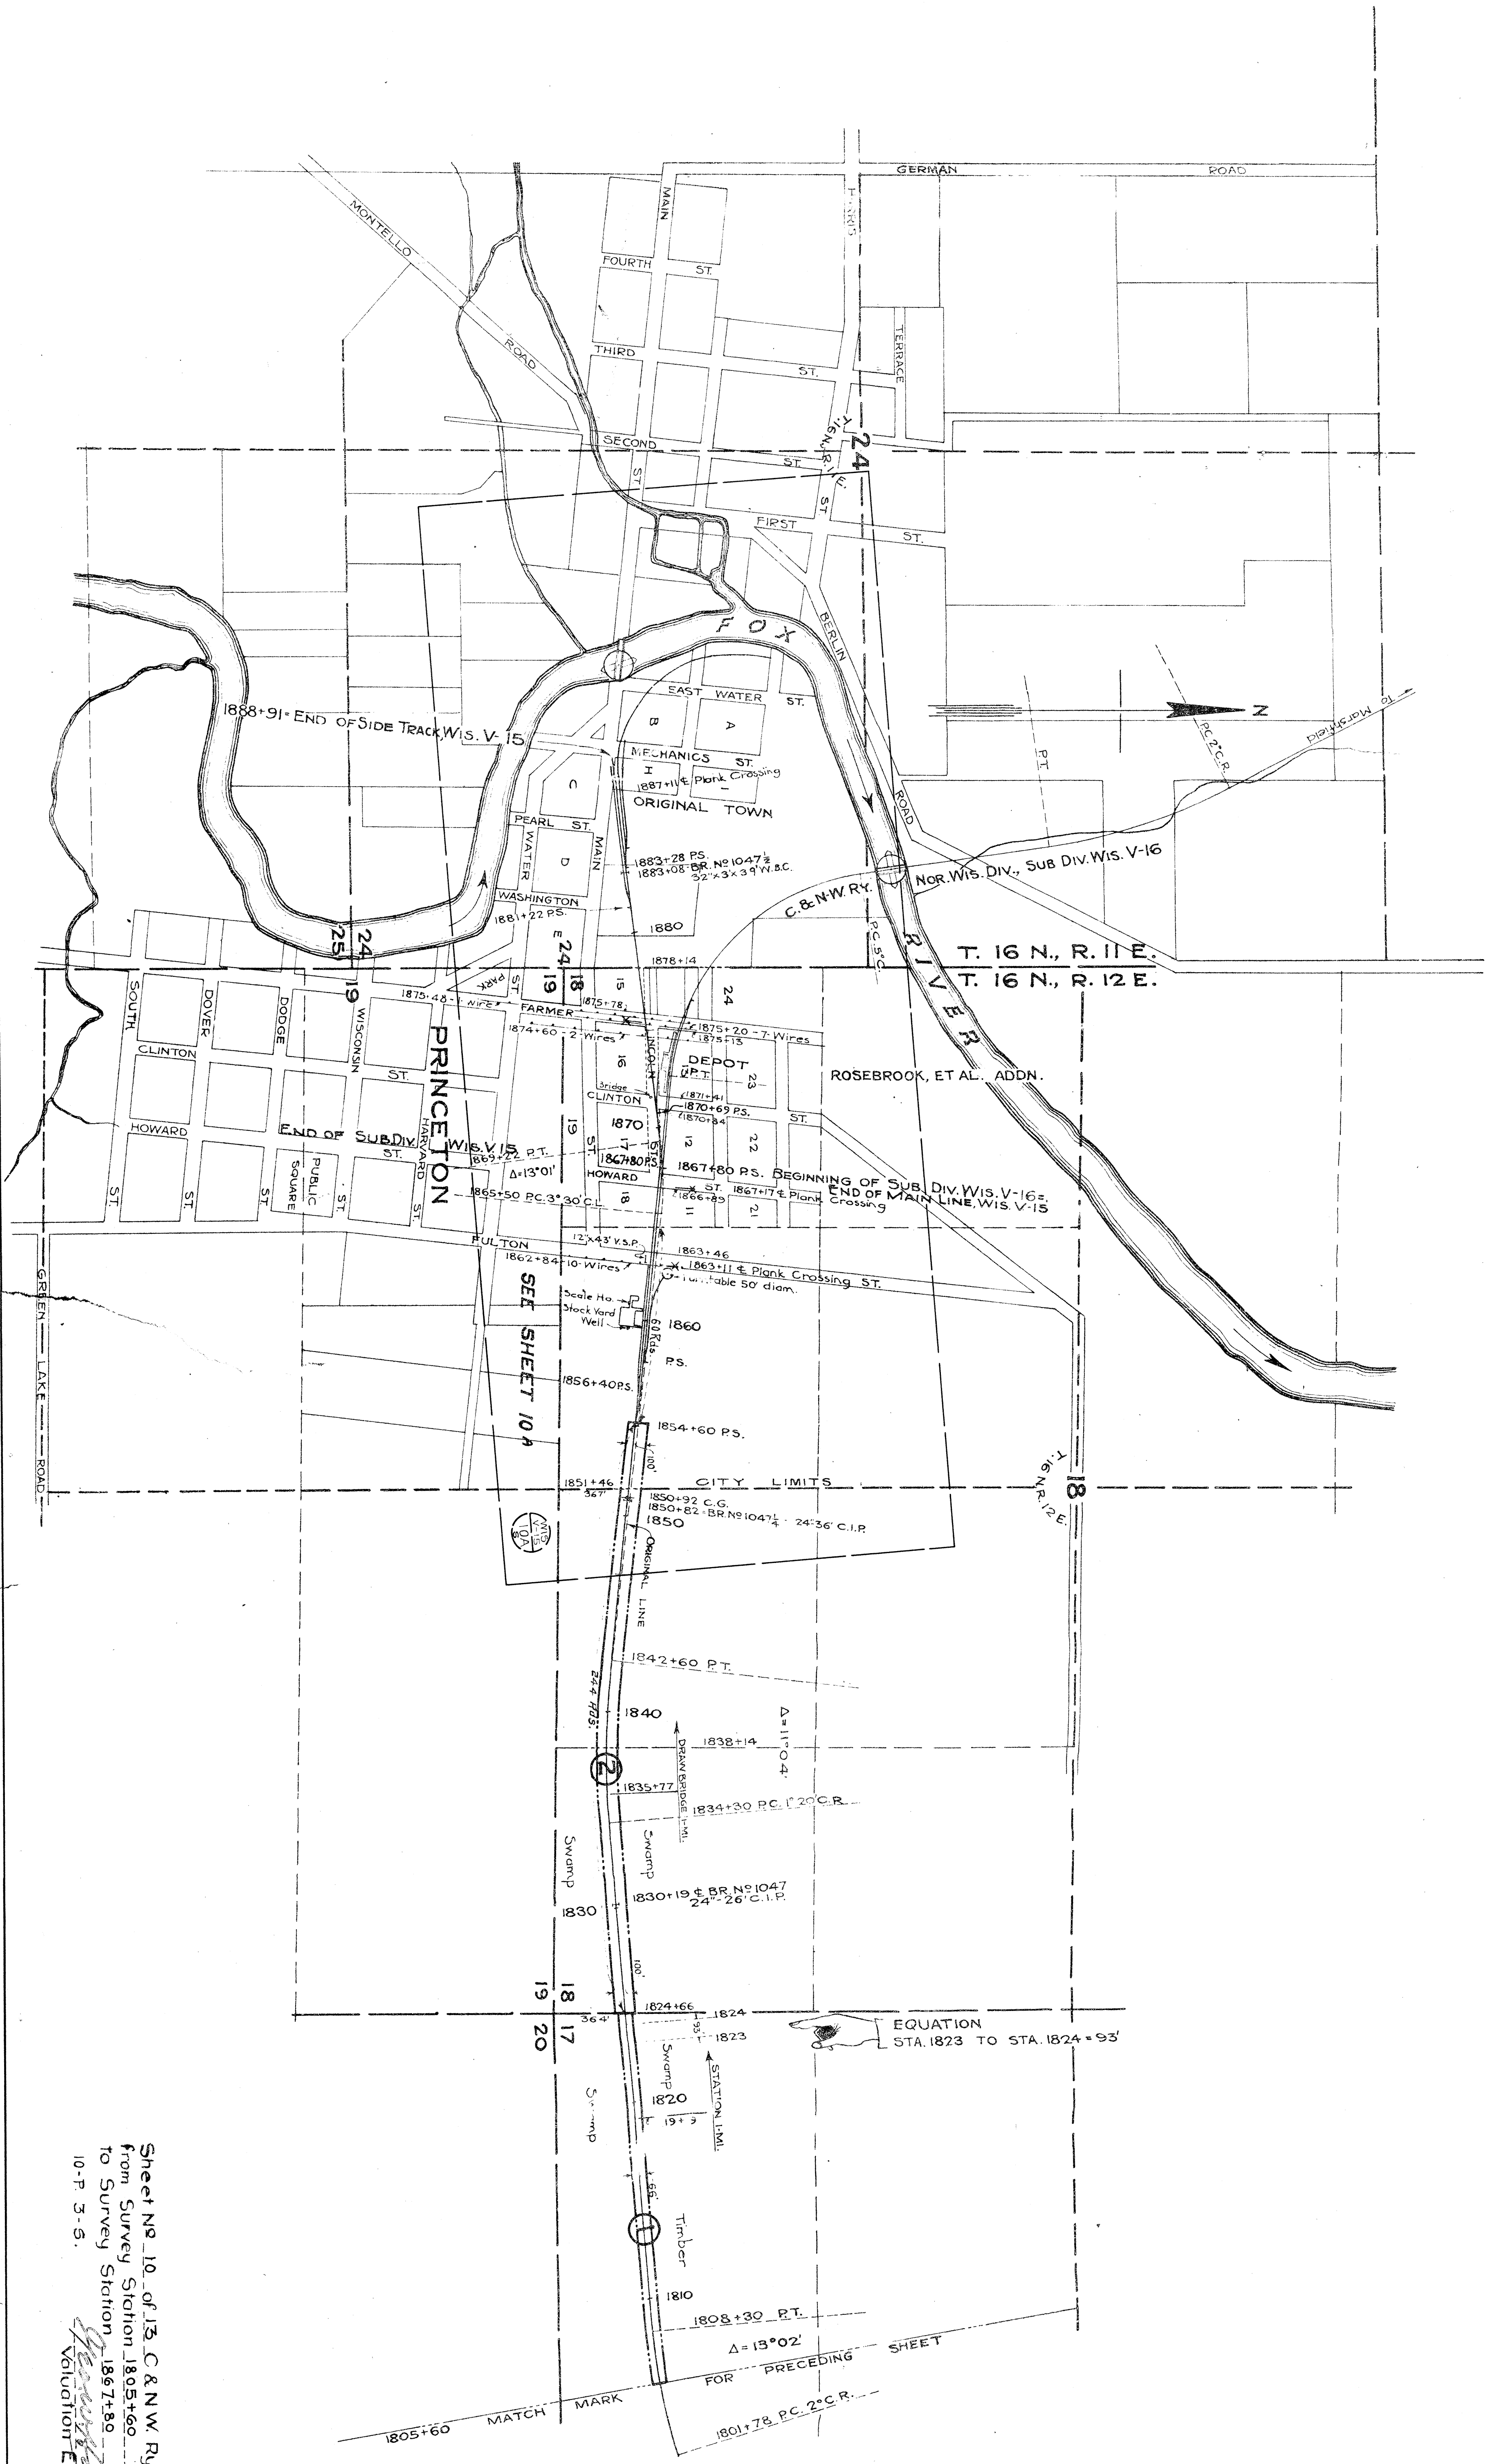

Sheet No. 10 of 13, C. & N.W. Ry.
from Survey Station 1805+60
to Survey Station 1867+80
10-P 3-5.
Vol. 10
Chief Engineer

RIGHT OF WAY AND TRACK MAP
CHICAGO AND NORTH-WESTERN RAILWAY
OPERATED BY THE
C. & N.W. RY. CO.
NORTHERN WISCONSIN DIVISION
FOND DU LAC, WIS. TO PRINCETON, WIS.
STA. 1805+60 TO STA. 1867+80
SCALE 1-IN. = 400 FT.
OFFICE OF CHIEF ENGINEER.
JUNE 30, 1917.
CHICAGO, ILL.

NO. 10
DRAWN
1 William Roberts
2 Seymour A. Hale
CHECKED
R. D. L.
107, 28, 1271
80, 15, 1272
Book No. 551
Page 23, 1273
Page 53, 1278