


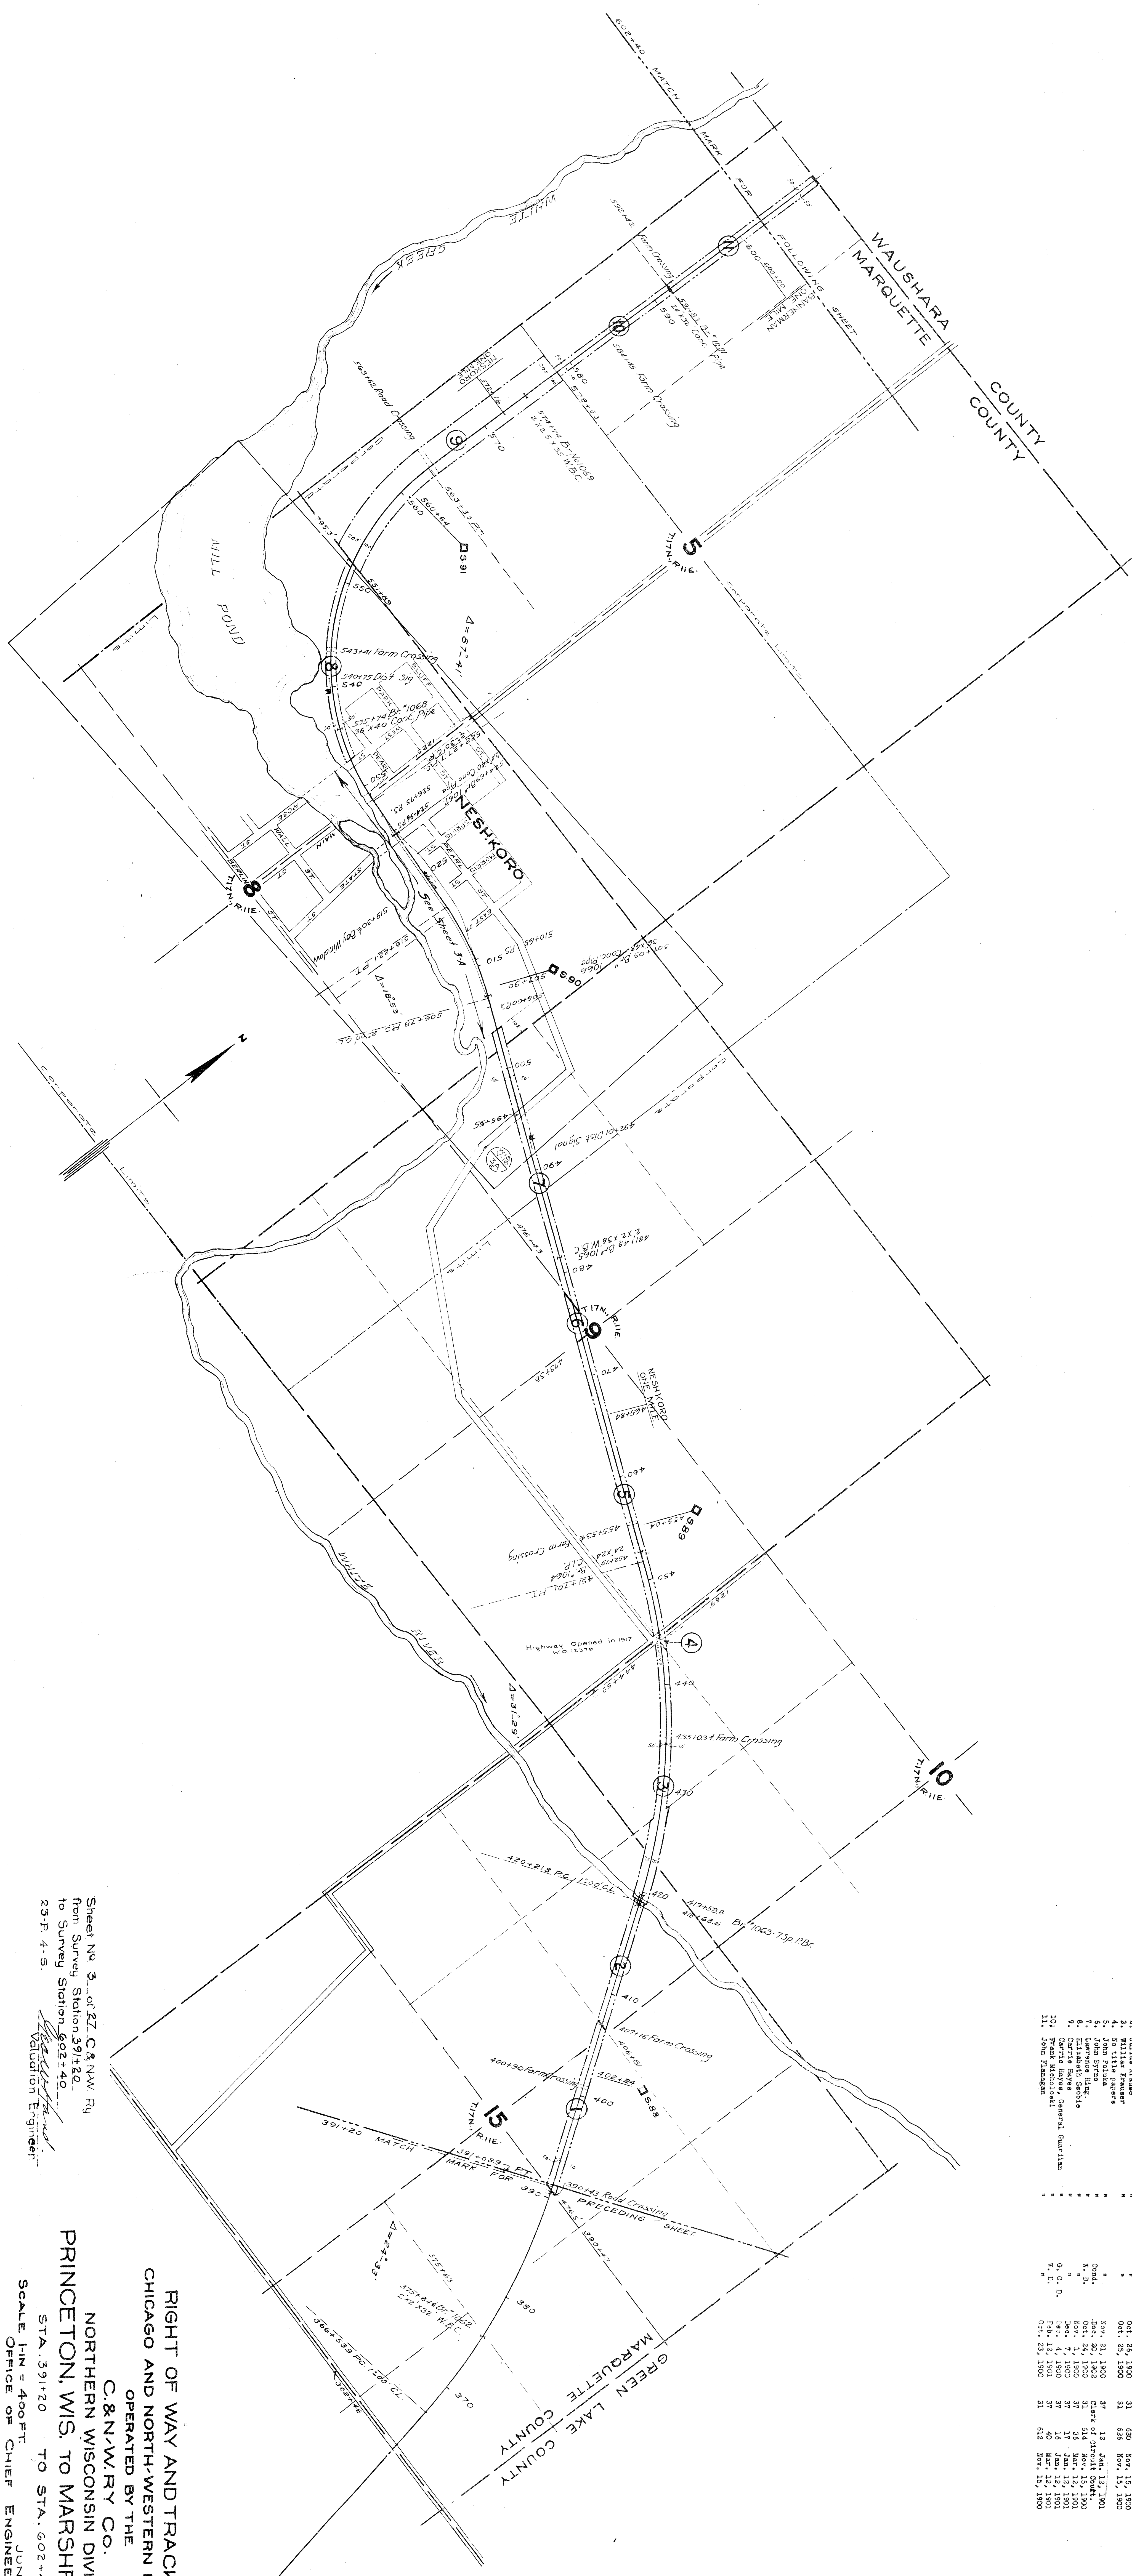

NO.	NAME	DATE	REMARKS	DATE	REMARKS

RIGHT OF WAY AND TRACK MAP
CHICAGO AND NORTH-WESTERN RAILWAY
OPERATED BY THE
C. & N.W. RY. CO.
NORTHERN WISCONSIN DIVISION
PRINCETON, WIS. TO MARSHFIELD, WIS.

23 P. 4-S
Valuation Engineer

SCALE 1-IN = 400 FT.
OFFICE OF CHIEF ENGINEER
JUNE 30, 1917
CHICAGO, ILL.