


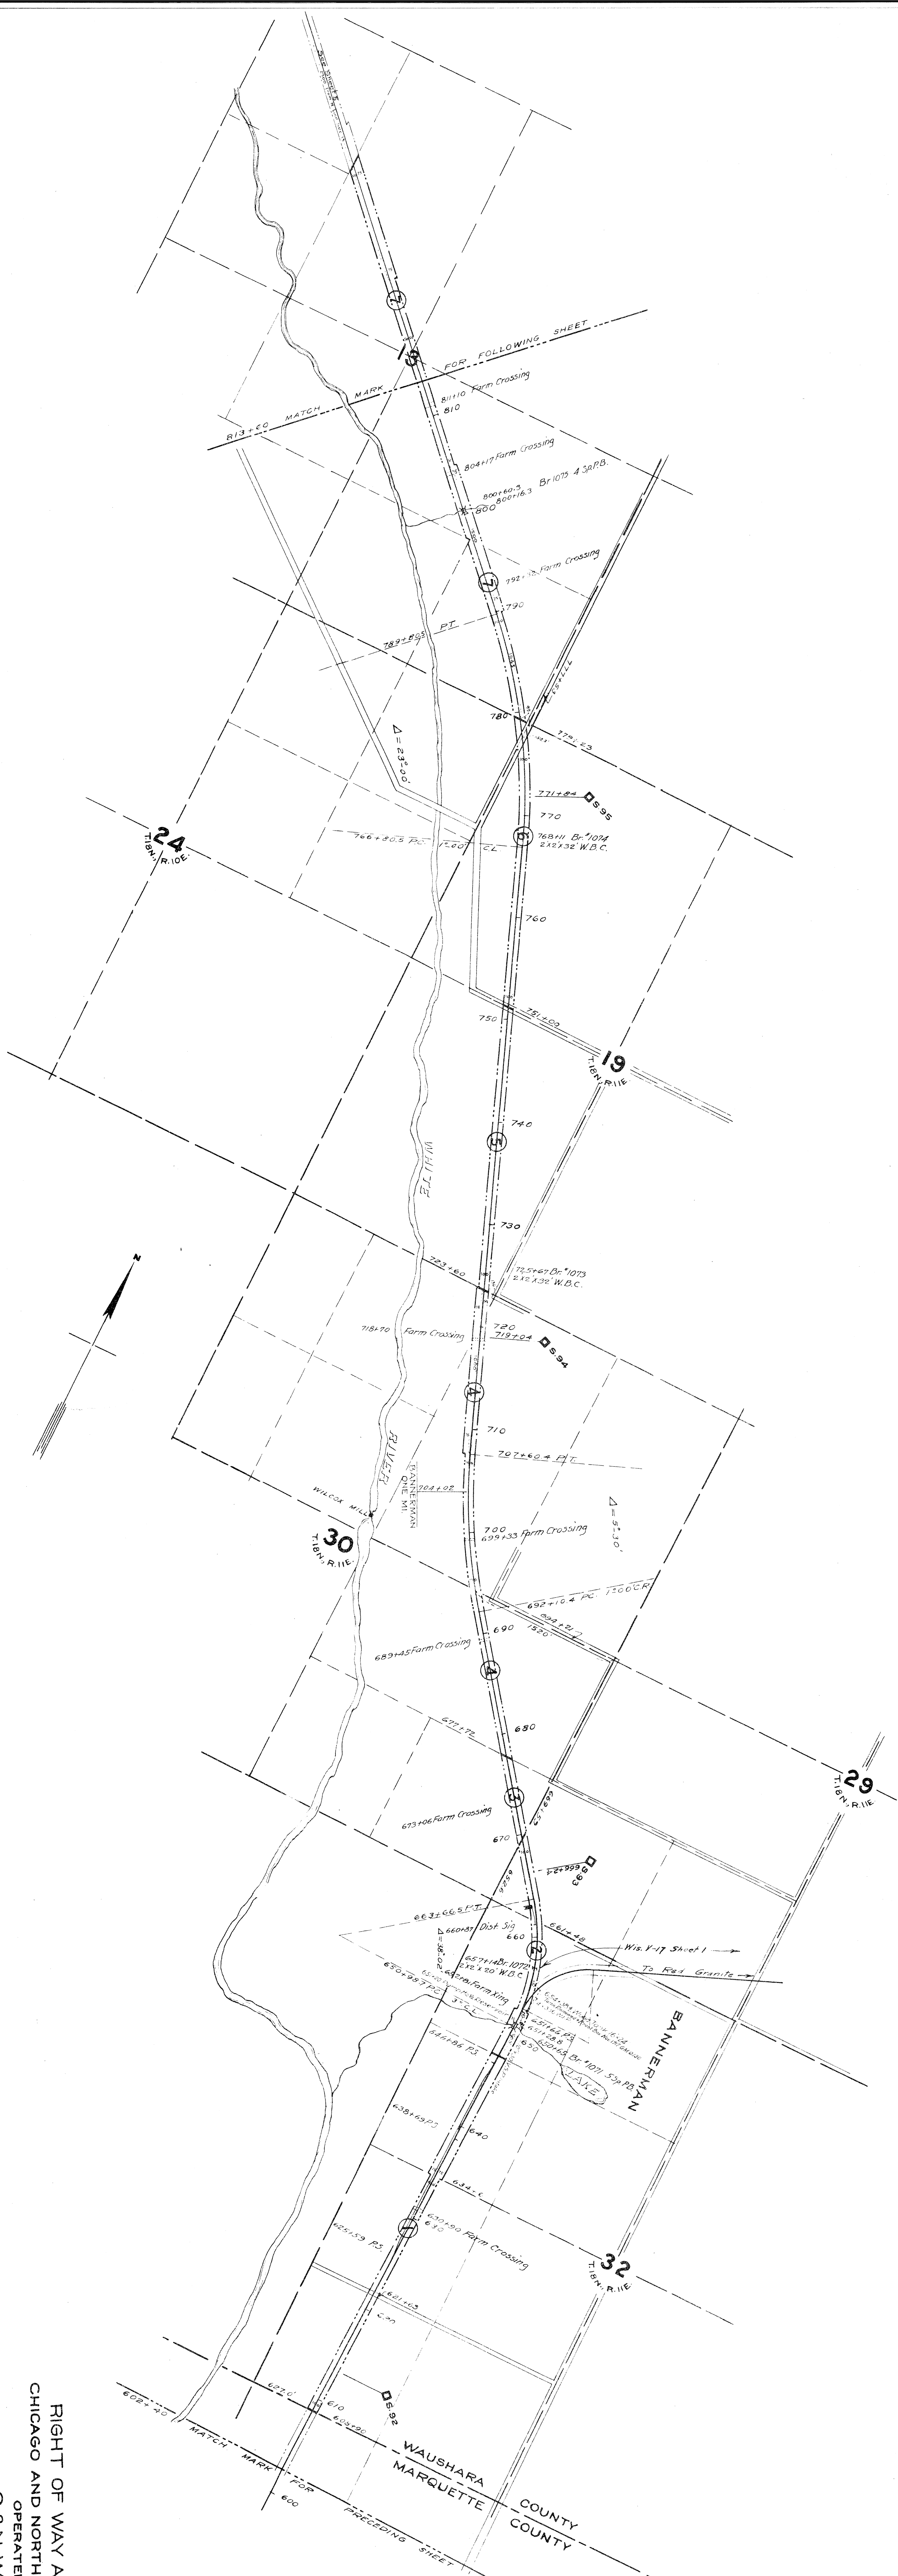


Sheet No. 4 of 27 C. & N.W. Ry.
from Survey Station 602+40
to Survey Station 813+60
23-P. 4-S
Validation Engineer

RIGHT OF WAY AND TRACK MAP
CHICAGO AND NORTH-WESTERN RAILWAY
OPERATED BY THE
C. & N.W. RY. CO.
NORTHERN WISCONSIN DIVISION
PRINCETON, WIS. TO MARSHFIELD, WIS.
STA. 602+40 TO STA. 813+60
SCALE 1"=400 FT. JUNE 30, 1917
OFFICE OF CHIEF ENGINEER
CHICAGO, ILL.