


NO.	NAME	DATE	RECORD	REMARKS	AREA

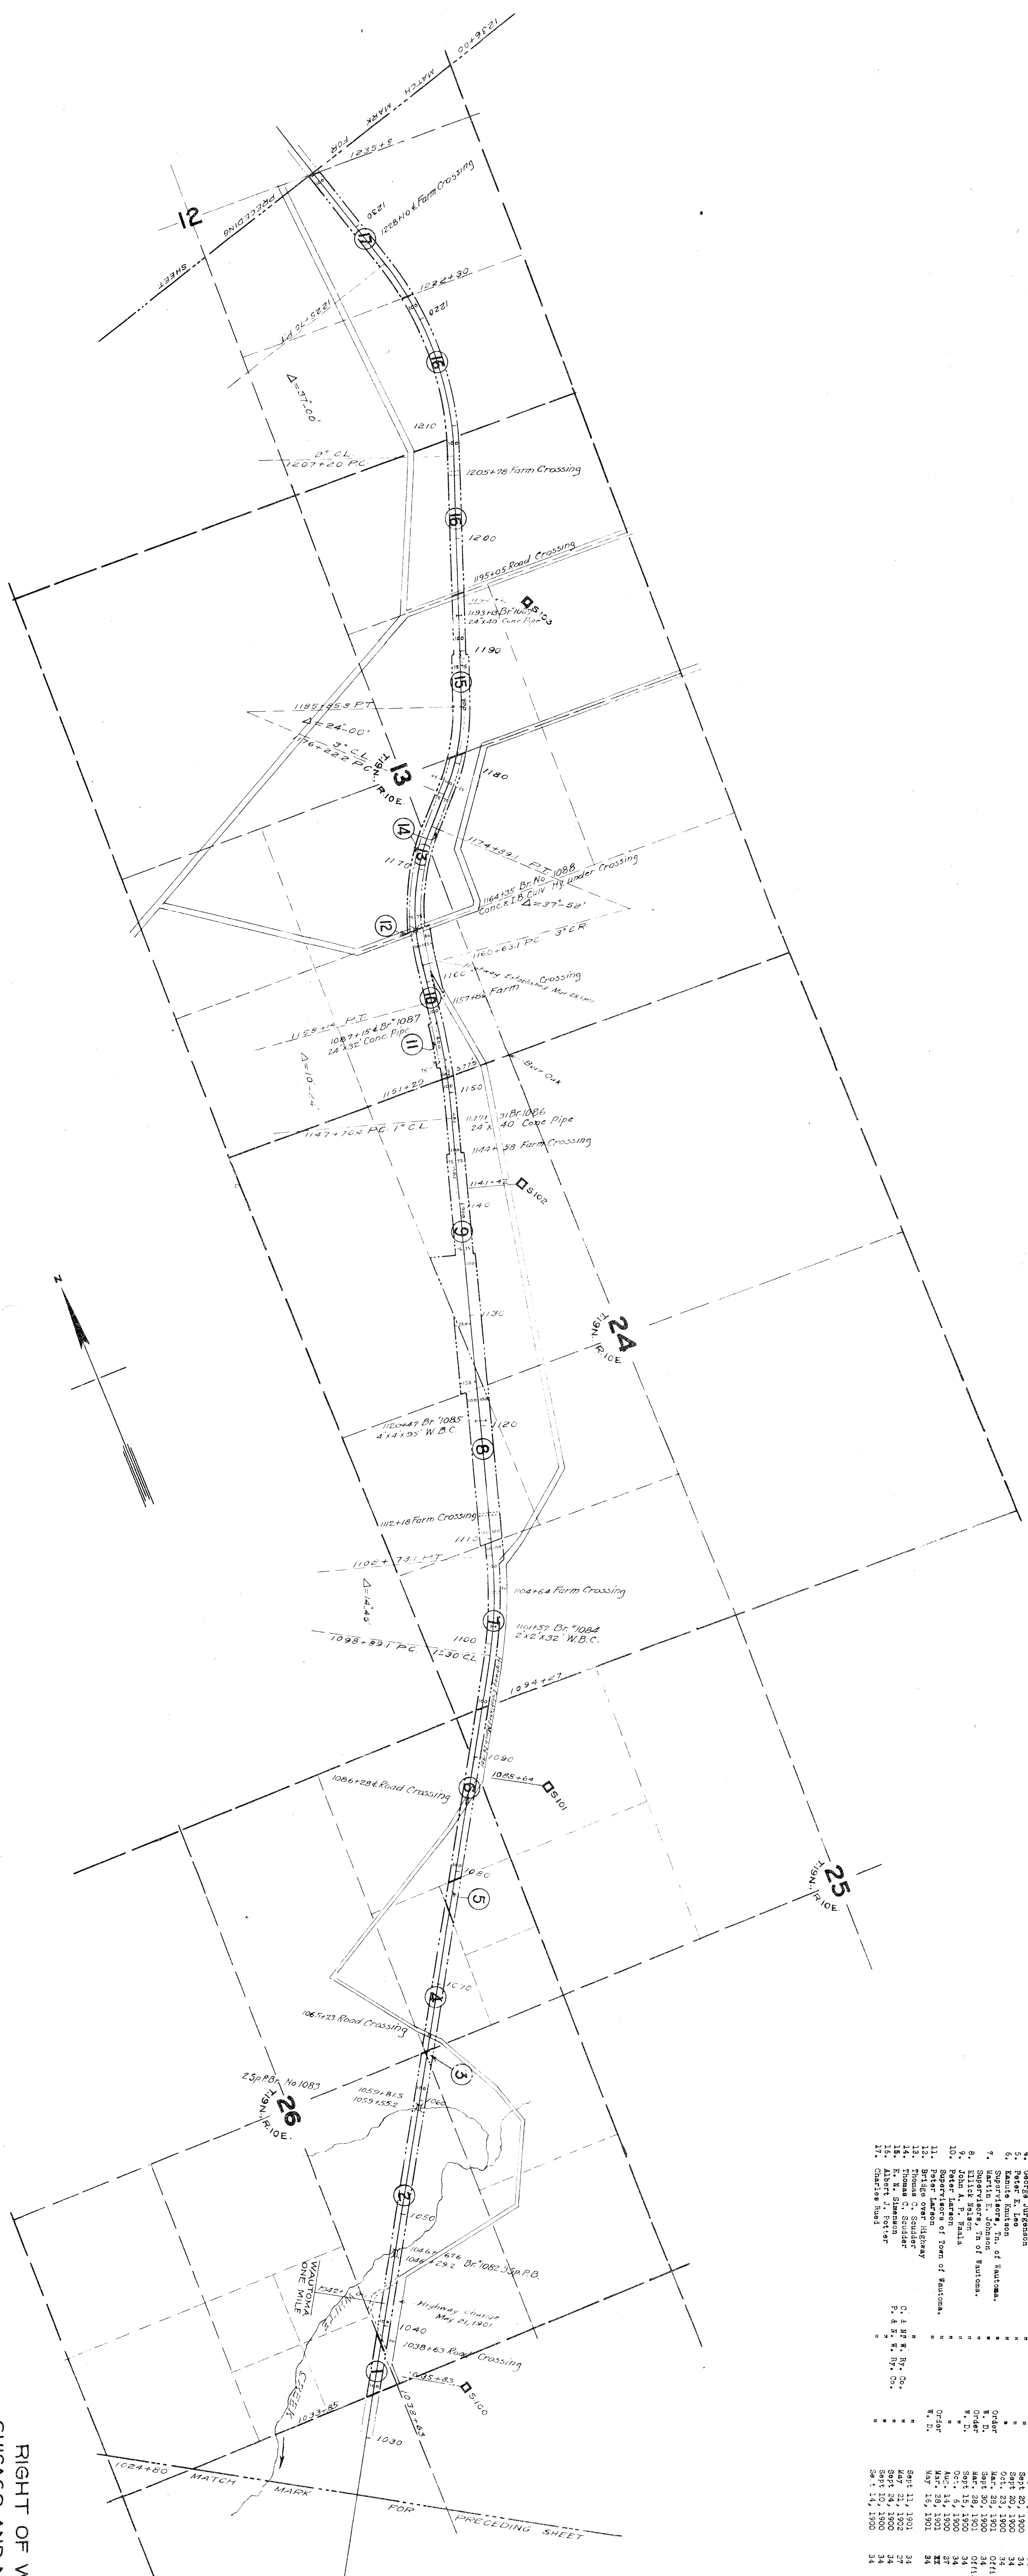

RIGHT OF WAY AND TRACK MAP
CHICAGO AND NORTH-WESTERN RAILWAY
OPERATED BY THE
C.&N.W.RY. CO.

NORTHERN WISCONSIN DIVISION
PRINCETON, WIS. TO MARSHFIELD, WIS.
STA. 1024+80 TO STA. 1236+00
JUNE 30, 1917

Sheet No. 9, of 22, C. & N.W. Ry.
from Survey Station 1024+80
to Survey Station 1236+00
23-P. 4-S.
Validation Engineer
SCALE 1-IN = 400-FT.
OFFICE OF CHIEF ENGINEER
CHICAGO, ILL.