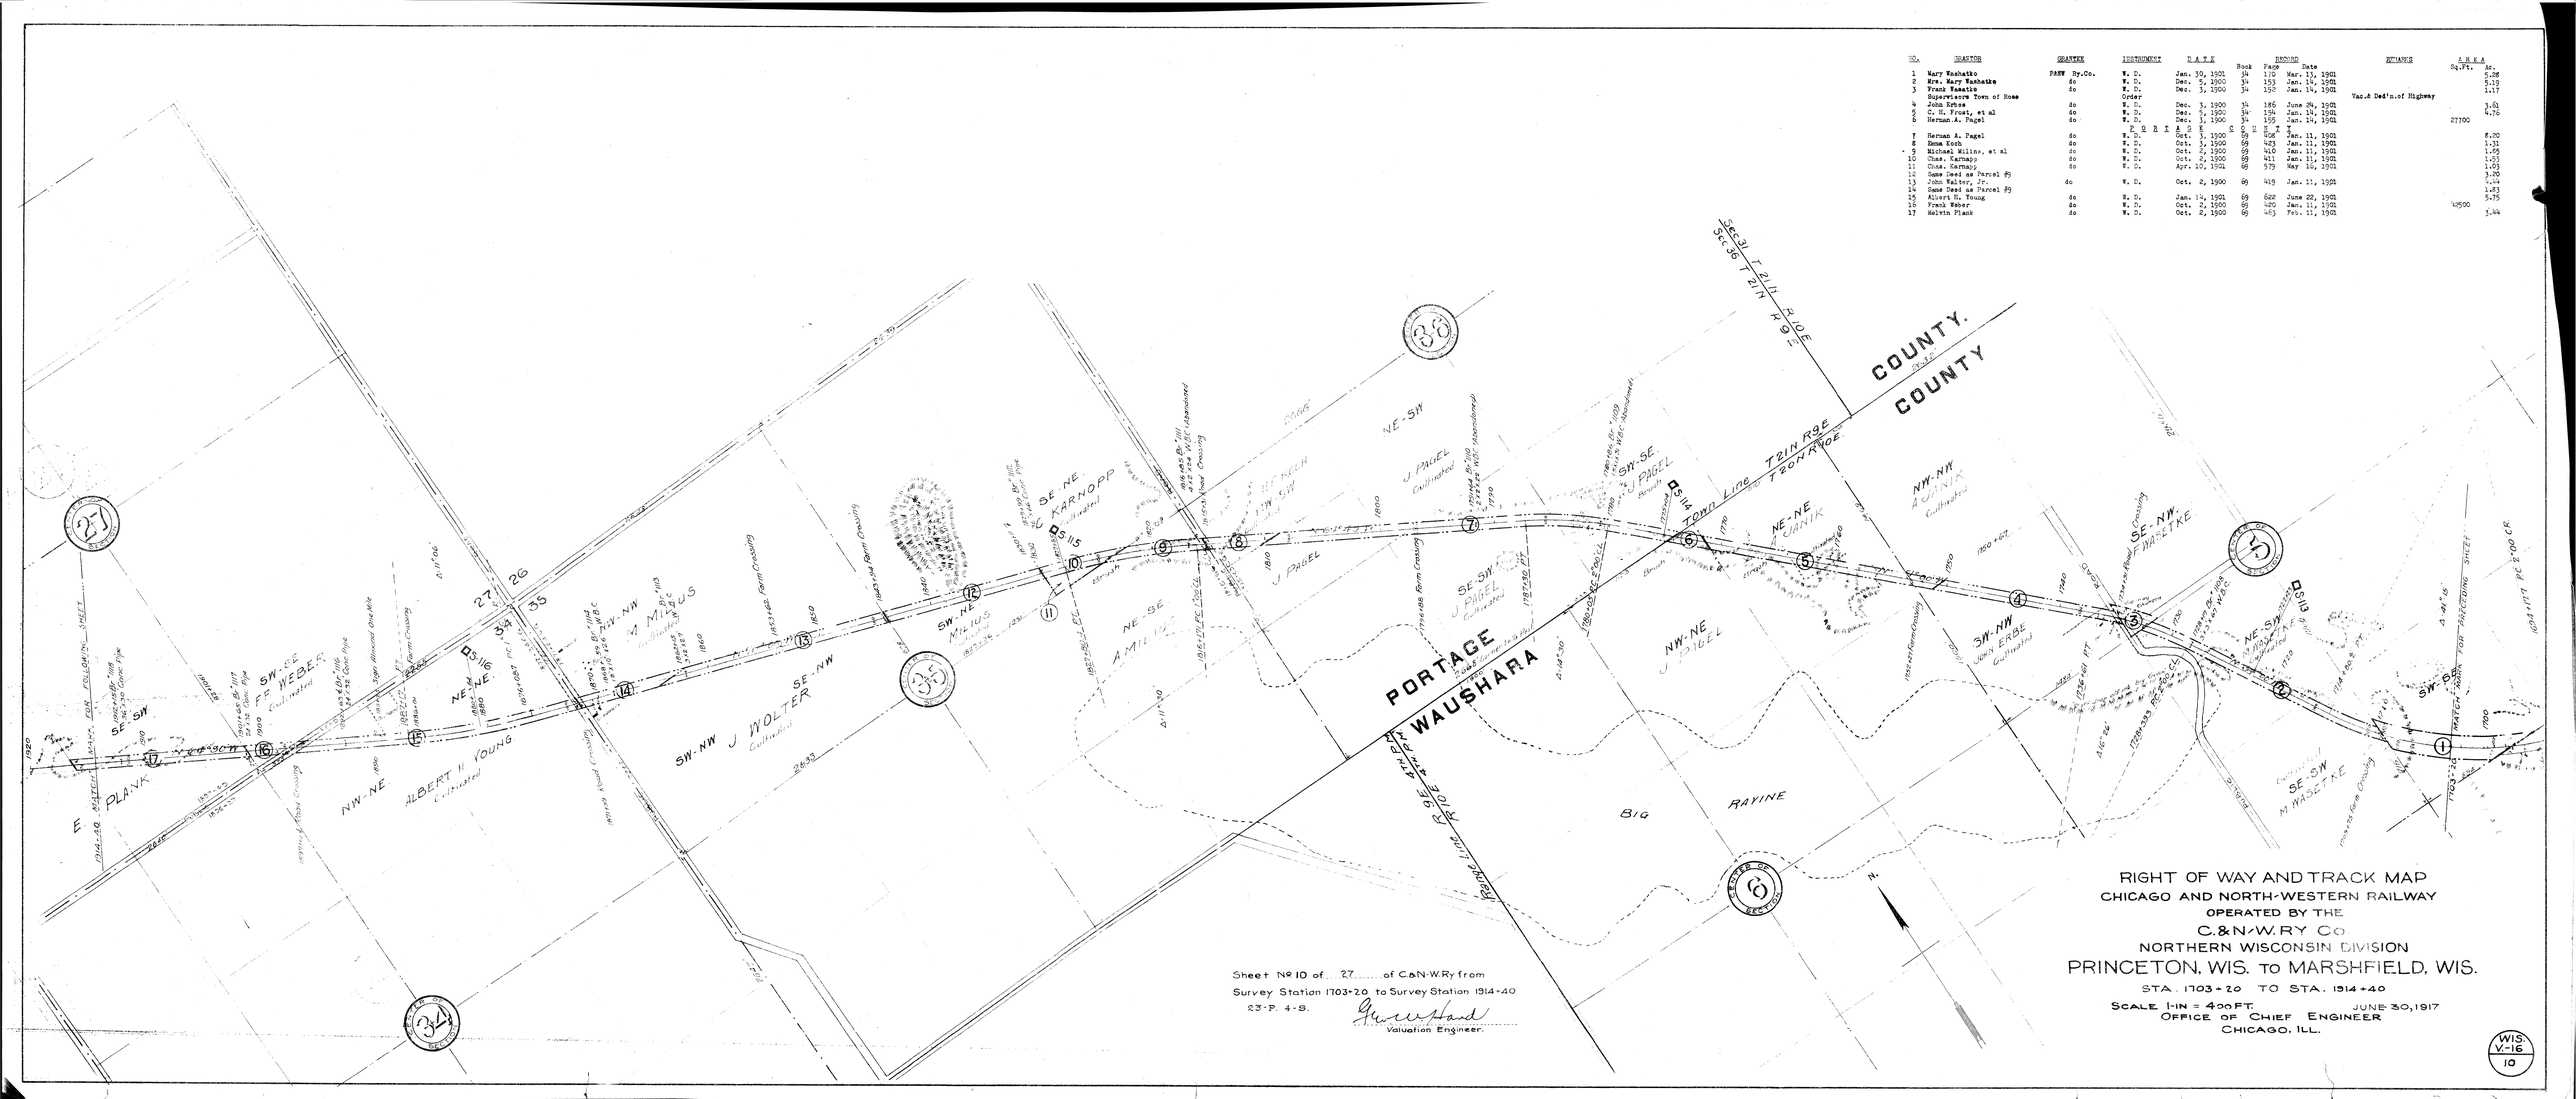

NO.	GRANTOR	GRANTEE	INSTRUMENT	DATE	RECORD Book	Page	Date	REMARKS	AREA Sq.Ft.	Ac.
1	Mary Kwabatko	PAWW Ry.Co.	W. D.	Jan. 30, 1901	34	170	Mar. 13, 1901			5.26
2	Mrs. Mary Kwabatko	do	W. D.	Dec. 5, 1900	34	153	Jan. 14, 1901			5.19
3	Frank Kwastic	do	W. D.	Dec. 3, 1900	34	152	Jan. 14, 1901			1.17
	Supervisors Town of Rose		Order					Var.& Ded'n.of Highway		
4	John Erbe	do	W. D.	Dec. 3, 1900	34	186	June 24, 1901			3.61
5	C. H. Frost, et al	do	W. D.	Dec. 5, 1900	34	154	Jan. 14, 1901			4.76
6	Herman A. Pagel	do	W. D.	Dec. 3, 1900	34	155	Jan. 14, 1901		27700	
			P O R T A G E	C O U N T Y						
7	Herman A. Pagel	do	W. D.	Oct. 3, 1900	69	408	Jan. 11, 1901			6.20
8	Emma Koch	do	W. D.	Oct. 3, 1900	69	423	Jan. 11, 1901			1.31
9	Michael Milius, et al	do	W. D.	Oct. 2, 1900	69	410	Jan. 11, 1901			1.55
10	Chas. Karnapp	do	W. D.	Oct. 2, 1900	69	411	Jan. 11, 1901			1.01
11	Chas. Karnapp	do	W. D.	Apr. 10, 1901	69	579	May 16, 1901			1.03
12	Same Deed as Parcel #9									3.20
13	John Kelley, Jr.	do	W. D.	Oct. 2, 1900	69	419	Jan. 11, 1901			1.44
14	Same Deed as Parcel #9									1.83
15	Albert H. Young	do	W. D.	Jan. 14, 1901	69	622	June 22, 1901			5.75
16	Frank Weber	do	W. D.	Oct. 2, 1900	69	420	Jan. 11, 1901		42500	
17	Melvin Plank	do	W. D.	Oct. 2, 1900	69	465	Feb. 11, 1901			3.44