


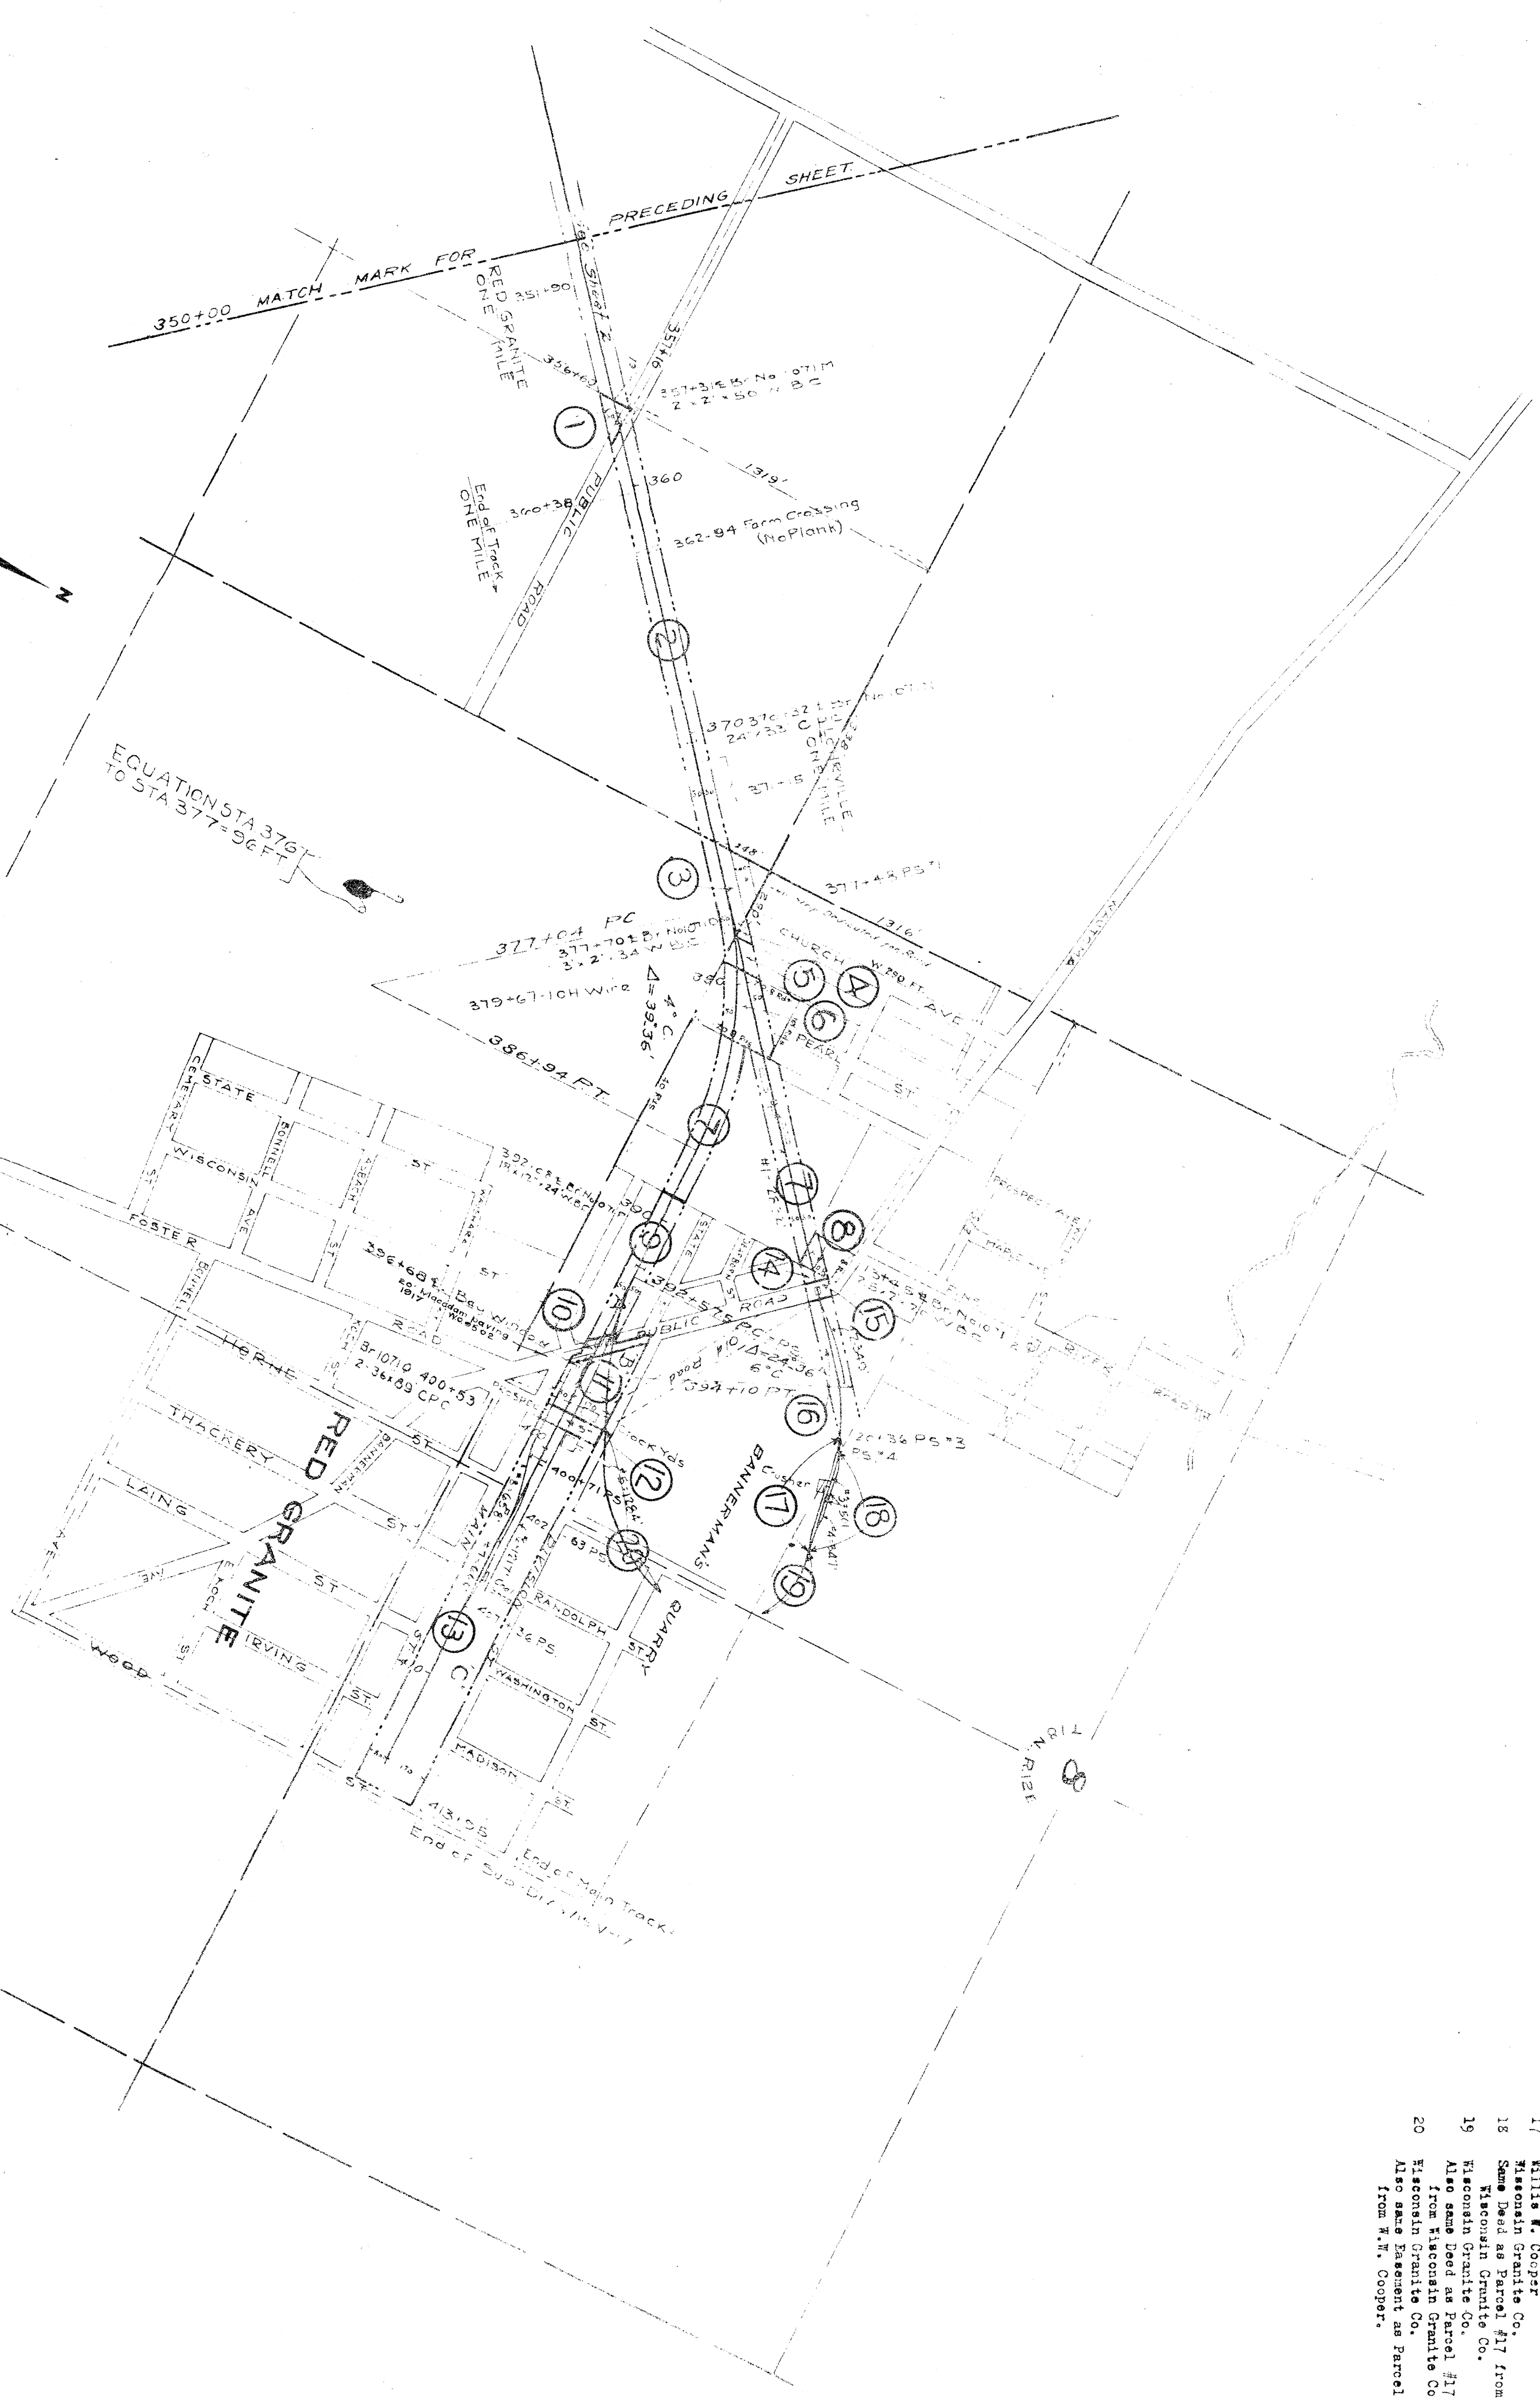

NO.	SECTION	OWNER	INSTRUMENT	DATE	BOOK	PAGE	RECORD	REMARKS
1	T. C. Bondell	Chas. Ry. Co.	W. D.	June 24, 1901	34	130	Aug. 15, 1901	
2	John H. Jackson, et al	do	W. D.	July 27, 1901	34	133	Aug. 15, 1901	
3	H. R. Barry, et al	do	W. D.	July 27, 1901	34	133	Aug. 15, 1901	
4	Passenger Title	Chas. Ry. Co.	W. D.	Nov. 6, 1901	34	207	Dec. 2, 1901	
5	F. R. Kasper	do	W. D.	Nov. 6, 1901	27	439	Dec. 2, 1901	
6	Alfred E. Wilson, et al	Chas. Ry. Co.	W. D.	Sept. 17, 1901	34	205	Oct. 11, 1901	
7	W. H. R. Cooper, et al	Chas. Ry. Co.	W. D.	Sept. 17, 1901	34	205	Oct. 11, 1901	
8	Same Deed as Parcel 10							
9	Same Deed as Parcel 10							
RIGHT OF WAY AND TRACK MAP
CHICAGO AND NORTH-WESTERN RAILWAY
OPERATED BY THE
C. & N-W. RY. CO.
NORTHERN WISCONSIN DIVISION
BANNERMAN, WIS. TO RED GRANITE, WIS.
STA. 350+00 TO STA. 413+95

Scale 1" = 400 FT.
JUNE 30, 1917
OFFICE OF CHIEF ENGINEER
CHICAGO, ILL.