


Noted C.M.C. Jan 20, 1917.
Recorded C.M.C. Feb. 5, 1917.
Recorded E.P.L. Feb. 7, 1917.

WISCONSIN RIVER

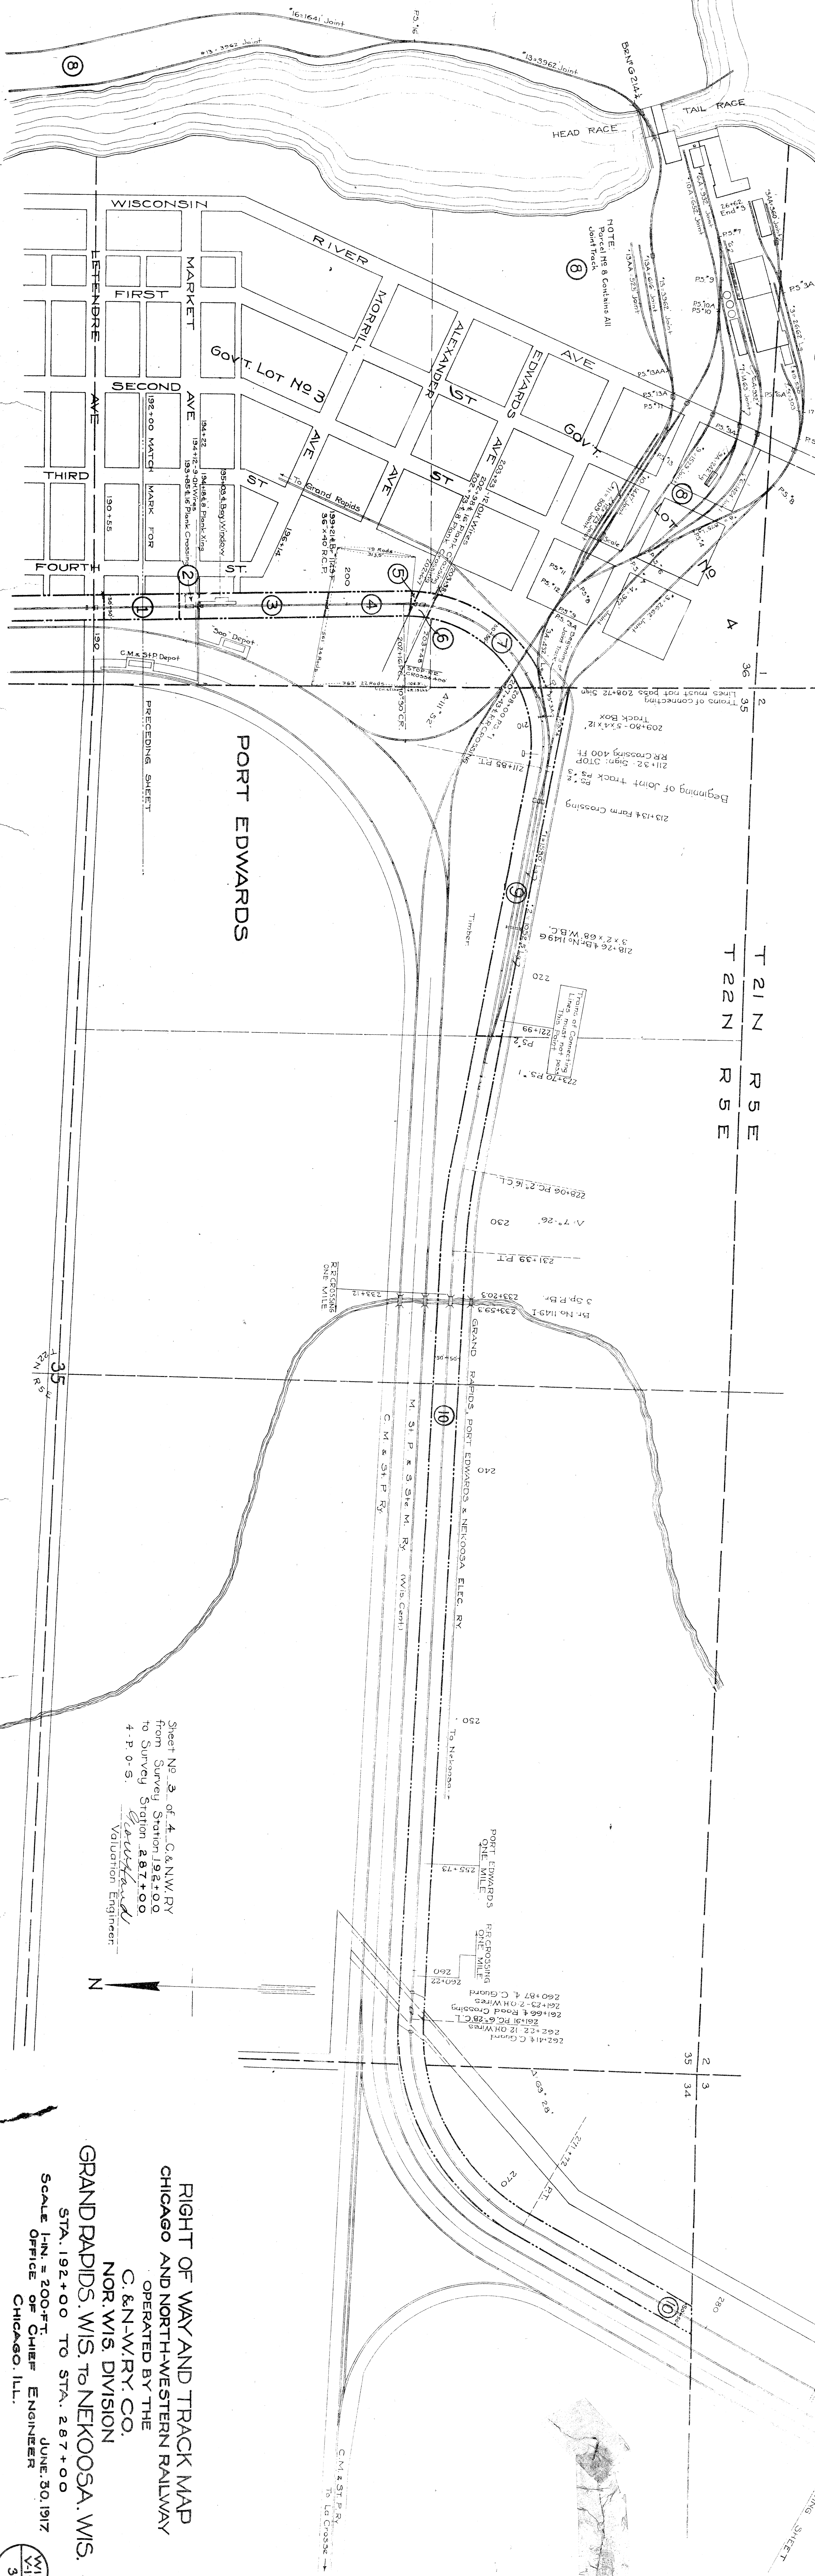

NO.	GRANTOR	GRANTEE	INSTRUMENT	D.A.T.E.	BOOK	PAGE	DATE	REMARKS
1	John Edwards & Co.	PAW Ry. Co.	W. D.	Nov. 1, 1901	95	156	Nov. 29, 1901	Subj. to public use as Street 8000

Sheet No. 3, of 4 C. & N.W. Ry.
from Survey Station 192+00
to Survey Station 287+00
4-P.O.S.
Valuation Engineer

RIGHT OF WAY AND TRACK MAP
CHICAGO AND NORTH-WESTERN RAILWAY
OPERATED BY THE
C. & N.W. RY. CO.
NOR. WIS. DIVISION
GRAND RAPIDS, WIS. TO NEKOOSA, WIS.

STA. 192+00 TO STA. 287+00
SCALE 1-IN. = 200-FT.
JUNE 30, 1917
OFFICE OF CHIEF ENGINEER
CHICAGO, ILL.

