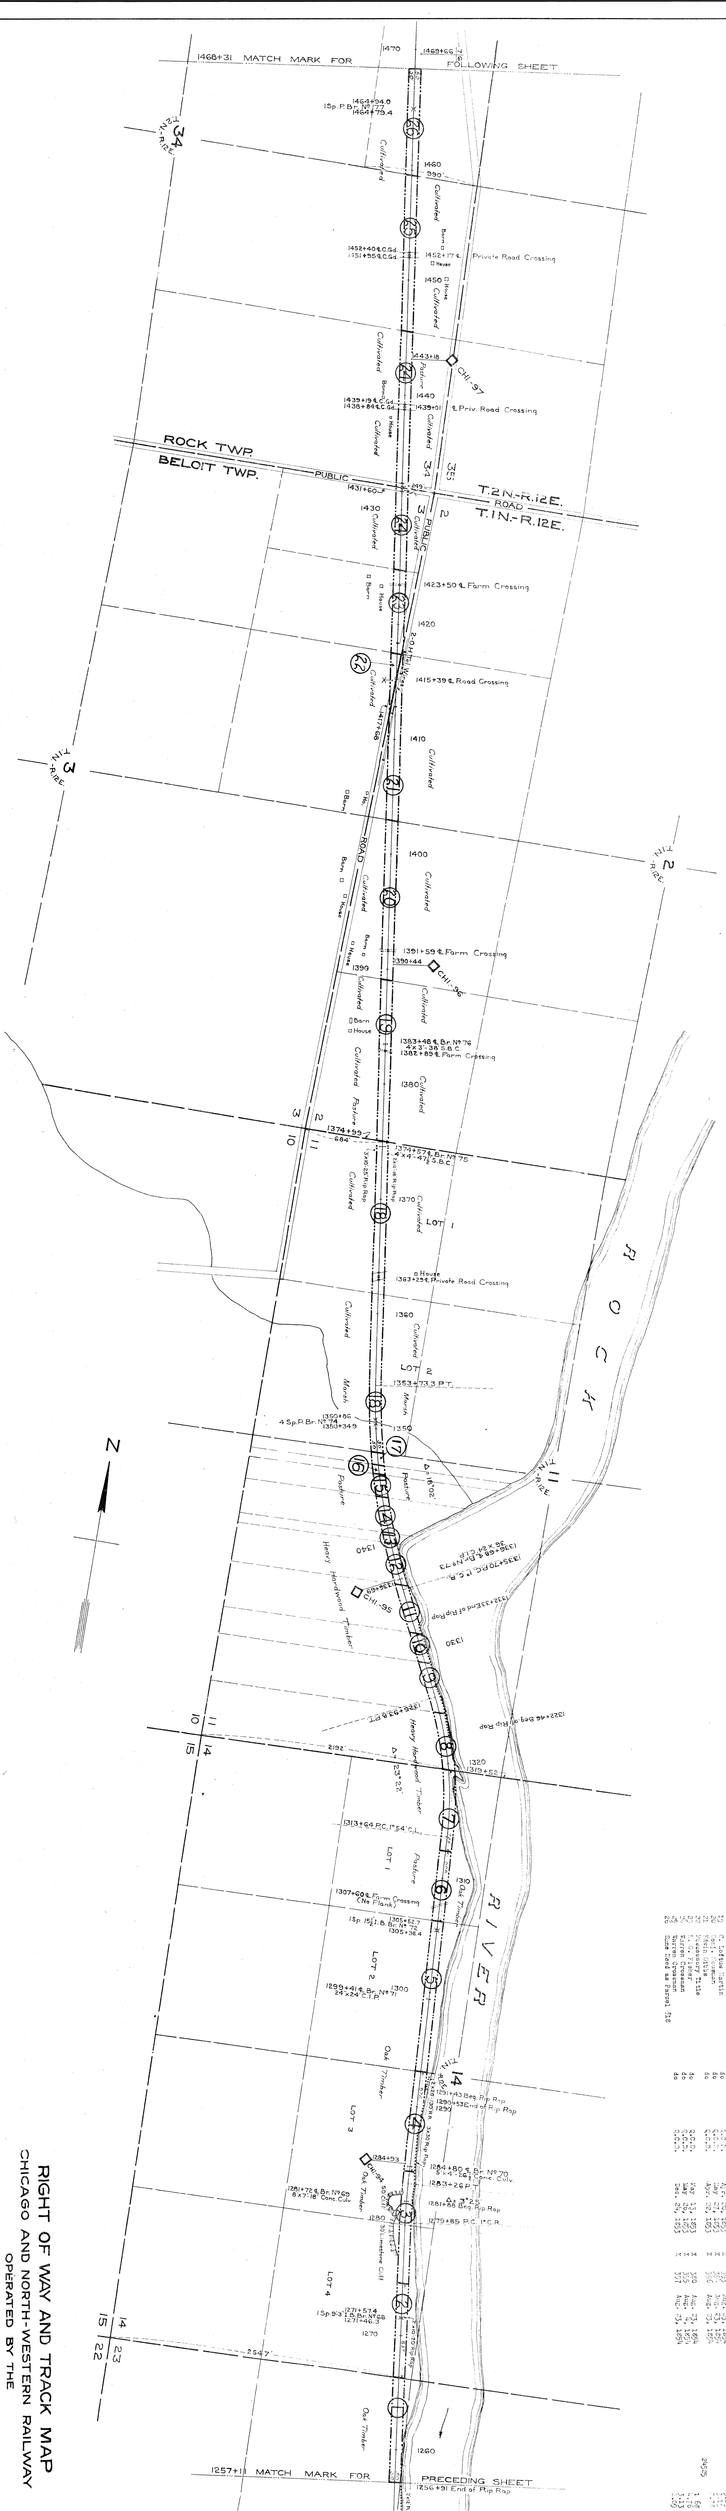

PLOTTED - R.A.W. - JAN. 24, 1917
TRACED - C.V.V. - JAN. 25, 1917
CHECKED - C.V.V. - FEB. 23, 1917

Sheet No. 2 of 12 C. & N.W. Ry
from Survey Station 1257+11
to Survey Station 1468+31
7-P. 3 G.

Valuation Engineer

RIGHT OF WAY AND TRACK MAP
CHICAGO AND NORTH-WESTERN RAILWAY
OPERATED BY THE
C. & N.W. RY. CO.
MADISON DIVISION

BELOIT, WIS. to EVANSVILLE, WIS.
STA. 1257+11 TO STA. 1468+31

SCALE 1 IN. = 400 FT.
OFFICE OF CHIEF ENGINEER,
CHICAGO, ILL.
JUNE 30, 1917

WIS V-19 2