


Plotted CMCC
Checked H.W.L.
Map 30, 1917

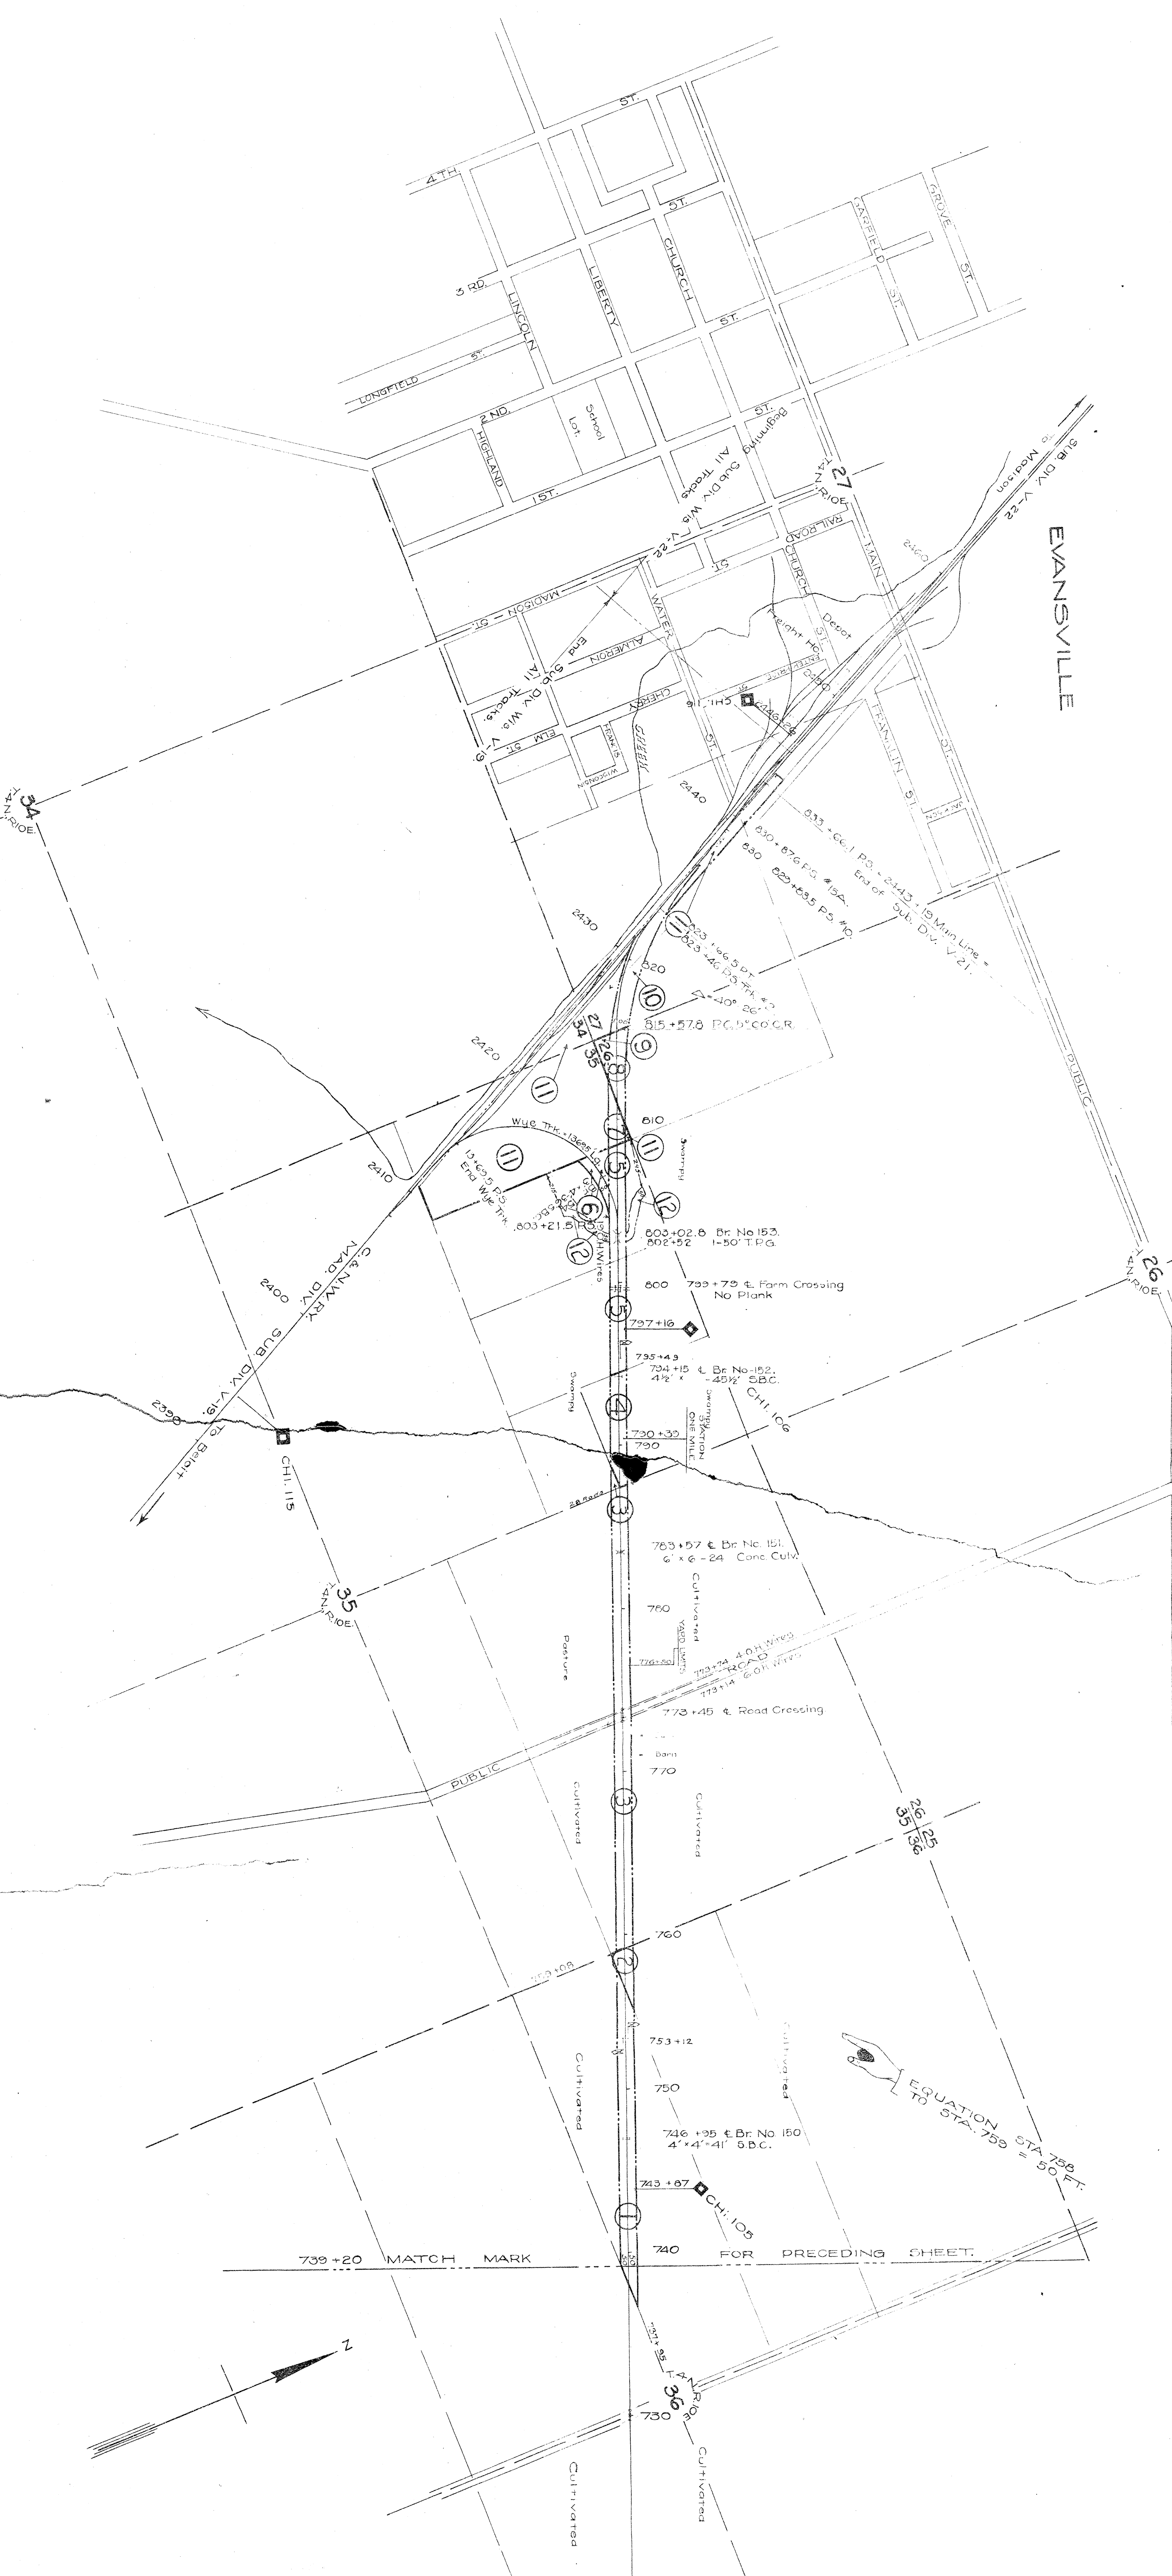


RIGHT OF WAY AND TRACK MAP
CHICAGO AND NORTH-WESTERN RAILWAY
OPERATED BY THE
C. & N. W. RY. CO.
MADISON DIVISION
JANESVILLE, WIS. TO EVANSVILLE, WIS.
STA. 759+20 TO STA. 835+00
SCALE: 1 IN. = 400 FT.
JUNE 30, 1917
OFFICE OF CHIEF ENGINEER
CHICAGO, ILL.