No	GRANTOR	GRANTEE	INSTRUMENT	DATE	BOOK	PAGE	RECORDED Date	REMARKS	AREA Sq.Ft.	AREA Ac.
1	Charles L. Roe	C&NW Ry Co.	W. D.	May 14, 1872	39	627	June 3, 1872		-	4.88
2	H. J. Miller	C&St.P. & C&NW	W. D.	Aug. 4, 1894	87	92	Aug. 10, 1894		-	4.10
3	Possessory Title							Held by adverse possession since 1872	22000	
4	Same deed as pcl. 1									
5	Possessory Title							Held by adverse possession since 1872	22000	3.70
6	W. A. Anderson	C&NW Ry Co.	W. D.	Sept.4, 1875	47	4	Sept.27, 1875			5.62
7	John A. Cassel	"	W. D.	July 10,1872	41	119	Aug. 7, 1872			2.85
8	Ann Halpin	"	W. D.	June 18,1872	41	54	June 19, 1872			3.24
9	Julius Wolf	"	W. D.	July 17,1872	41	128	July 17, 1872			3.05
10	Louis Wolf, Jr.	"	W. D.	July 27,1872	41	176	Aug. 10, 1872		39500	
11	F. Uthlaut	"	W. D.	July 13,1872	41	170	Aug. 7, 1872		39500	
12	August Koontz	"	W. D.	July 19,1872	41	171	Aug. 7, 1872		39500	
13	August Wolf	"	W. D.	July 19,1872	41	174	Aug. 7, 1872		39500	
14	Michael Kirchhammer	"	W. D.	June 18, 1872	41	53	June 19, 1872		27000	
15	Joseph & Frank Wolf	"	W. D.	June 18,1872	41	56	June 19, 1872		27000	
16	Wm. Koenig	"	W. D.	July 10,1872	41	122	July 15, 1872		27000	
17	Frederick Kiel	"	W. D.	July 18,1872	41	170	Aug. 7, 1872		23500	
18	John Dawson	"	W. D.	June 21,1872	41	120	July 15, 1872		26400	
19	Peter Ghingen	"	W. D.	July 10,1872	41	125	July 15, 1872			6.15
20	C. Henry Schafarneyer	"	W. D.	July 10,1872	41	127	July 15, 1872			5.00
21	Frederick Peters	"	D.	June 11,1872	41	21	June 17, 1872			7.19
22	Frederika Peters	"	W. D.	June 7, 1894	87	78	Aug. 4, 1894		8720	
23	Frederick Peters	"	W. D.	June 7, 1894	87	79	Aug. 4, 1894		38629	
24	John Kight	"	W. D.	May 22, 1872	39	622	May 29, 1872			1.21

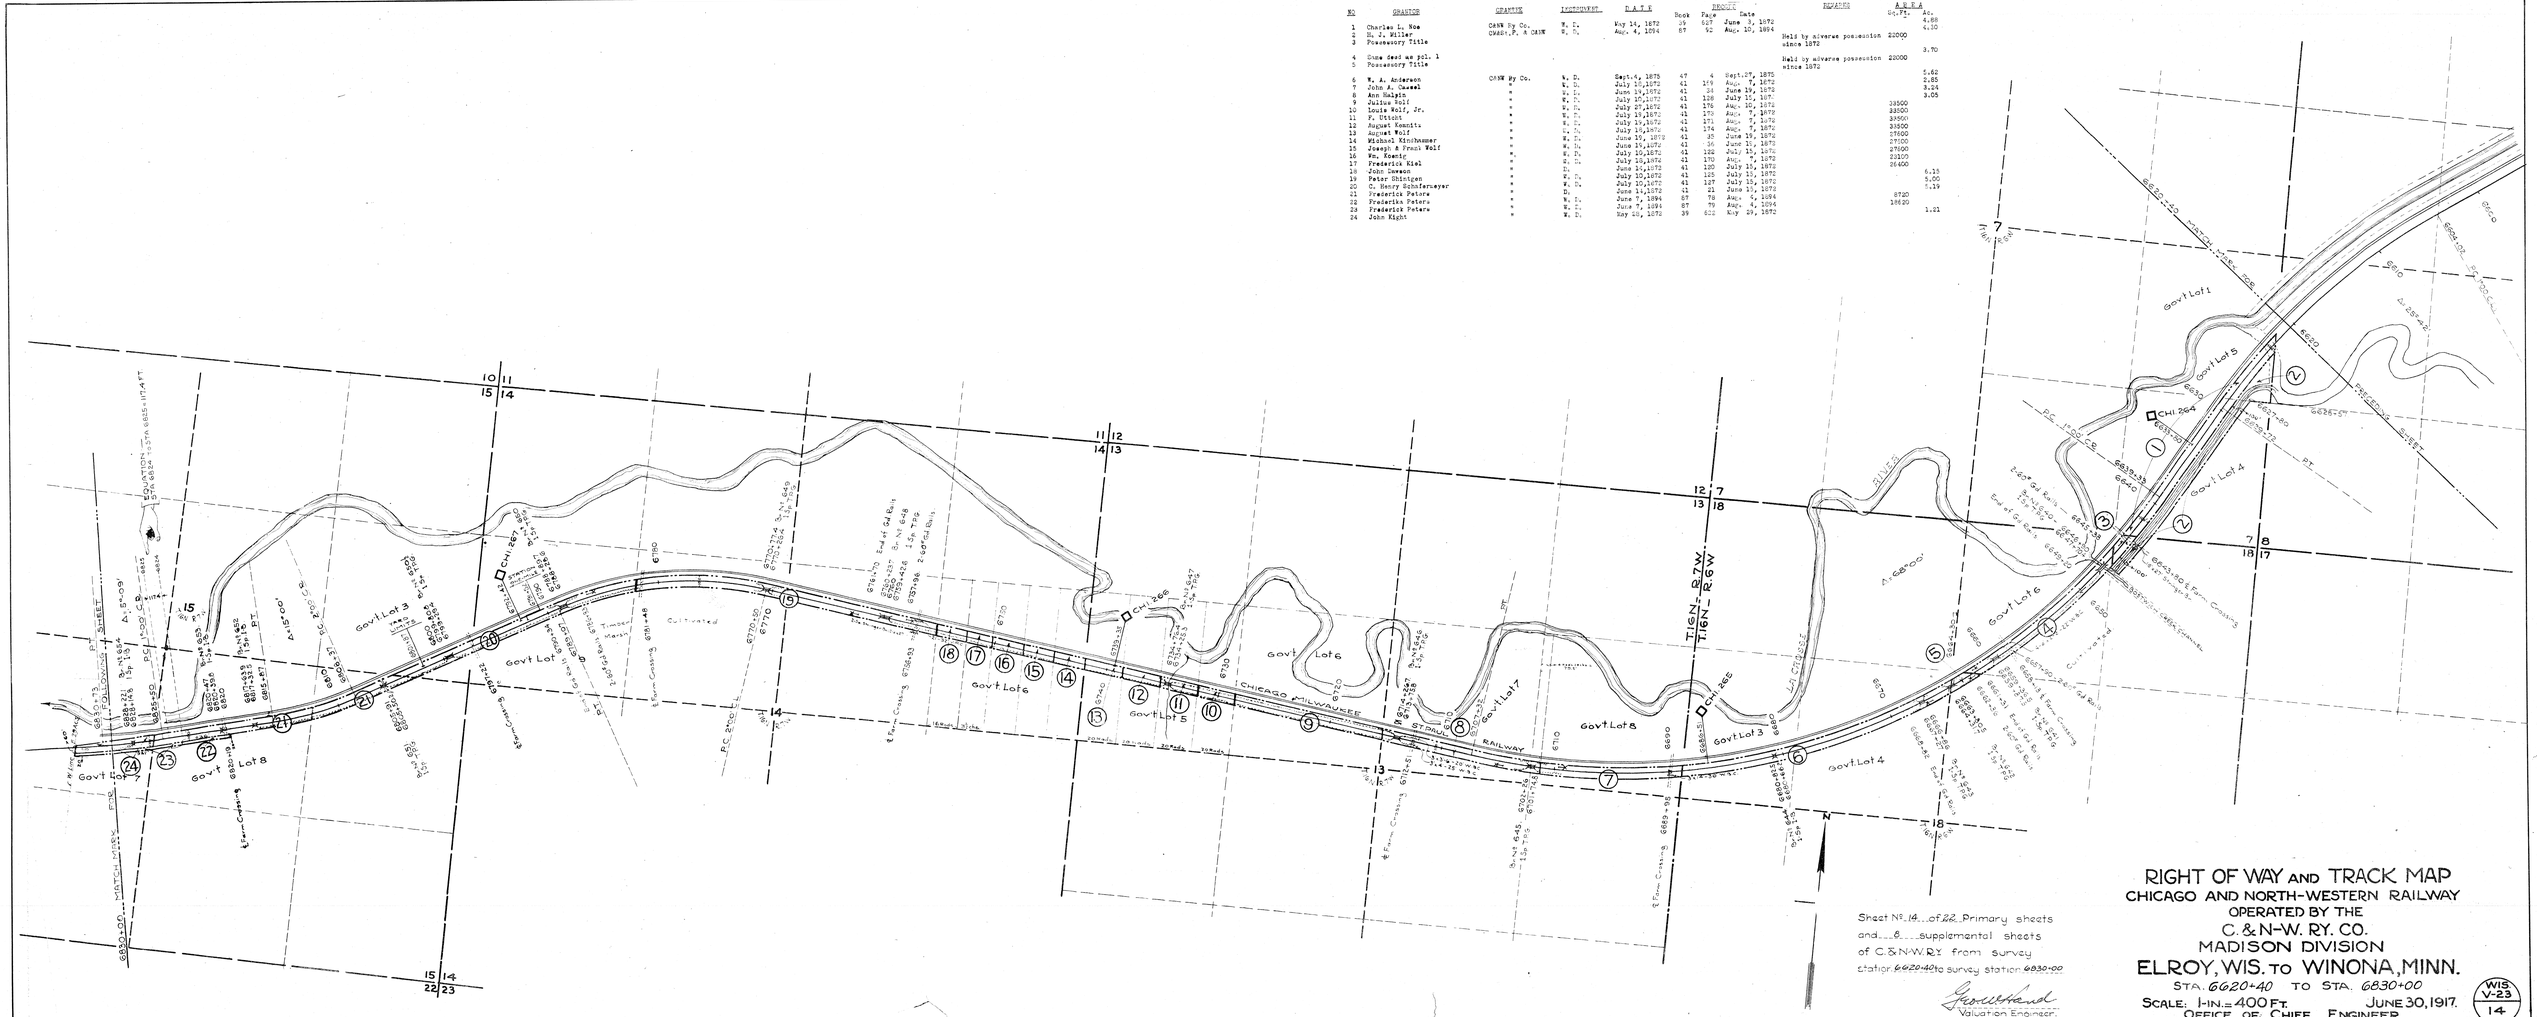

Sheet No. 14 of 22 Primary sheets
and 8 supplemental sheets
of C.&N-W.Ry. from survey
station 6620+40 to survey station 6830+00

Valuation Engineer.

RIGHT OF WAY AND TRACK MAP
CHICAGO AND NORTH-WESTERN RAILWAY
OPERATED BY THE
C. & N-W. RY. CO.
MADISON DIVISION
ELROY, WIS. to WINONA, MINN.
STA. 6620+40 TO STA. 6830+00
SCALE: 1 IN. = 400 FT. JUNE 30, 1917.
OFFICE OF CHIEF ENGINEER
CHICAGO, ILL.

WIS V-23 14

PLATTED - W.M.G. - JULY 27, 1917
TRACED - R.A.N. - AUG. 8, 1917
CHECKED