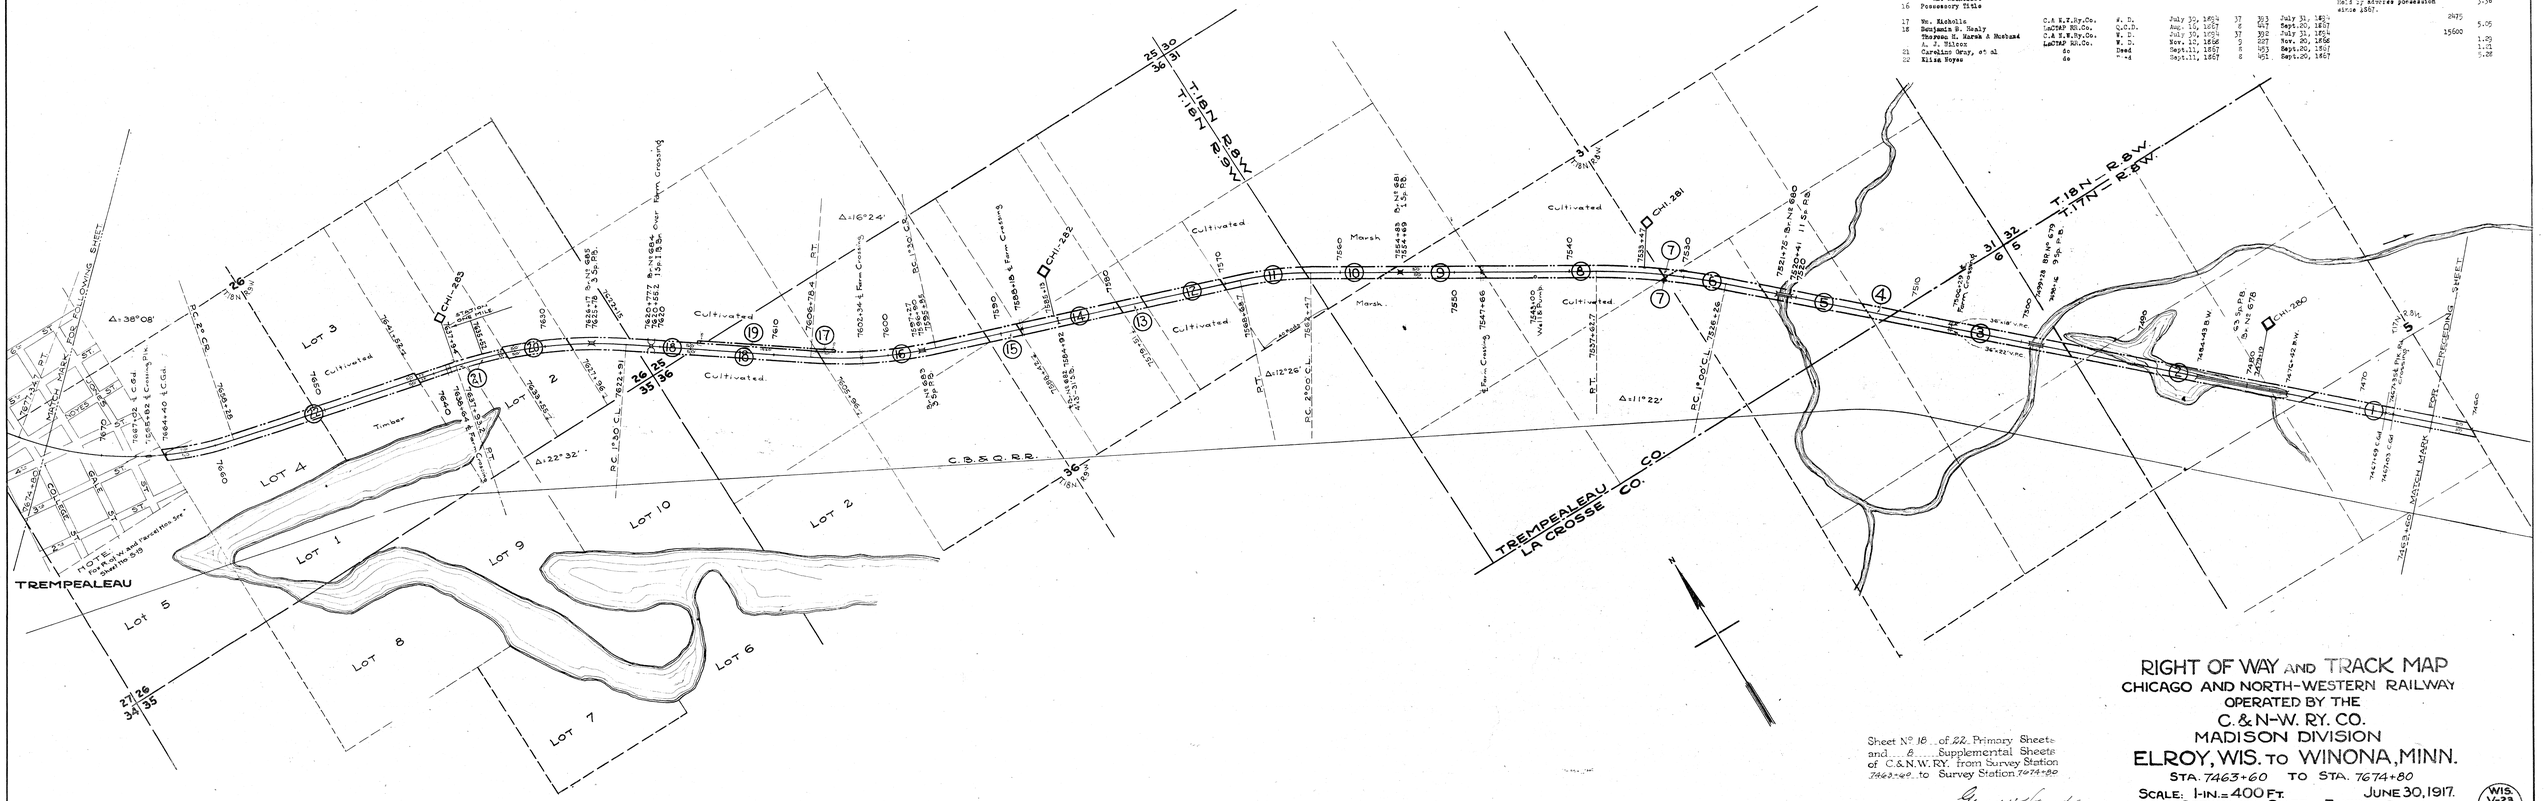


| No. | Tract | Grantor | Instrument | Date | Record Book | Record Page | Date | Remarks | Area Sq.Ft. | Area Ac. |
|---|---|---|---|---|---|---|---|---|---|---|
| 1 | Possessory Title | | | | | | | Held by adverse possession since 1856. | | 1.38 |
| 2 | Benj. D. Healey | LaCTAP RR.Co. | Q.C.D. | Aug. 16, 1867 | 32 | 90 | Sept.12, 1867 | | | 4.88 |
| 3 | Mary Brandenberg | do | Q.C.D. | Sept. 9, 1867 | 32 | 89 | Sept.19, 1867 | | | 1.65 |
| | | | & THENCE ALEAU COUNTY | | | | | | | |
| 4 | A. M. Brandenberg | do | Q.C.D. | Sept. 9, 1867 | 8 | 441 | 1867 | | 20000 | |
| 5 | Edward Harnard | do | Deed | Aug. 16, 1867 | 8 | 442 | Sept.20 1867 | | | 2.21 |
| 6 | John C. Tower | do | Deed | Aug. 16, 1867 | 8 | 454 | Sept.20, 1867 | | | 1.91 |
| 7 | Possessory Title | | | | | | | Held by adverse possession since 1856. | 6700 | |
| 8 | James Dolan | do | Q.C.D. | Aug. 16, 1867 | 8 | 445 | Sept.20, 1867 | | | 1.58 |
| | Jacob T. Holmes | do | Q.C.D. | Aug. 16, 1867 | 8 | 446 | Sept.20, 1867 | | | |
| 9 | Charles T. Holmes | do | Deed | Aug. 16, 1867 | 8 | 447 | Sept.20, 1867 | | | 1.05 |
| 10 | Charles H. Angell | do | Deed | Aug. 10, 1867 | 8 | 440 | Sept.20, 1867 | | | 1.56 |
| 11 | Henry R. Sparks | do | Deed | Aug. 10, 1867 | 8 | 439 | Sept.20, 1867 | | | 1.05 |
| | Wm. Nicholls | do | Q.C.D. | Aug. 10, 1867 | 8 | 451 | Sept.20, 1867 | | | |
| 12 | John Nicholls | do | Deed | Aug. 10, 1867 | 8 | 450 | Sept.20, 1867 | | | 1.63 |
| | Also Same Deed as Parcel #11 from Wm. Nicholls. | | | | | | | | 22100 | |
| 13 | Same Deed as Parcel #12 from John Nicholls | | | | | | | | | |
| 14 | Oliver L. Dibble, et al | do | Q.C.D. | Aug. 16, 1867 | 8 | 446 | Sept.20, 1867 | | | 2.04 |
| 15 | Same Deed as Parcel #11 from Wm. Nicholls. | | | | | | | | 28800 | |
| 16 | Possessory Title | | | | | | | Held by adverse possession since 1867. | | 3.36 |
| 17 | Wm. Nicholls | C.& N.W.Ry.Co. | W. D. | July 30, 1864 | 37 | 303 | July 31, 1854 | | 2475 | |
| 18 | Benjamin H. Healy | LaCTAP RR.Co. | Q.C.D. | Aug. 16, 1867 | 8 | 447 | Sept.20, 1867 | | | 5.05 |
| | Thereon H. Marsh & Husband | C.& N.W.Ry.Co. | W. D. | July 30, 1864 | 37 | 302 | July 31, 1854 | | 19600 | |
| | A. J. Wilcox | LaCTAP RR.Co. | W. D. | Nov. 12, 1856 | 9 | 227 | Nov. 20, 1856 | | | 1.29 |
| 21 | Caroline Gray, et al | do | Deed | Sept.11, 1867 | 8 | 453 | Sept.20, 1867 | | | 1.21 |
| 22 | Silas Noyes | do | Deed | Sept.11, 1867 | 8 | 451 | Sept.20, 1867 | | | 1.28 |

Sheet No 18 of 22 Primary Sheets and 8 Supplemental Sheets of C.&N.W.RY. from Survey Station 7463+60 to Survey Station 7674+80

Valuation Engineer

# RIGHT OF WAY AND TRACK MAP
## CHICAGO AND NORTH-WESTERN RAILWAY
OPERATED BY THE
## C. & N-W. RY. CO.
## MADISON DIVISION
## ELROY, WIS. TO WINONA, MINN.
STA. 7463+60 TO STA. 7674+80

SCALE: 1-IN.= 400 FT. JUNE 30, 1917.

OFFICE OF CHIEF ENGINEER
CHICAGO, ILL.

WIS. V-23 18

PLATTED—B.B.N.—AUG. 8 1917.
TRACED—E.A.N.—AUG. 8. 1917.
CHECKED—B.B.N.—AUG. 29, 1917.