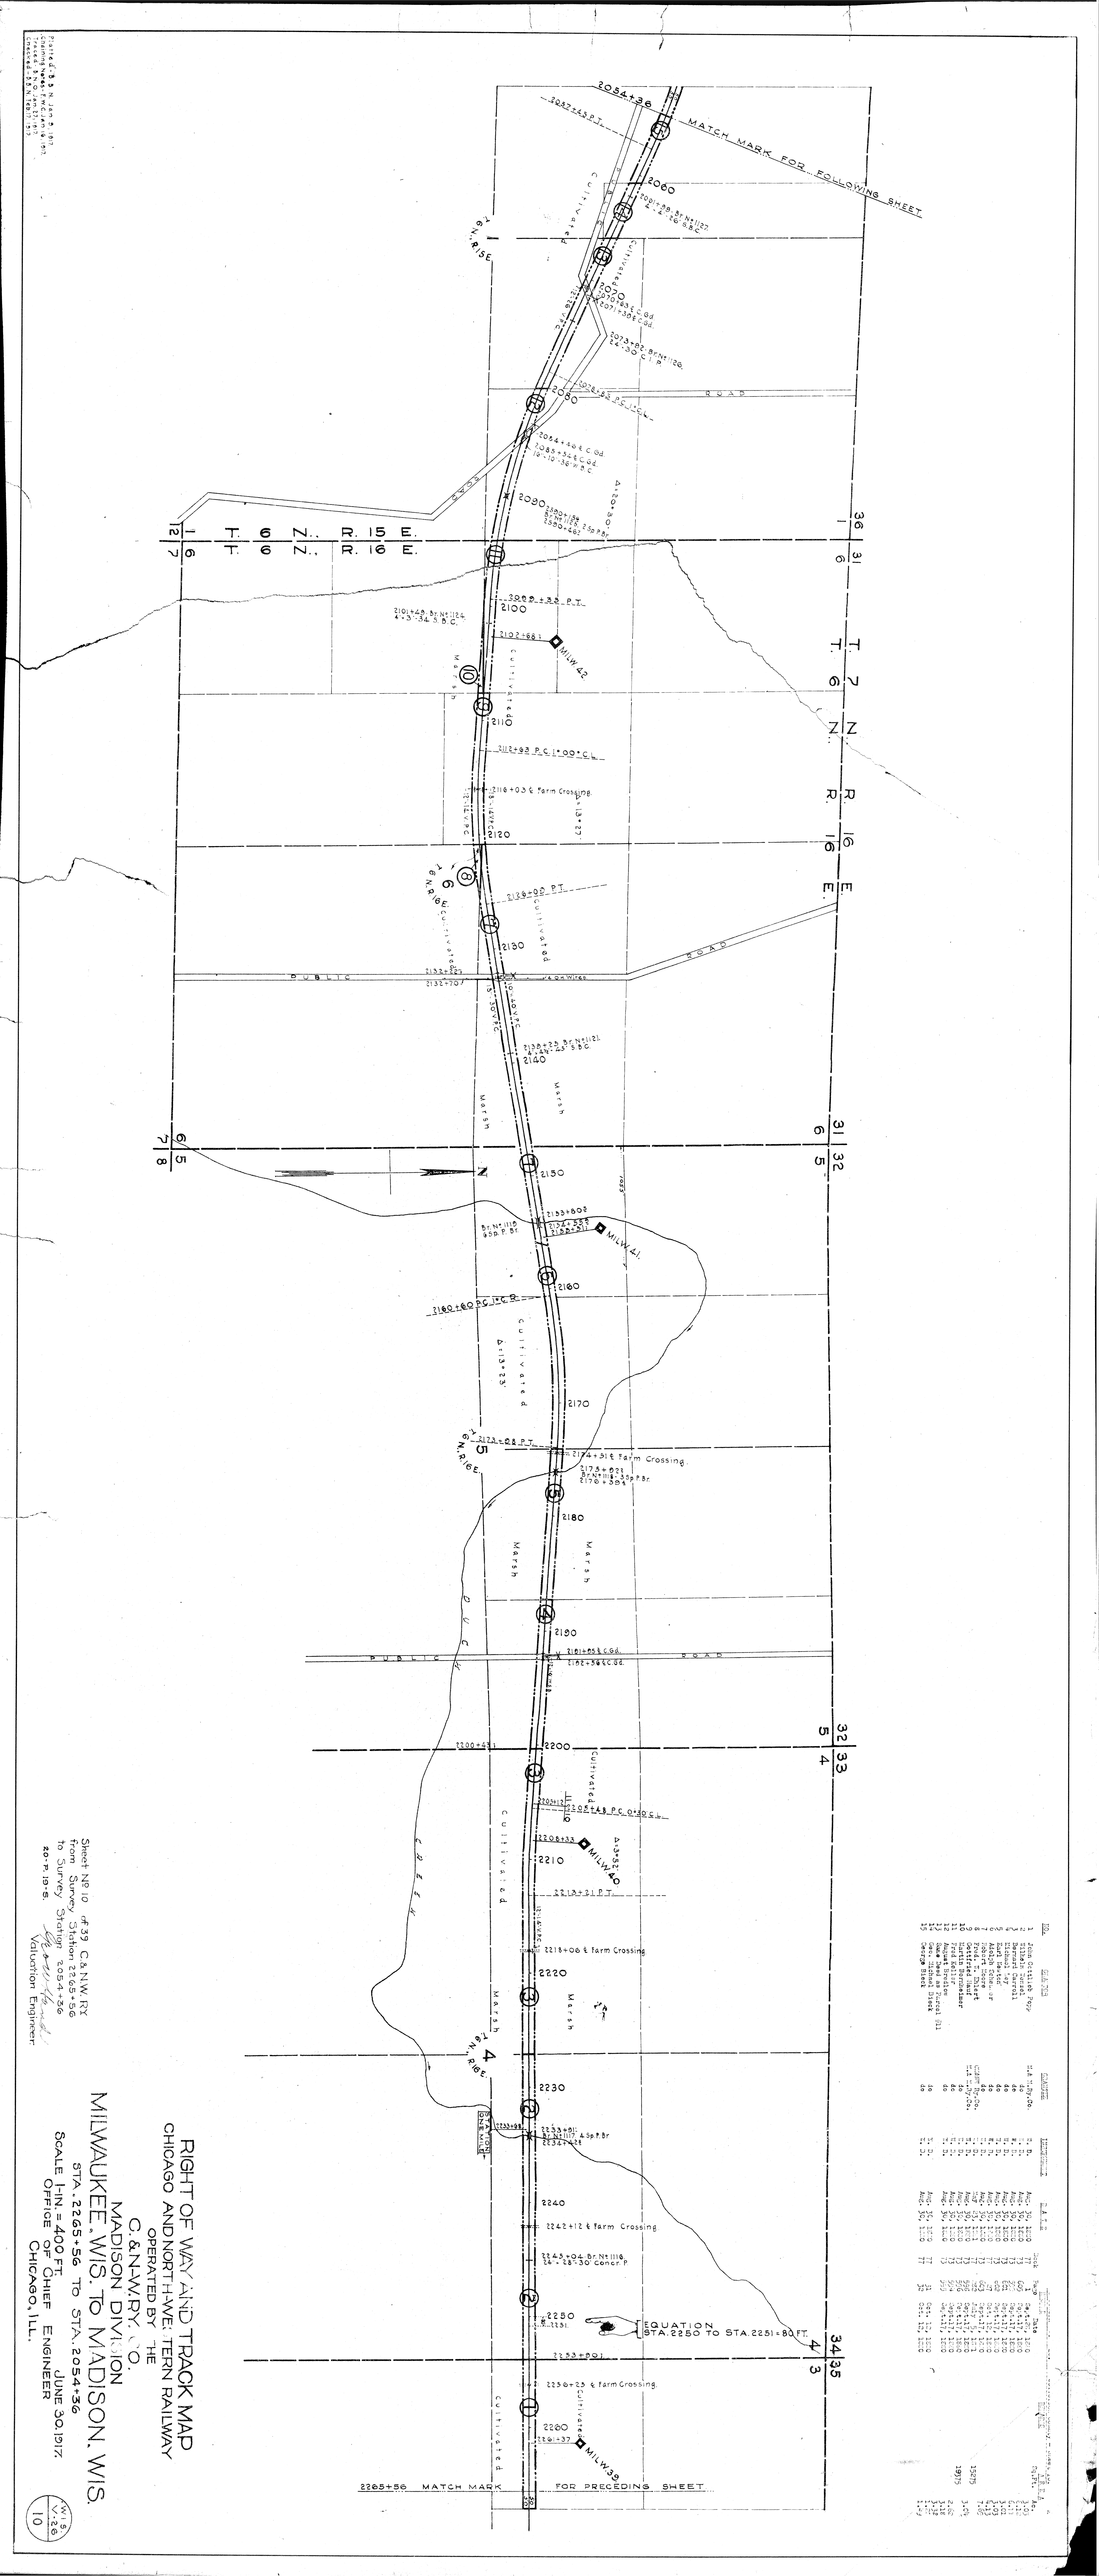

RIGHT OF WAY AND TRACK MAP

CHICAGO AND NORTH WESTERN RAILWAY

OPERATED BY THE

C. & N. W. RY. CO.

MADISON DIVISION

MILWAUKEE, WIS. TO MADISON, WIS.

STA. 2265+56 TO STA. 2054+36

SCALE 1-IN. = 400 FT.

JUNE 30, 1917.

OFFICE OF CHIEF ENGINEER

CHICAGO, ILL.

Sheet No. 10 of 39 C. & N.W. RY.
from Survey Station 2265+56
to Survey Station 2054+36
20-P. 19-18.

Valuation Engineer

(W.S. V.129 10)