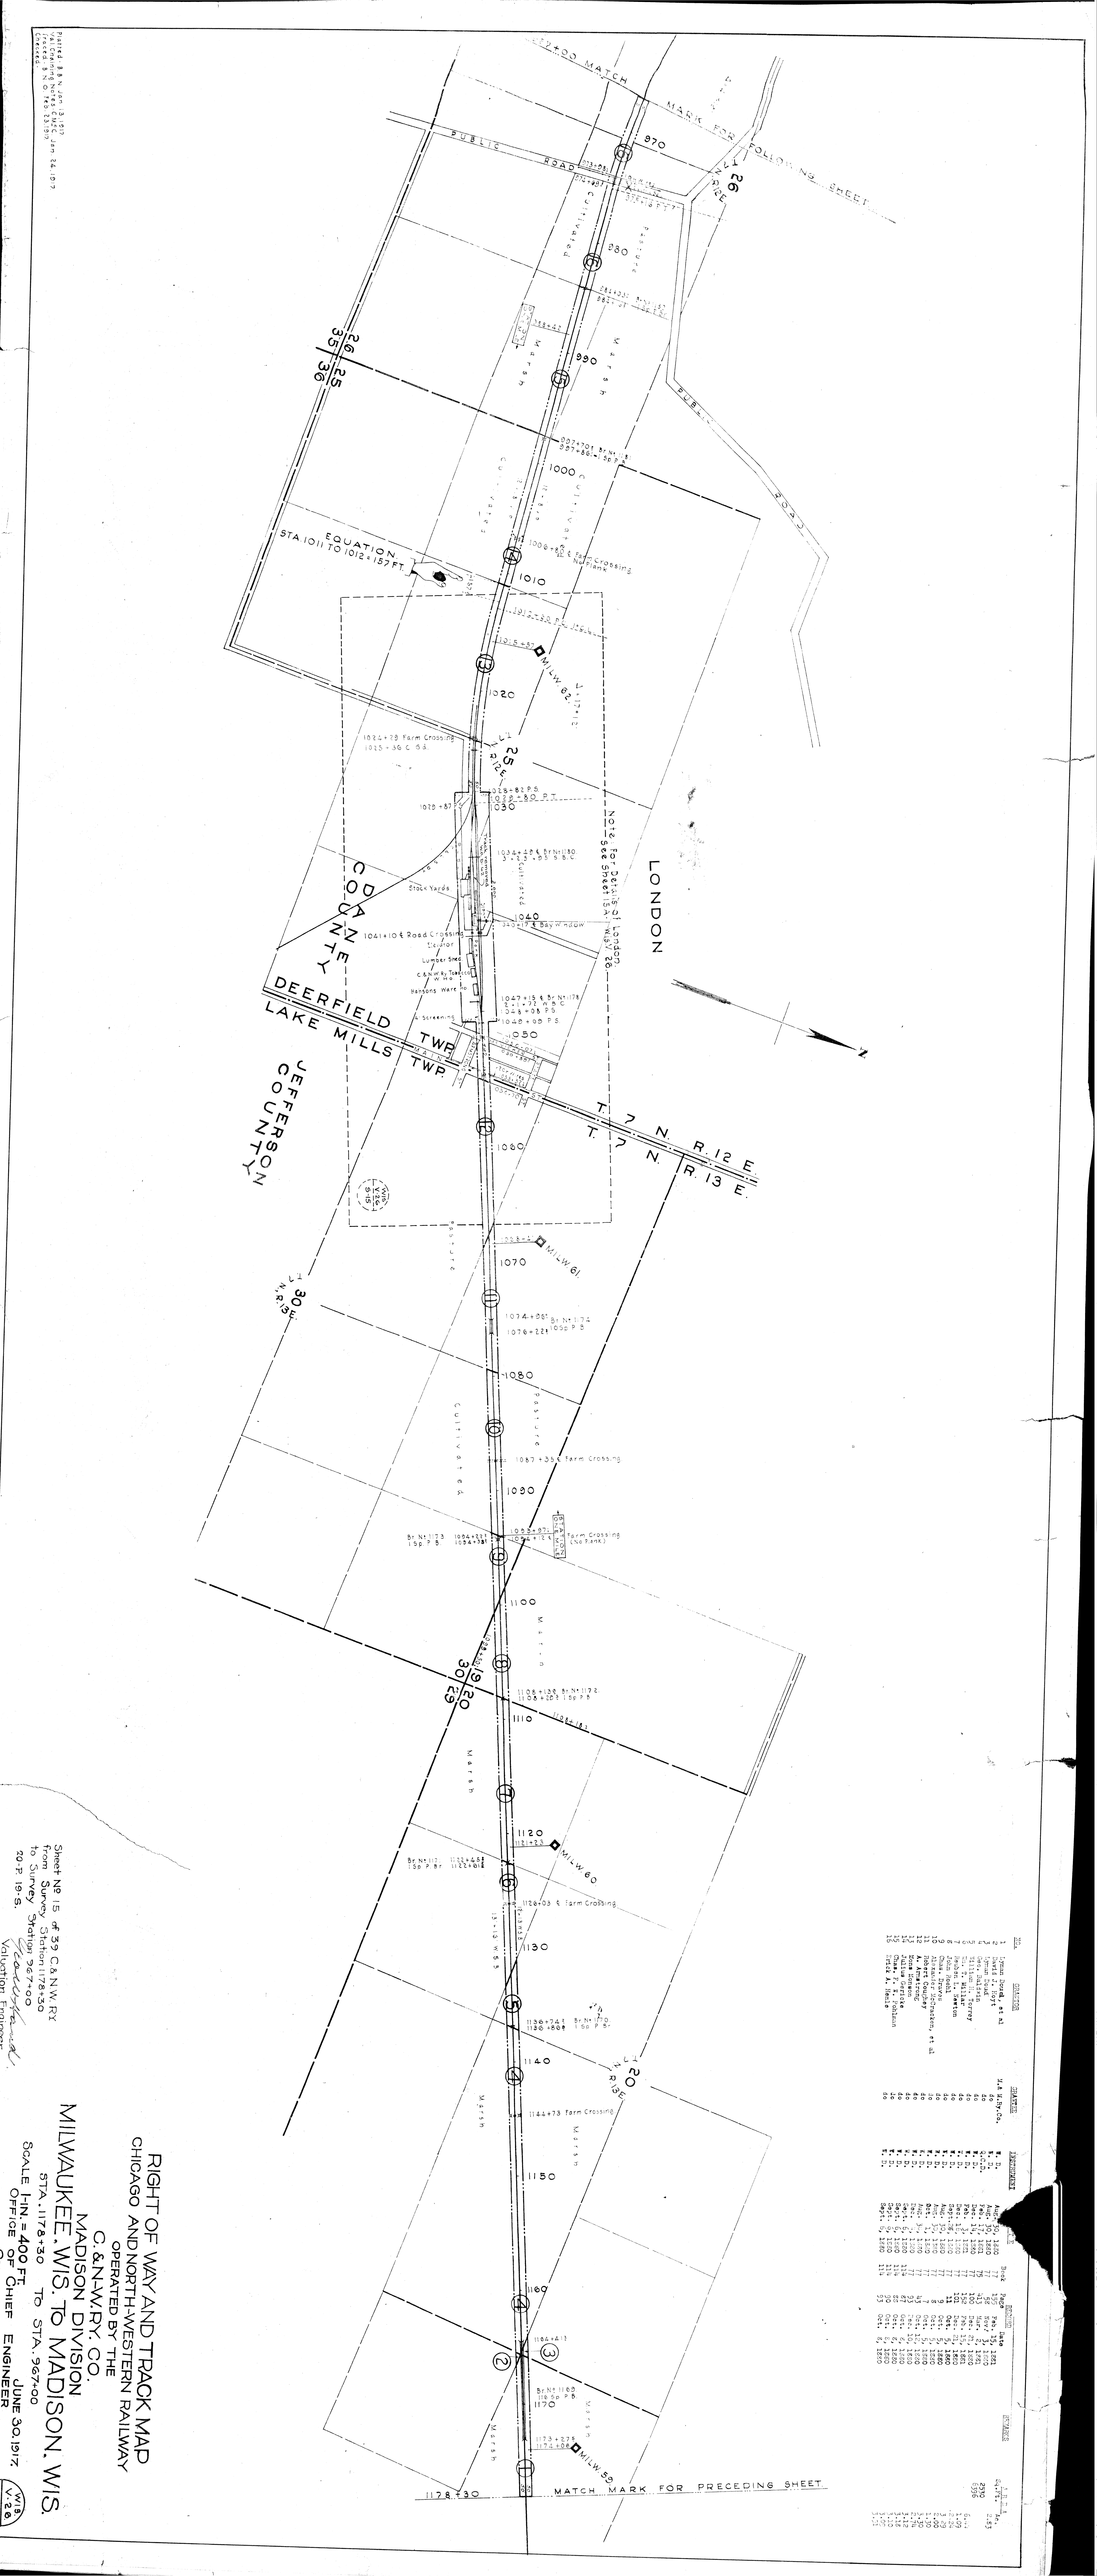

RIGHT OF WAY AND TRACK MAP
CHICAGO AND NORTH-WESTERN RAILWAY
OPERATED BY THE
C. & N. W. RY. CO.
MADISON DIVISION
MILWAUKEE, WIS. TO MADISON, WIS.

STA. 1178+30 TO STA. 967+00

SCALE 1 IN. = 400 FT.

OFFICE OF CHIEF ENGINEER

JUNE 30 1917

W18
V 28

Sheet No. 15 of 39 C. & N. W. RY.
from Survey Station 1178+30
to Survey Station 967+00
20-P 19-S.

Valuation Engineer