NO.	GRANTOR	GRANTEE	INSTRUMENT	DATE	RECORD Book	Page	Date	REMARKS	AREA Sq.Ft.	Ac.
1	F. Cunningham, et al	Chgo&Tomah RR.	Condemnation	Sept.25, 1860	Clerk,	Circuit Court				1.6
2	William Baker, et al	do	W. D.	July 3, 1860	35	416	July 6, 1860			3.0
3	Daniel Ilsmer	do	W. D.	July 3, 1860	35	554	Aug. 31, 1860			3.0
4	Daniel Ilsmer	do	W. D.	Aug. 27, 1860	35	543	Aug. 28, 1860			2.25
5	Joseph Drury	do	W. D.	July 5, 1860	35	407	July 10, 1860			0.33
6	Joseph Drury	do	W. D.	Aug. 27, 1860	35	542	Aug. 28, 1860			4.59
7	John K. Lemen	do	W. D.	July 3, 1860	35	435	July 6, 1860			0.16
8	John W. Lemen	M. & W. RR.	W. D.	Mar. 8, 1861	38	295	Mar. 9, 1861		151.20	
9	A. W. Worthy	Chgo&Tomah RR.	W. D.	Aug. 6, 1860	35	524	Aug. 7, 1860			3.13
10	John Fryer	do	W. D.	July 5, 1860	35	405	July 6, 1860			3.04
11	James D. Foltor	do	W. D.	July 6, 1860	35	459	July 6, 1860			3.12
12	Daniel Ilsmer	C.M.& N.W.Ry.	Easement	Aug. 9, 1861	36	395	Aug. 10, 1861		26000	

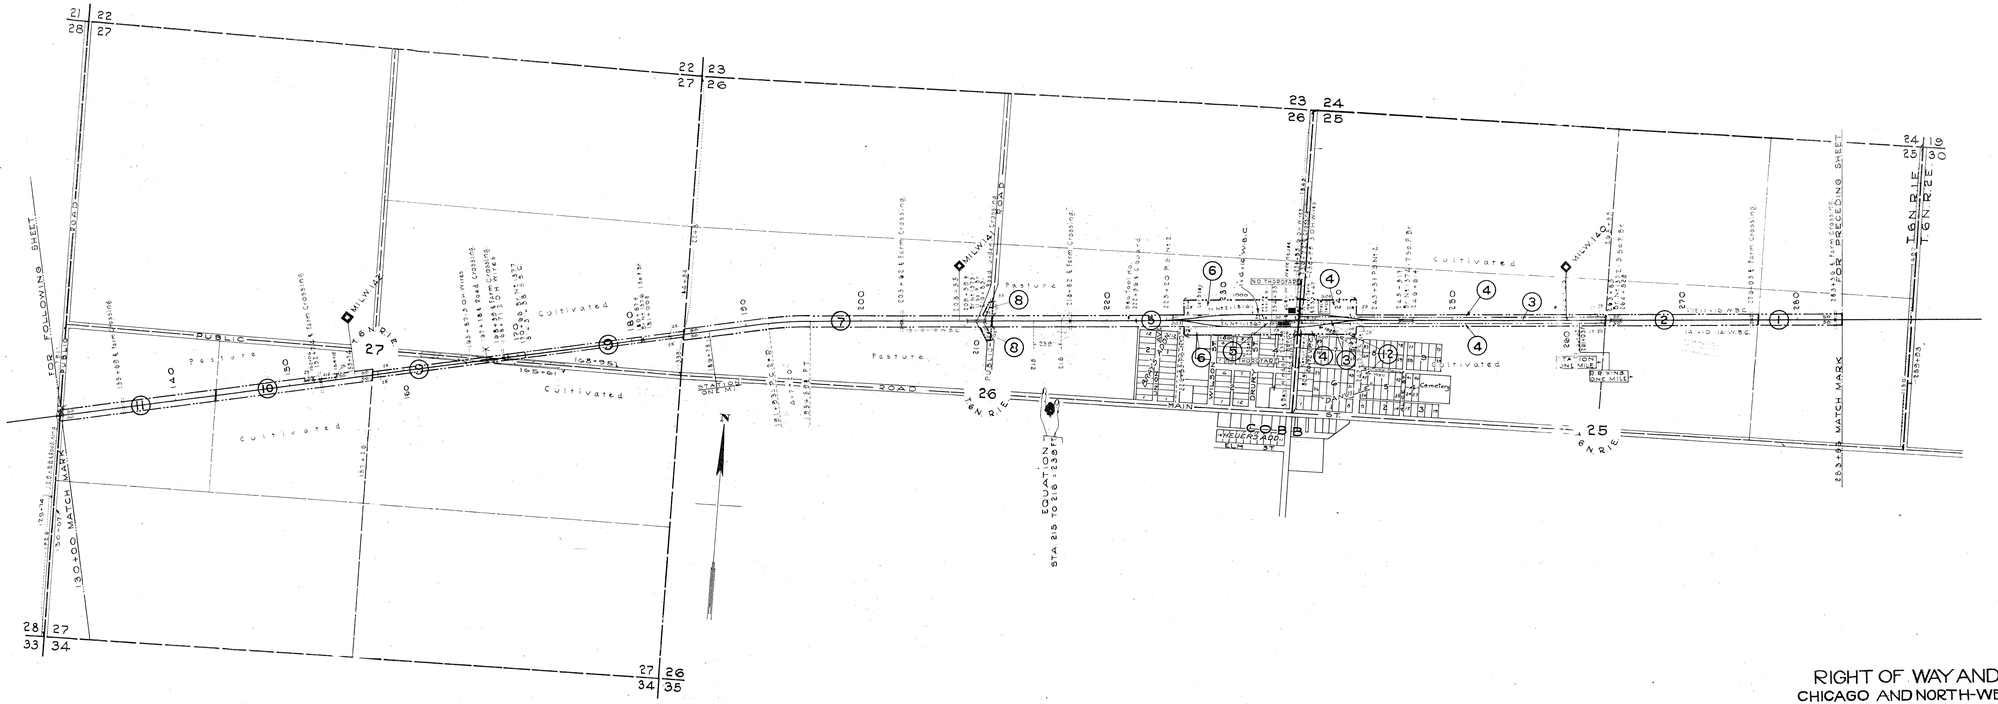

Sheet No. 15 of 16 Primary sheets
and 1 supplemental sheets
of C.&N.W.RY. from survey
station 263+96 to survey station 130+00.

Valuation Engineer.

RIGHT OF WAY AND TRACK MAP
CHICAGO AND NORTH-WESTERN RAILWAY
OPERATED BY THE
C. & N-W. RY. CO.
MADISON DIVISION
MADISON, WIS. To MONTFORT, WIS.

STA. 263+96 ~~To~~ STA. 130+00.

SCALE 1-IN. = 400 FT. JUNE 30, 1917.

OFFICE OF CHIEF ENGINEER
CHICAGO, ILL.

WIS V-27 15

Plat Sheet No. 15 of 16
Sheet No. 15 of 16
Checked B.S.H. 04.25.1918