


NO.	GRANTEE	INSTRUMENT	DATE	BOOK	PAGE	RECORDED	INDEXED
1	William W. Ollert	CH & NW RY. CO.	July 16, 1882	28	348	July 22, 1882	

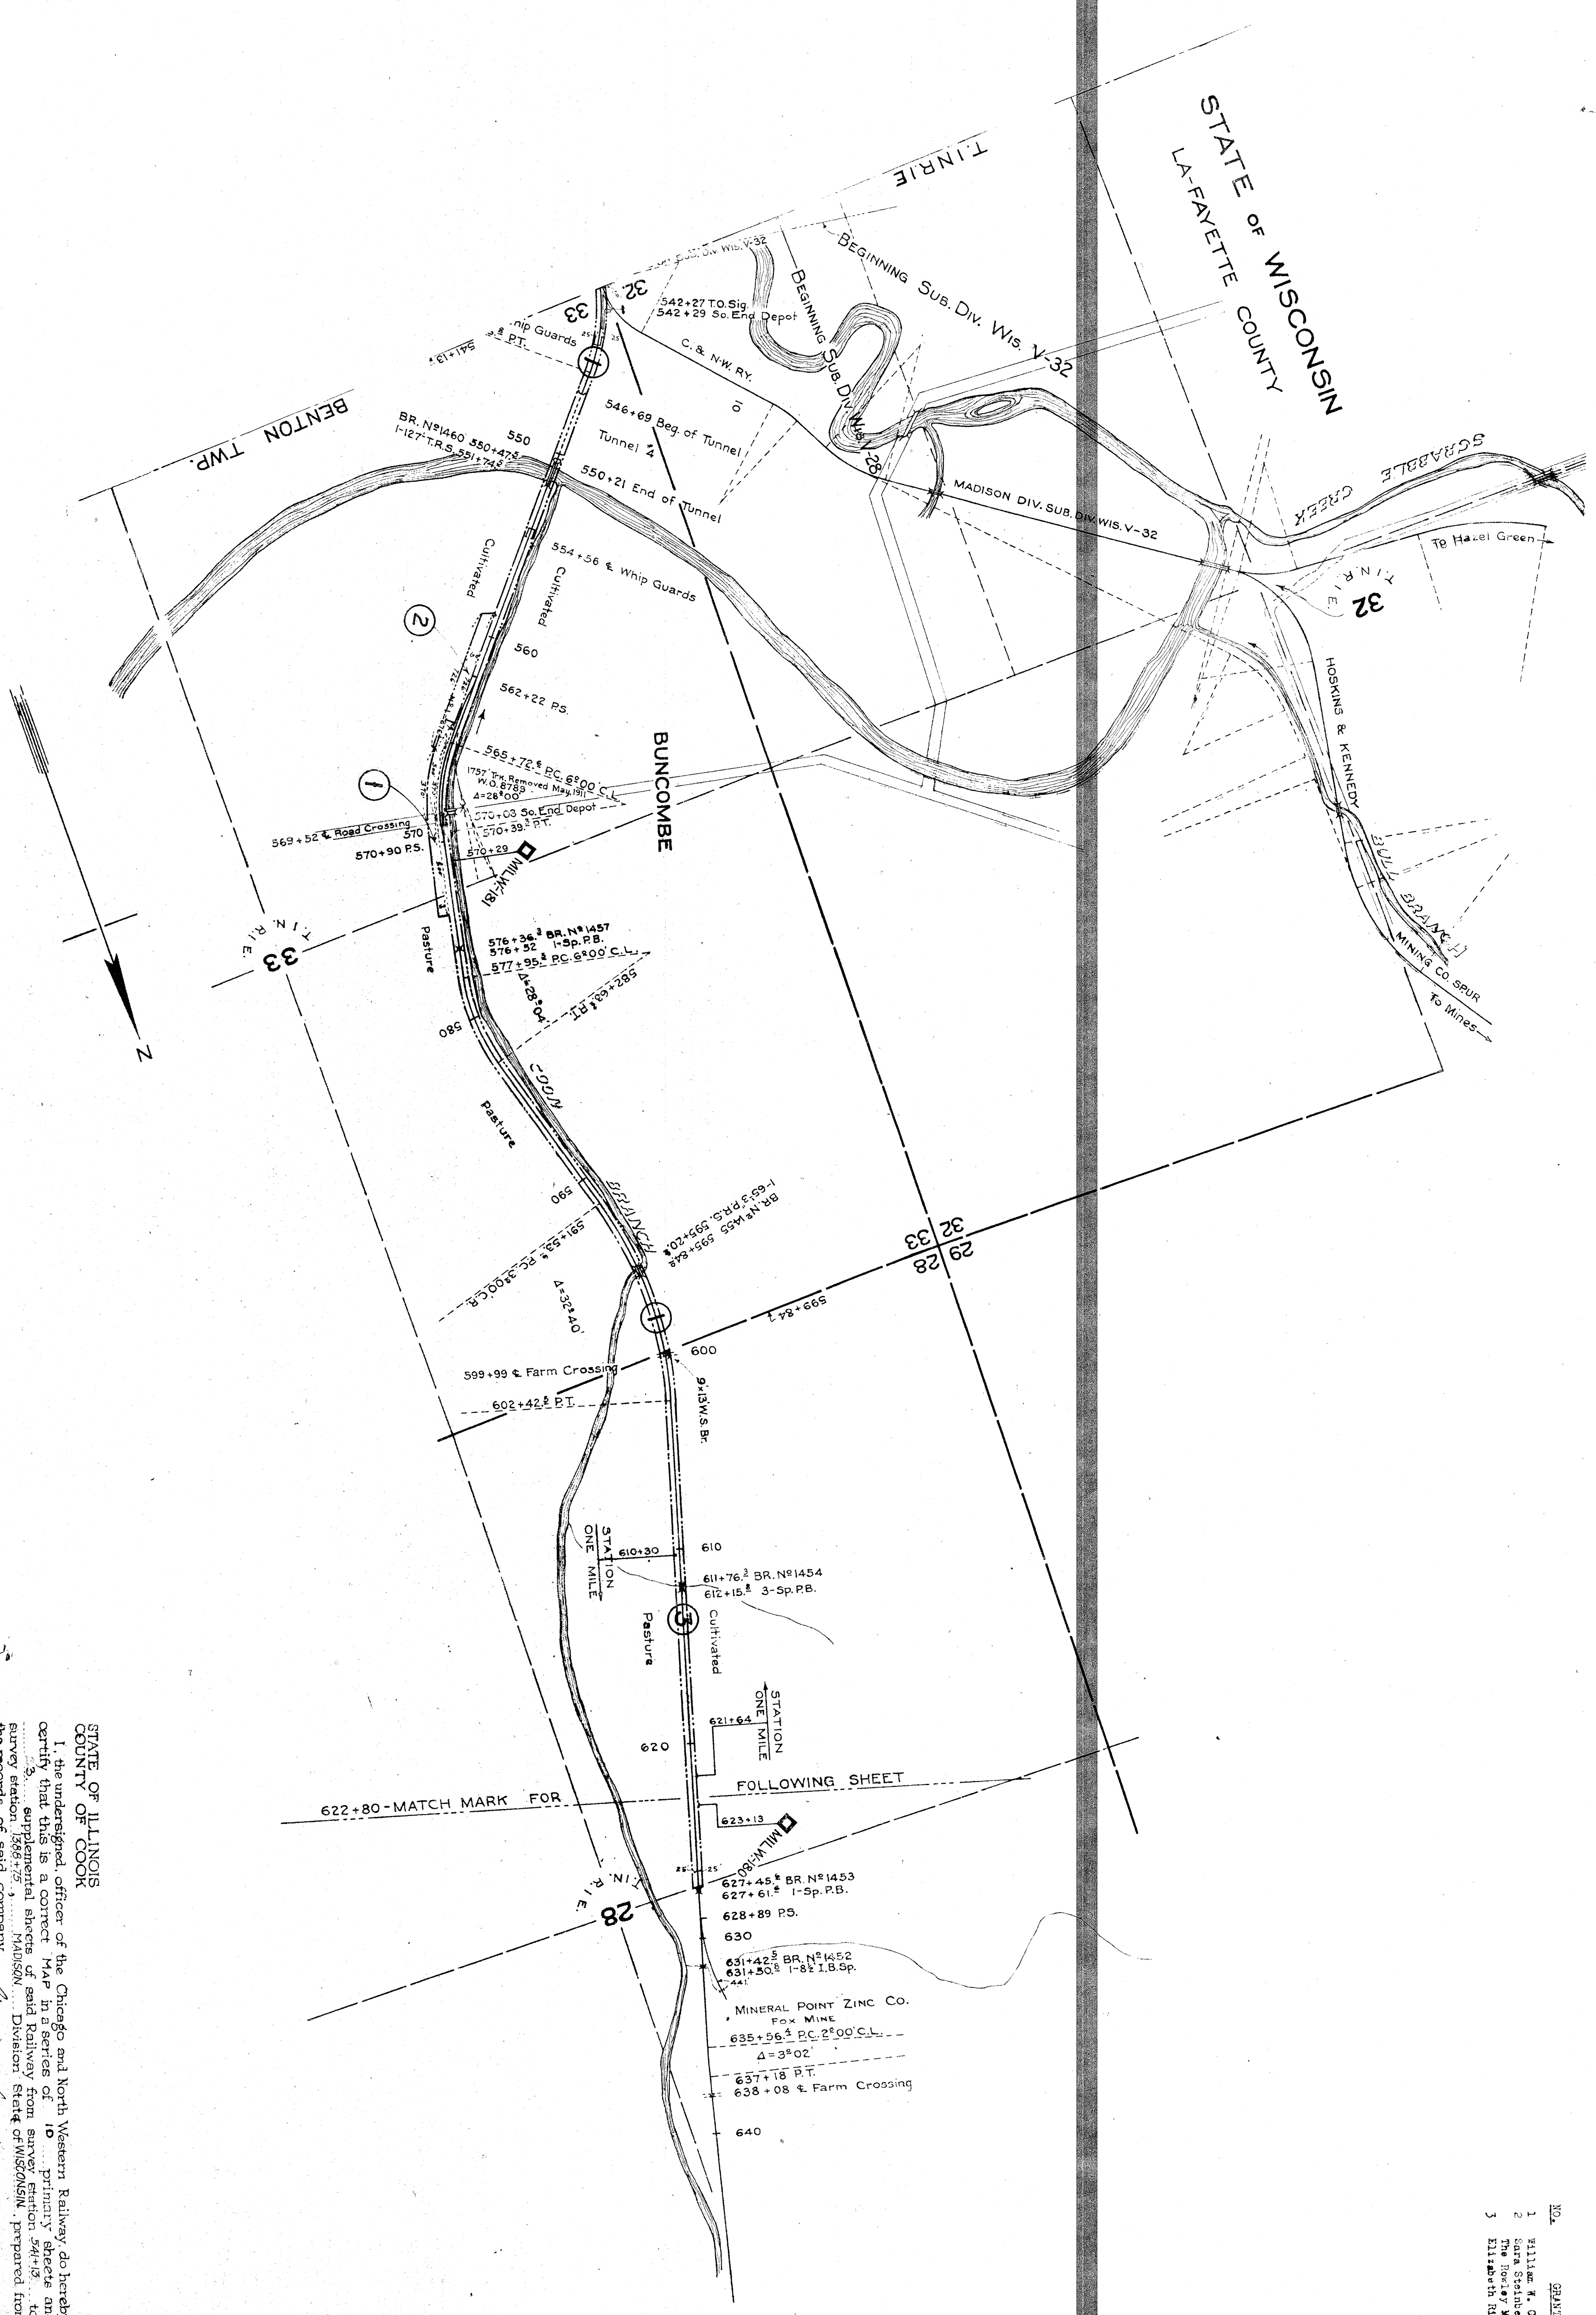

STATE OF ILLINOIS
COUNTY OF COOK

Correct
Valuation Engineer

Subscribed and sworn before me this 7th day of Jan., 1918.
Notary Public in and for the County of Cook, State of Illinois
My commission expires April, 27th, 1921.

RIGHT OF WAY AND TRACK MAP
CHICAGO AND NORTH-WESTERN RAILWAY
OPERATED BY THE
C. & N-W. RY. CO.
MADISON DIVISION
ILL-WIS. STATE LINE - BUNCOMBE, WIS. TO MONTFORT, WIS.
STA. 541+13 TO STA. 622+80
SCALE 1-IN = 400 FT.
JUNE 30, 1917.
OFFICE OF CHIEF ENGINEER
CHICAGO, ILL.

