


NO.	SUBJECT	DATE	RECORD	DATE	RECORD	DATE	RECORD
1	George Hartfield	July 8, 1873	101	1873	101	1873	101
2	Robt. de Bide	Aug. 15, 1881	95	1881	95	1881	95
3	Thomas Robinson	Aug. 15, 1881	95	1881	95	1881	95
4	Thomas Robinson	Aug. 15, 1881	95	1881	95	1881	95
5	Sam Deed as Parcel #1	Jan. 30, 1884	101	1884	101	1884	101

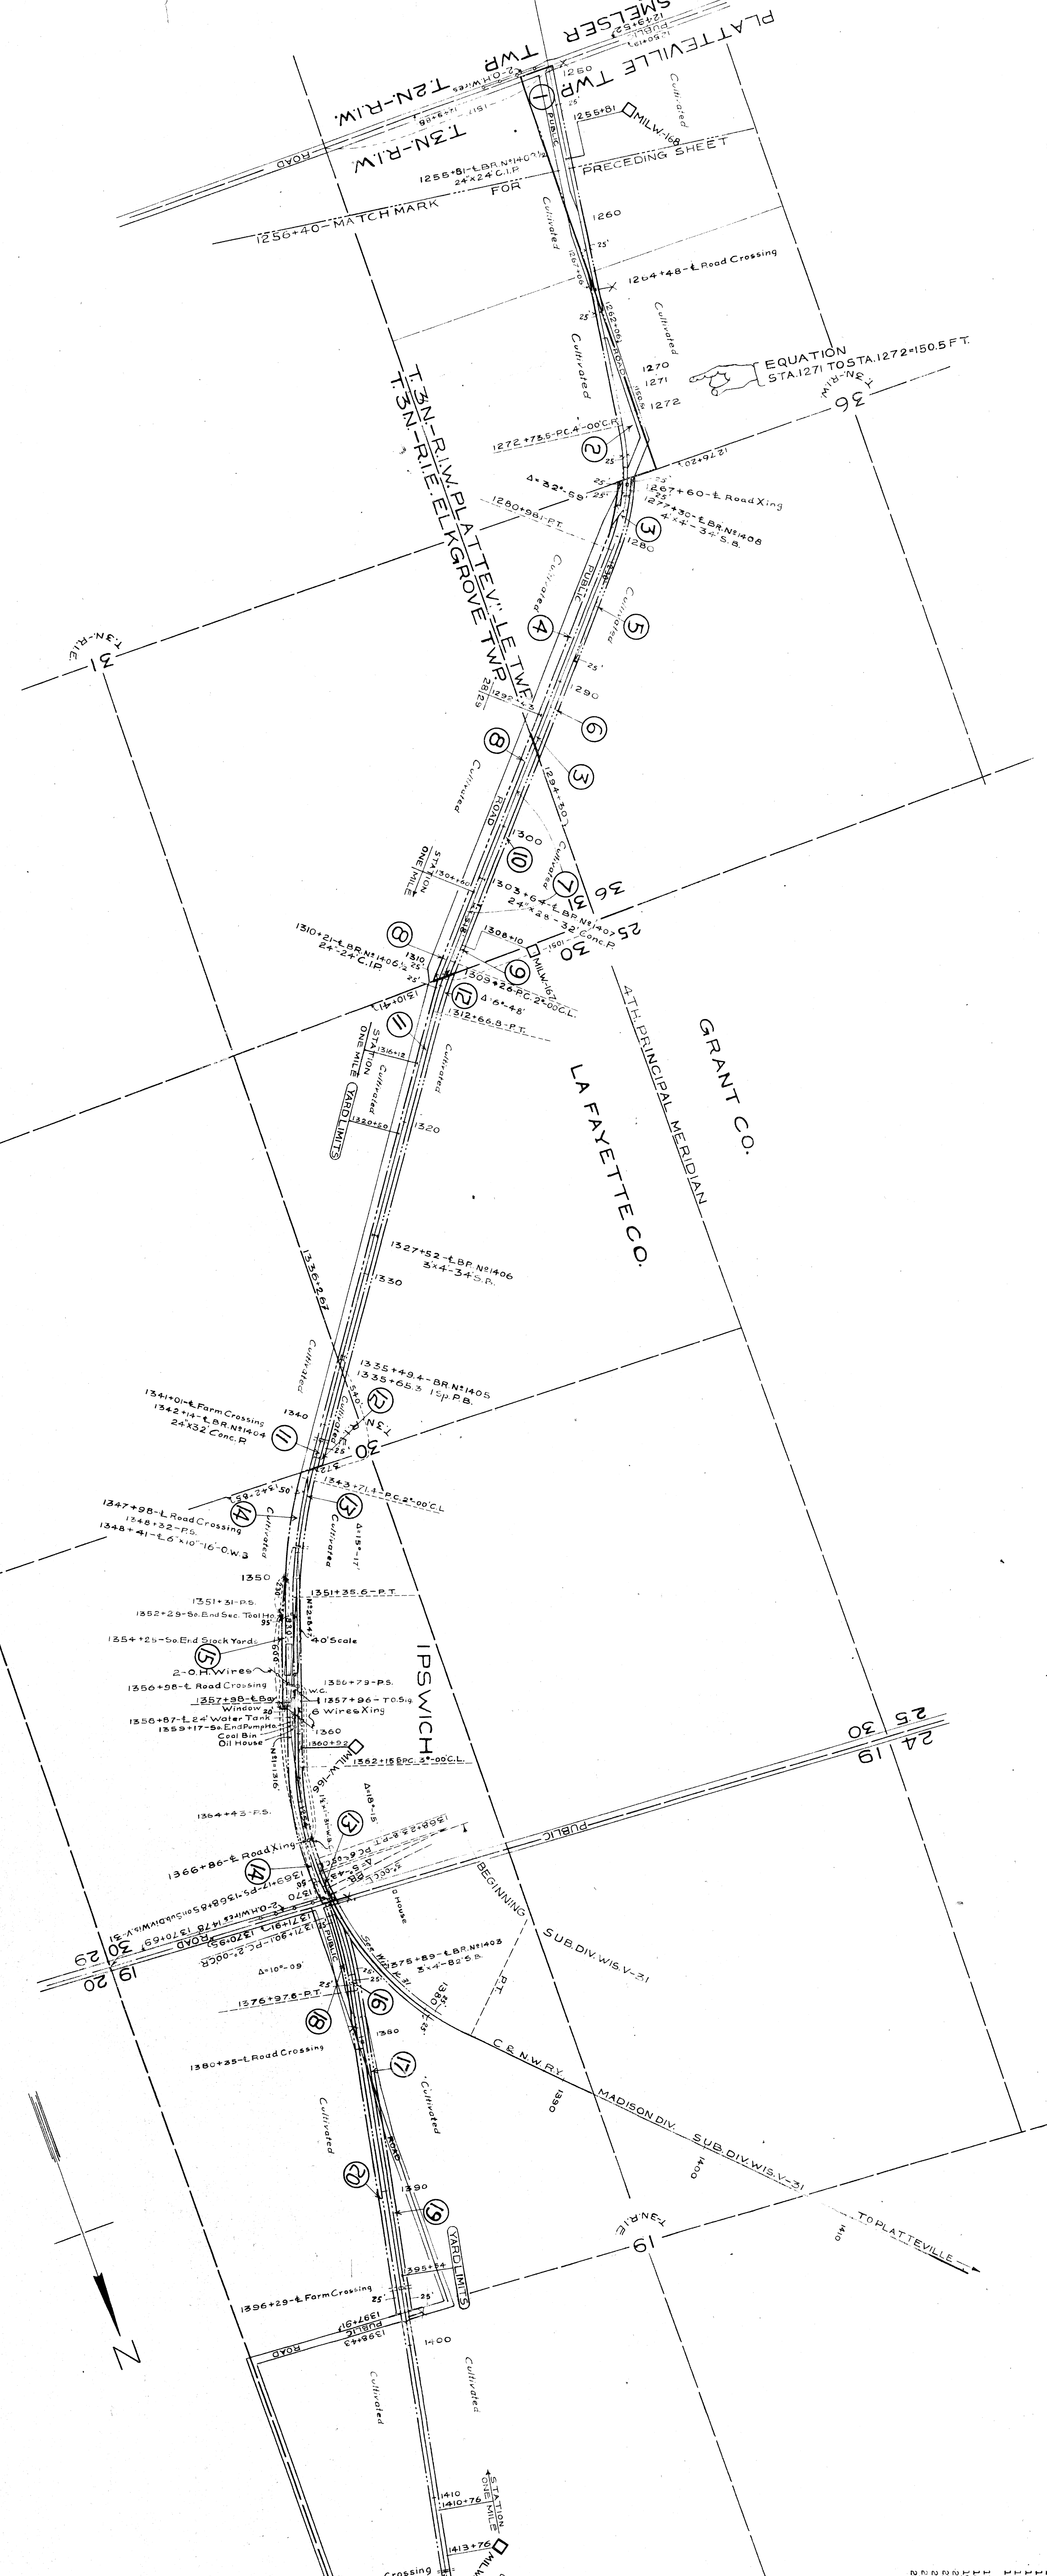

RIGHT OF WAY AND TRACK MAP
CHICAGO AND NORTH-WESTERN RAILWAY
OPERATED BY THE
C. & N.-W. RY. CO.
MADISON DIVISION
ILL.-WIS. STATE LINE
BUNCOMBE, WIS. MONTFORT, WIS.
STA. 1256+40 TO STA. 1467+60
JUNE 30, 1917.
OFFICE OF CHIEF ENGINEER
CHICAGO, ILL.