


PLATTED - B. & N. - DEC. 1916
TRAINING NOTES - F.V.C. - DEC. 29, 1916
TRACED - C.T.I. - JAN. 16, 1917
CHECKED - B.S.N. - JAN. 15, 1917

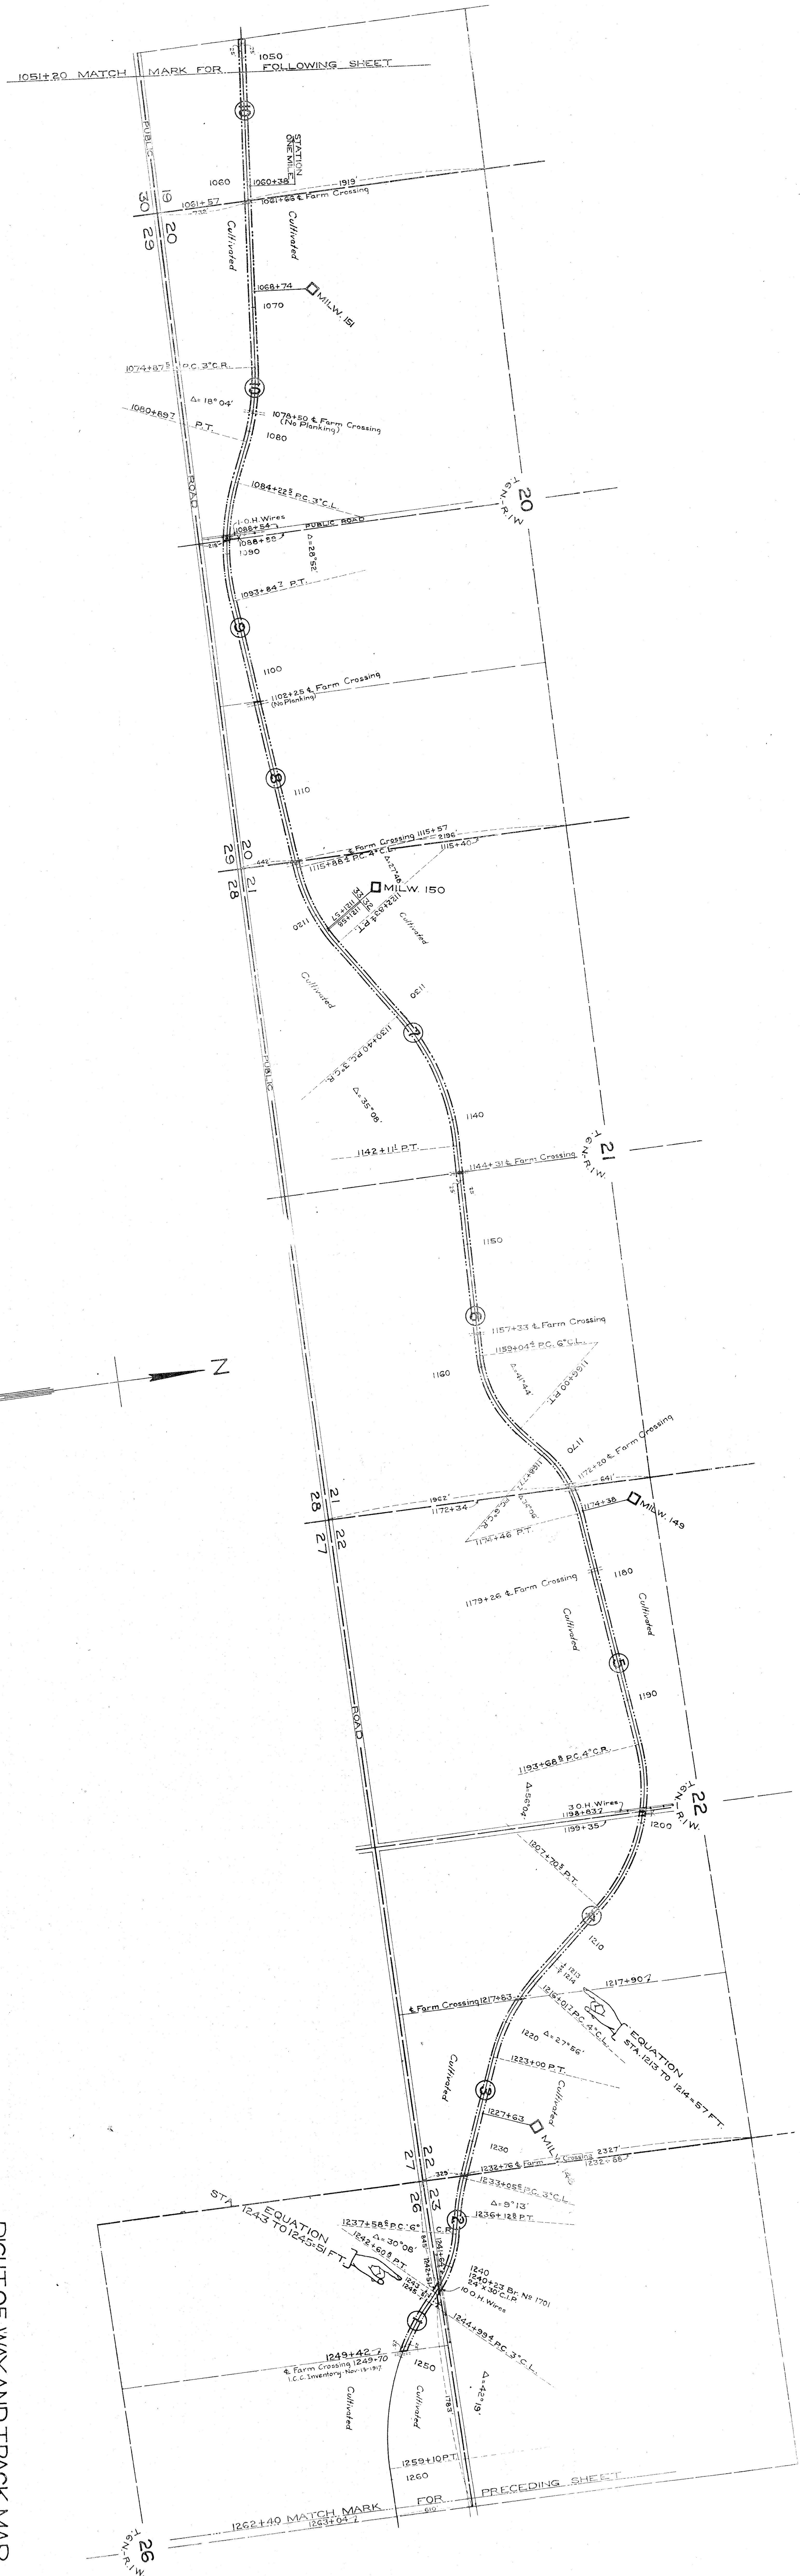

NO.	SECTION	DATE	INSTRUMENT	D.A.T.	BOOK	PAGE	DATE

RIGHT OF WAY AND TRACK MAP
CHICAGO AND NORTH-WESTERN RAILWAY
OPERATED BY THE
C. & N. W. RY. CO.

MADISON DIVISION
MONTFORT, WIS. TO FENNIMORE, WIS.
STA. 1051+20 TO STA. 1262+40
SCALE 1"=400 FT.
JUNE 30, 1917.
OFFICE OF CHIEF ENGINEER
CHICAGO, ILL.

Sheets No. 2, of 4 Primary sheets
and 2 supplemental sheets
of C. & N. W. RY. from survey
station 1051+20 to survey station 1262+40.