


PLATTED - B.M.V. - DEC. 1916
CHANGING NOTES - P.W.C. - DEC. 30, 1916
TRACED - O.T.I. - JAN. 12, 1917
CHECKED - B.M.V. - JAN. 16, 1917

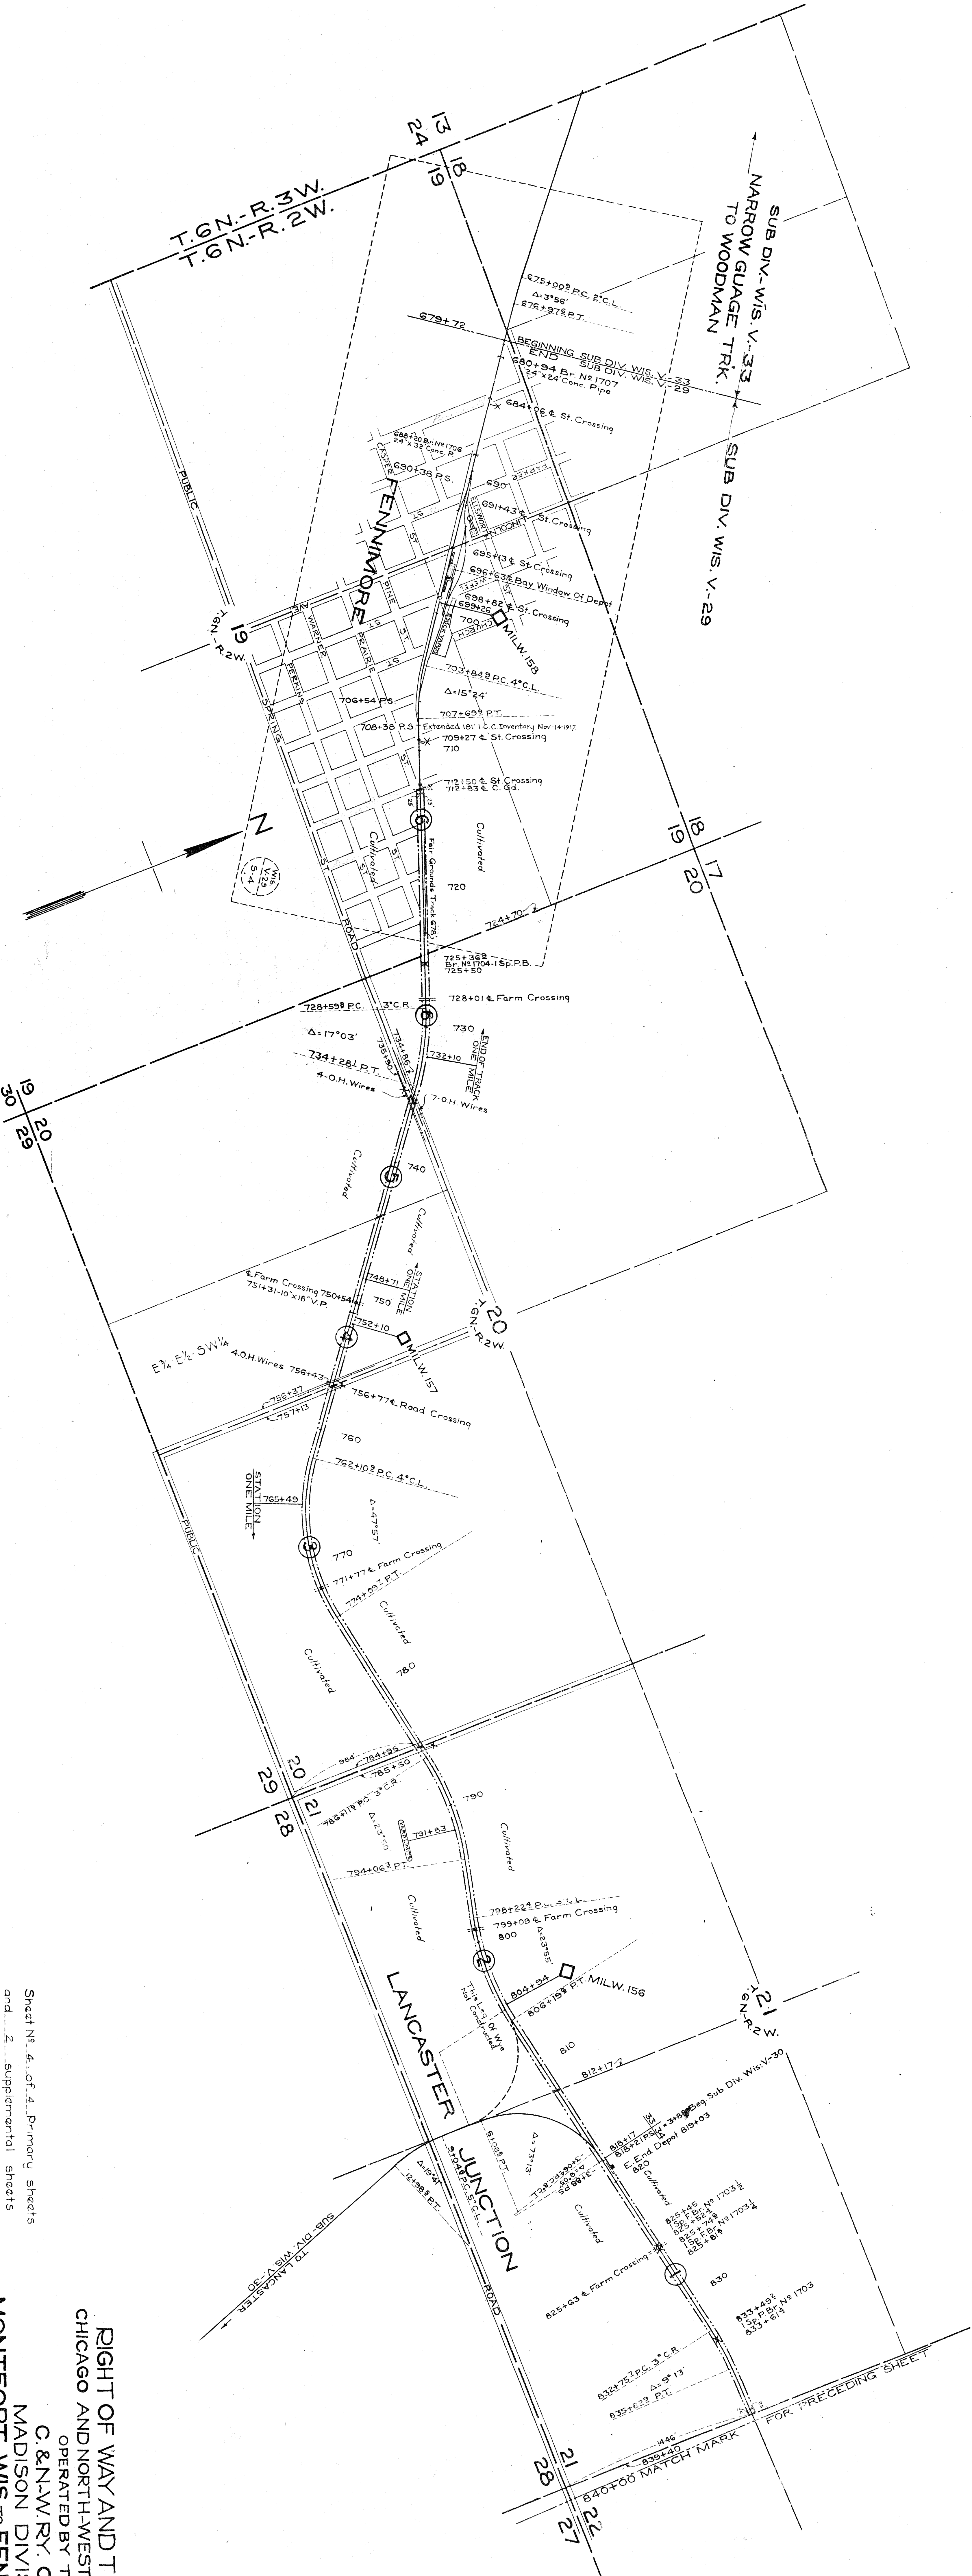


RIGHT OF WAY AND TRACK MAP
CHICAGO AND NORTH-WESTERN RAILWAY
OPERATED BY THE
C. & N. W. RY. CO.
MADISON DIVISION
MONTFORT, WIS. TO FENNIMORE, WIS.
STA. 679+72 TO STA. 840+00
SCALE 1"=400 FT.
JUNE 30, 1917
OFFICE OF CHIEF ENGINEER
CHICAGO, ILL.